0376_317

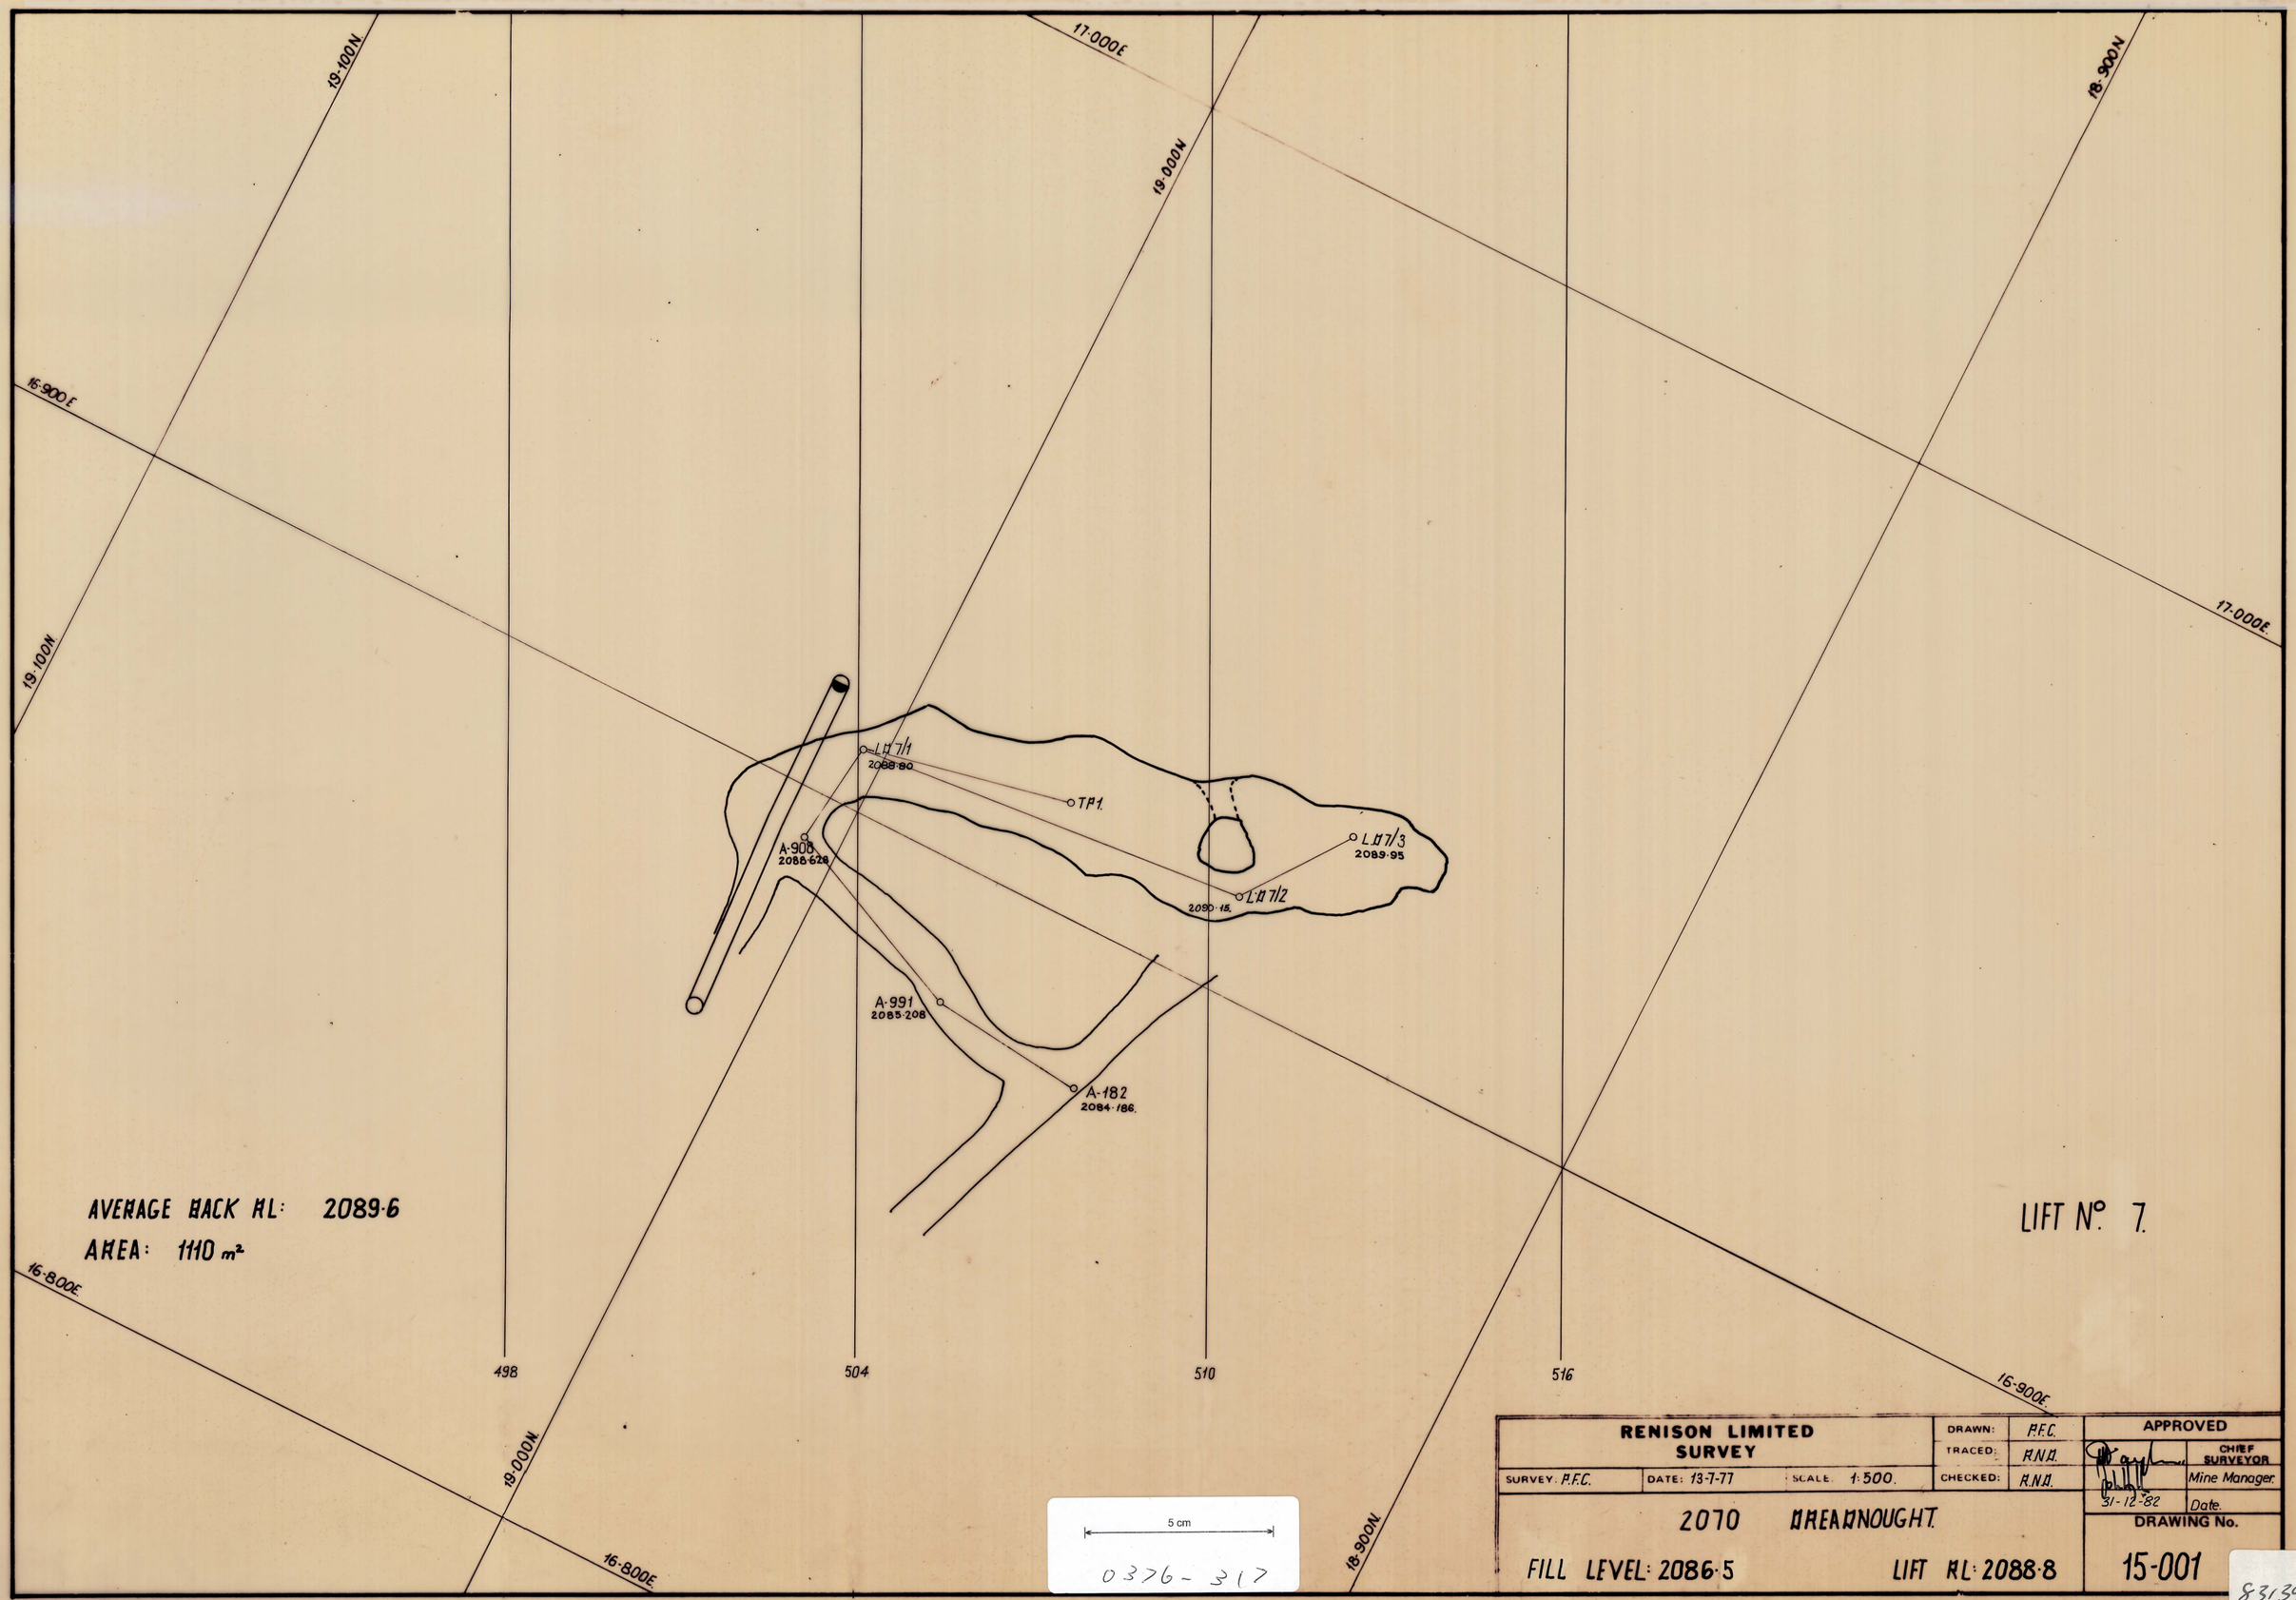

RENISON LIMITED SURVEY			DRAWN: P.F.C.	APPROVED
			TRACED: R.N.A.	CHIEF SURVEYOR
SURVEY: P.F.C.	DATE: 13-7-77	SCALE: 1:500.	CHECKED: R.N.A.	Mine Manager.
				31-12-82 Date.
2070 DREADNOUGHT.				DRAWING No.
FILL LEVEL: 2086·5		LIFT RL: 2088·8		15-001

83139