0376-345

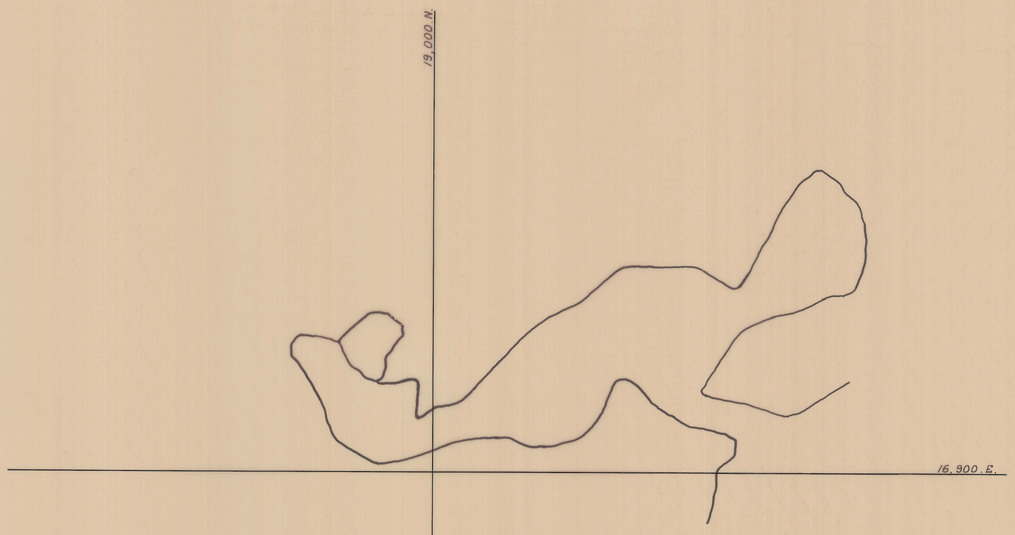

5 cm

0376-345

DATE	MANAGER	SURVEYOR	RENISON LIMITED SURVEY	DRAWING Nº
31-12-82			DRAWN : P.W.K. | DATE : 22-3-73 | SCALE : 1:500	17:001
			LOWER DREADNOUGHT STOPE LEVEL 2080	

83137