0376-360

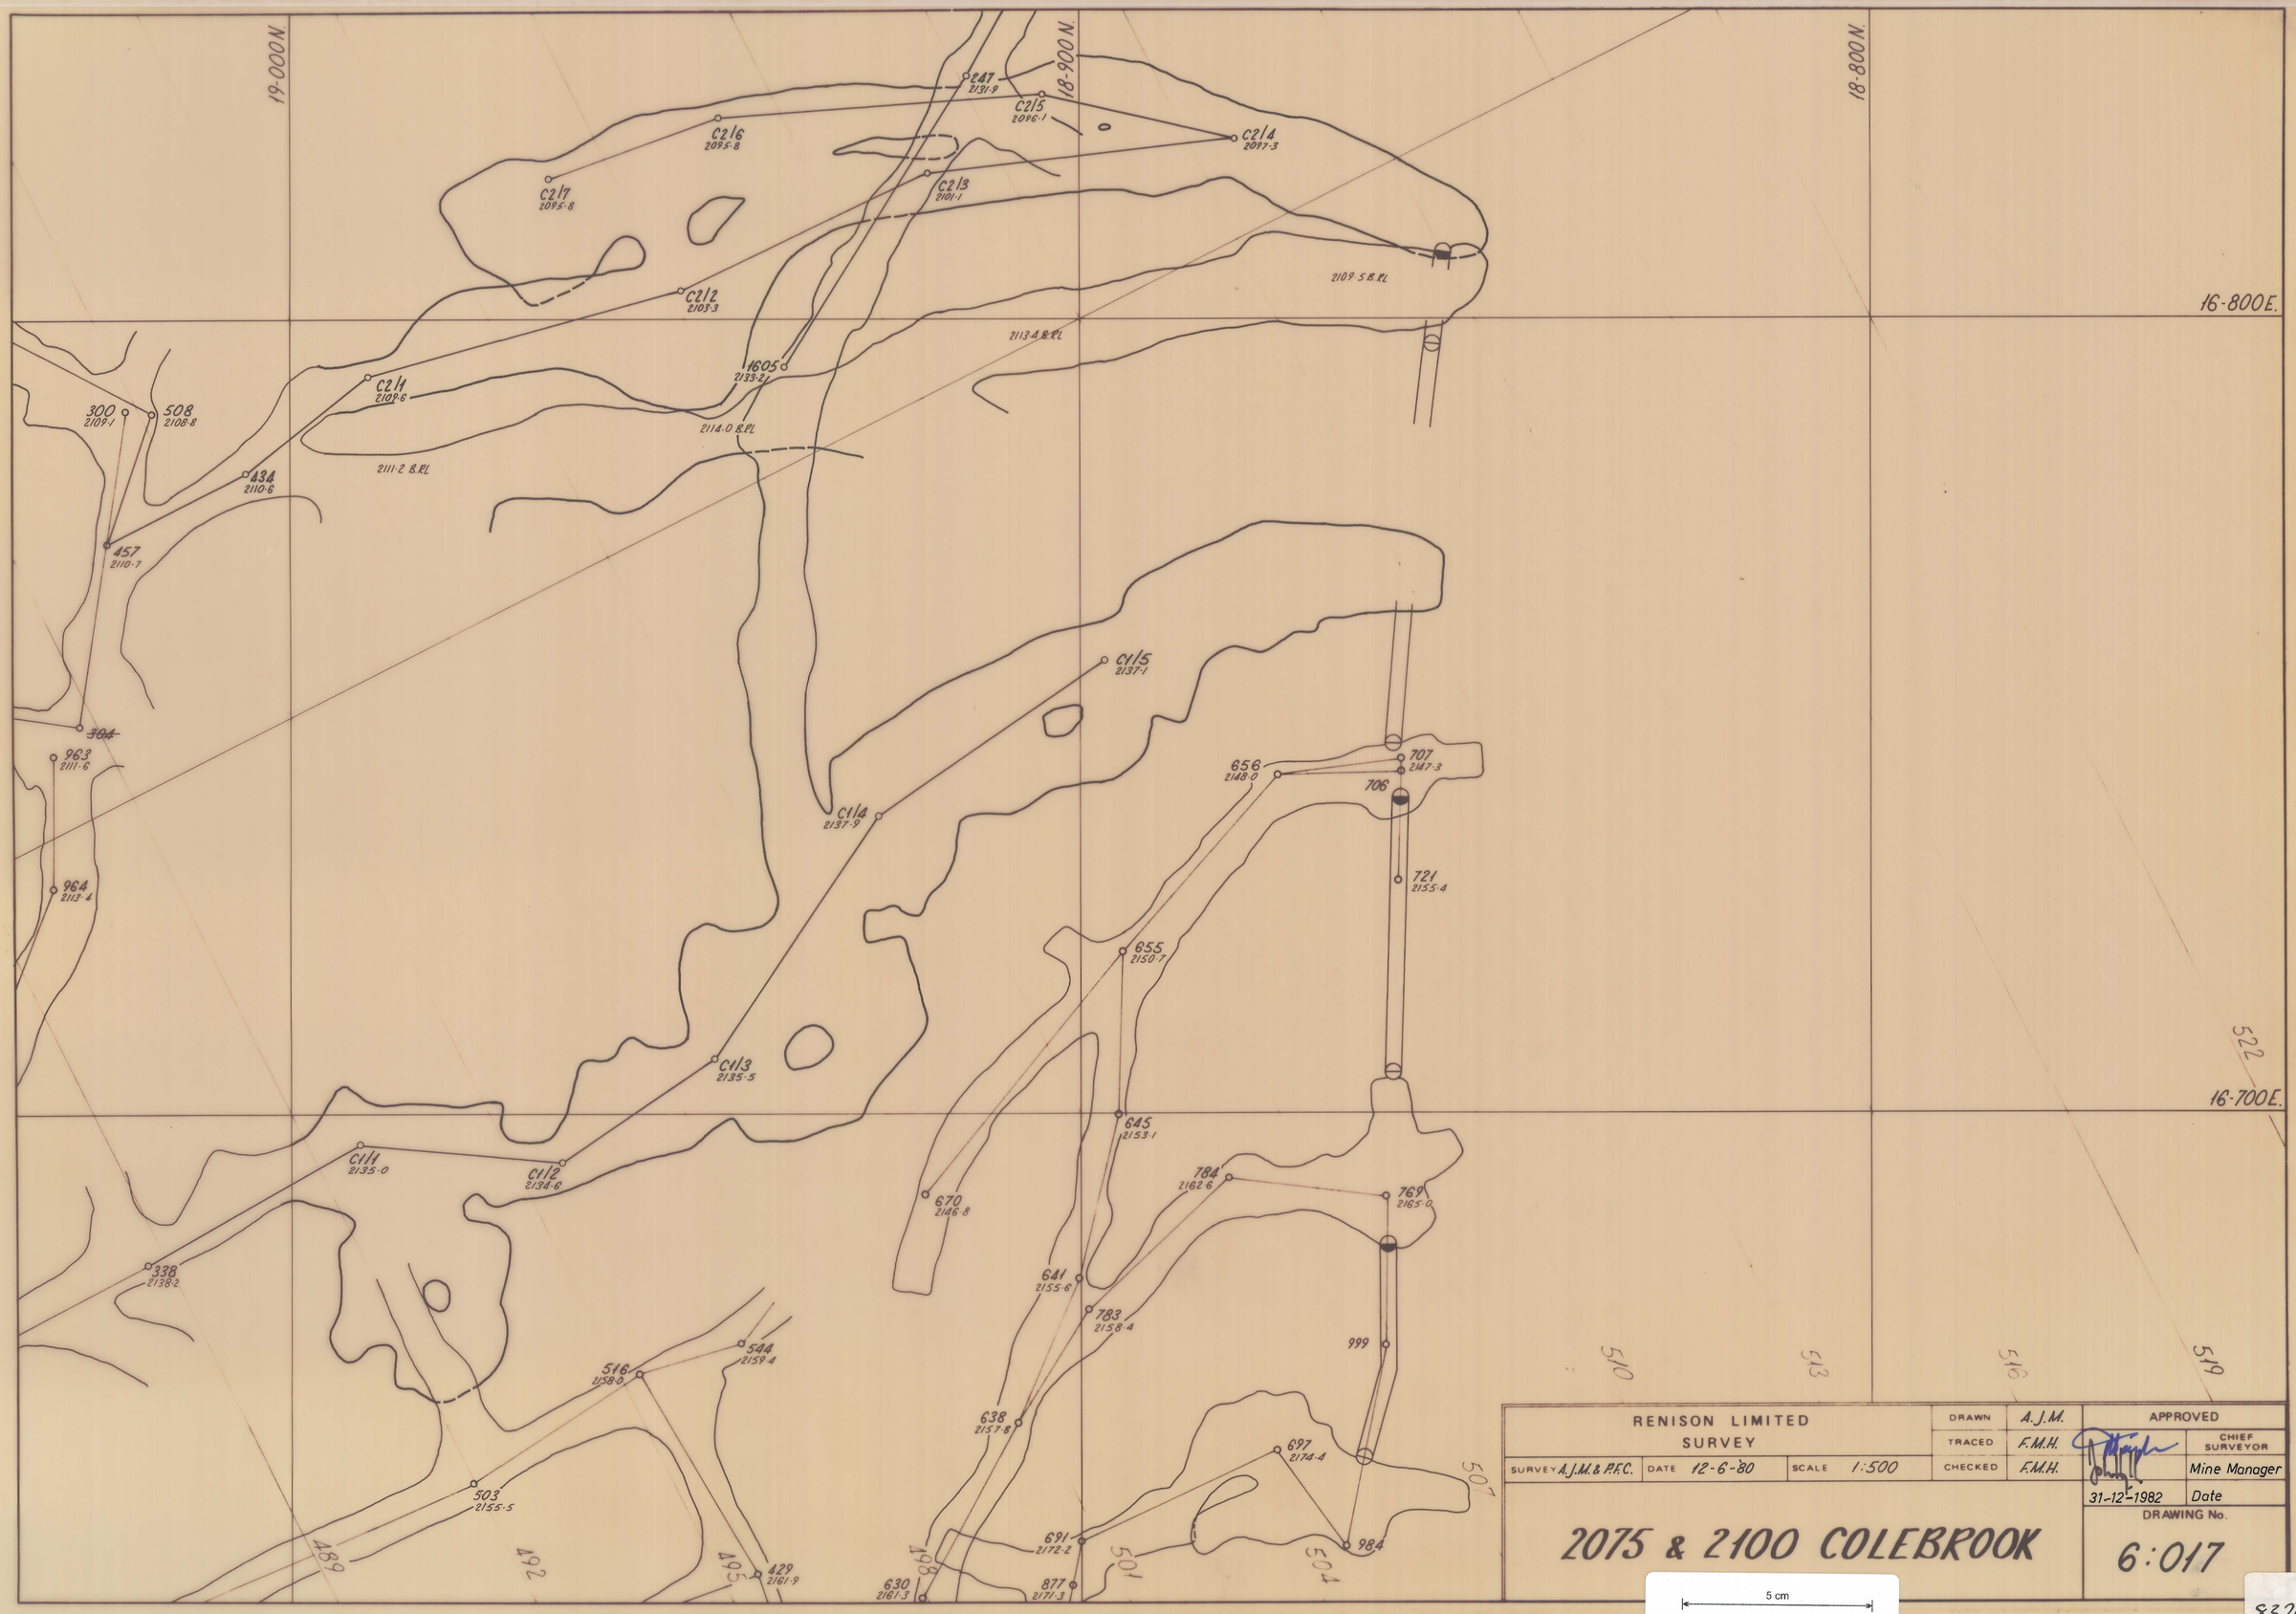

RENISON LIMITED SURVEY				DRAWN	A.J.M.	APPROVED	
				TRACED	F.M.H.		CHIEF SURVEYOR
SURVEY A.J.M. & P.F.C.	DATE 12-6-'80	SCALE 1:500		CHECKED	F.M.H.		Mine Manager
						31-12-1982	Date
2075 & 2100 COLEBROOK						DRAWING No. 6:017	

5 cm

0376-360

83210