0376 - 361

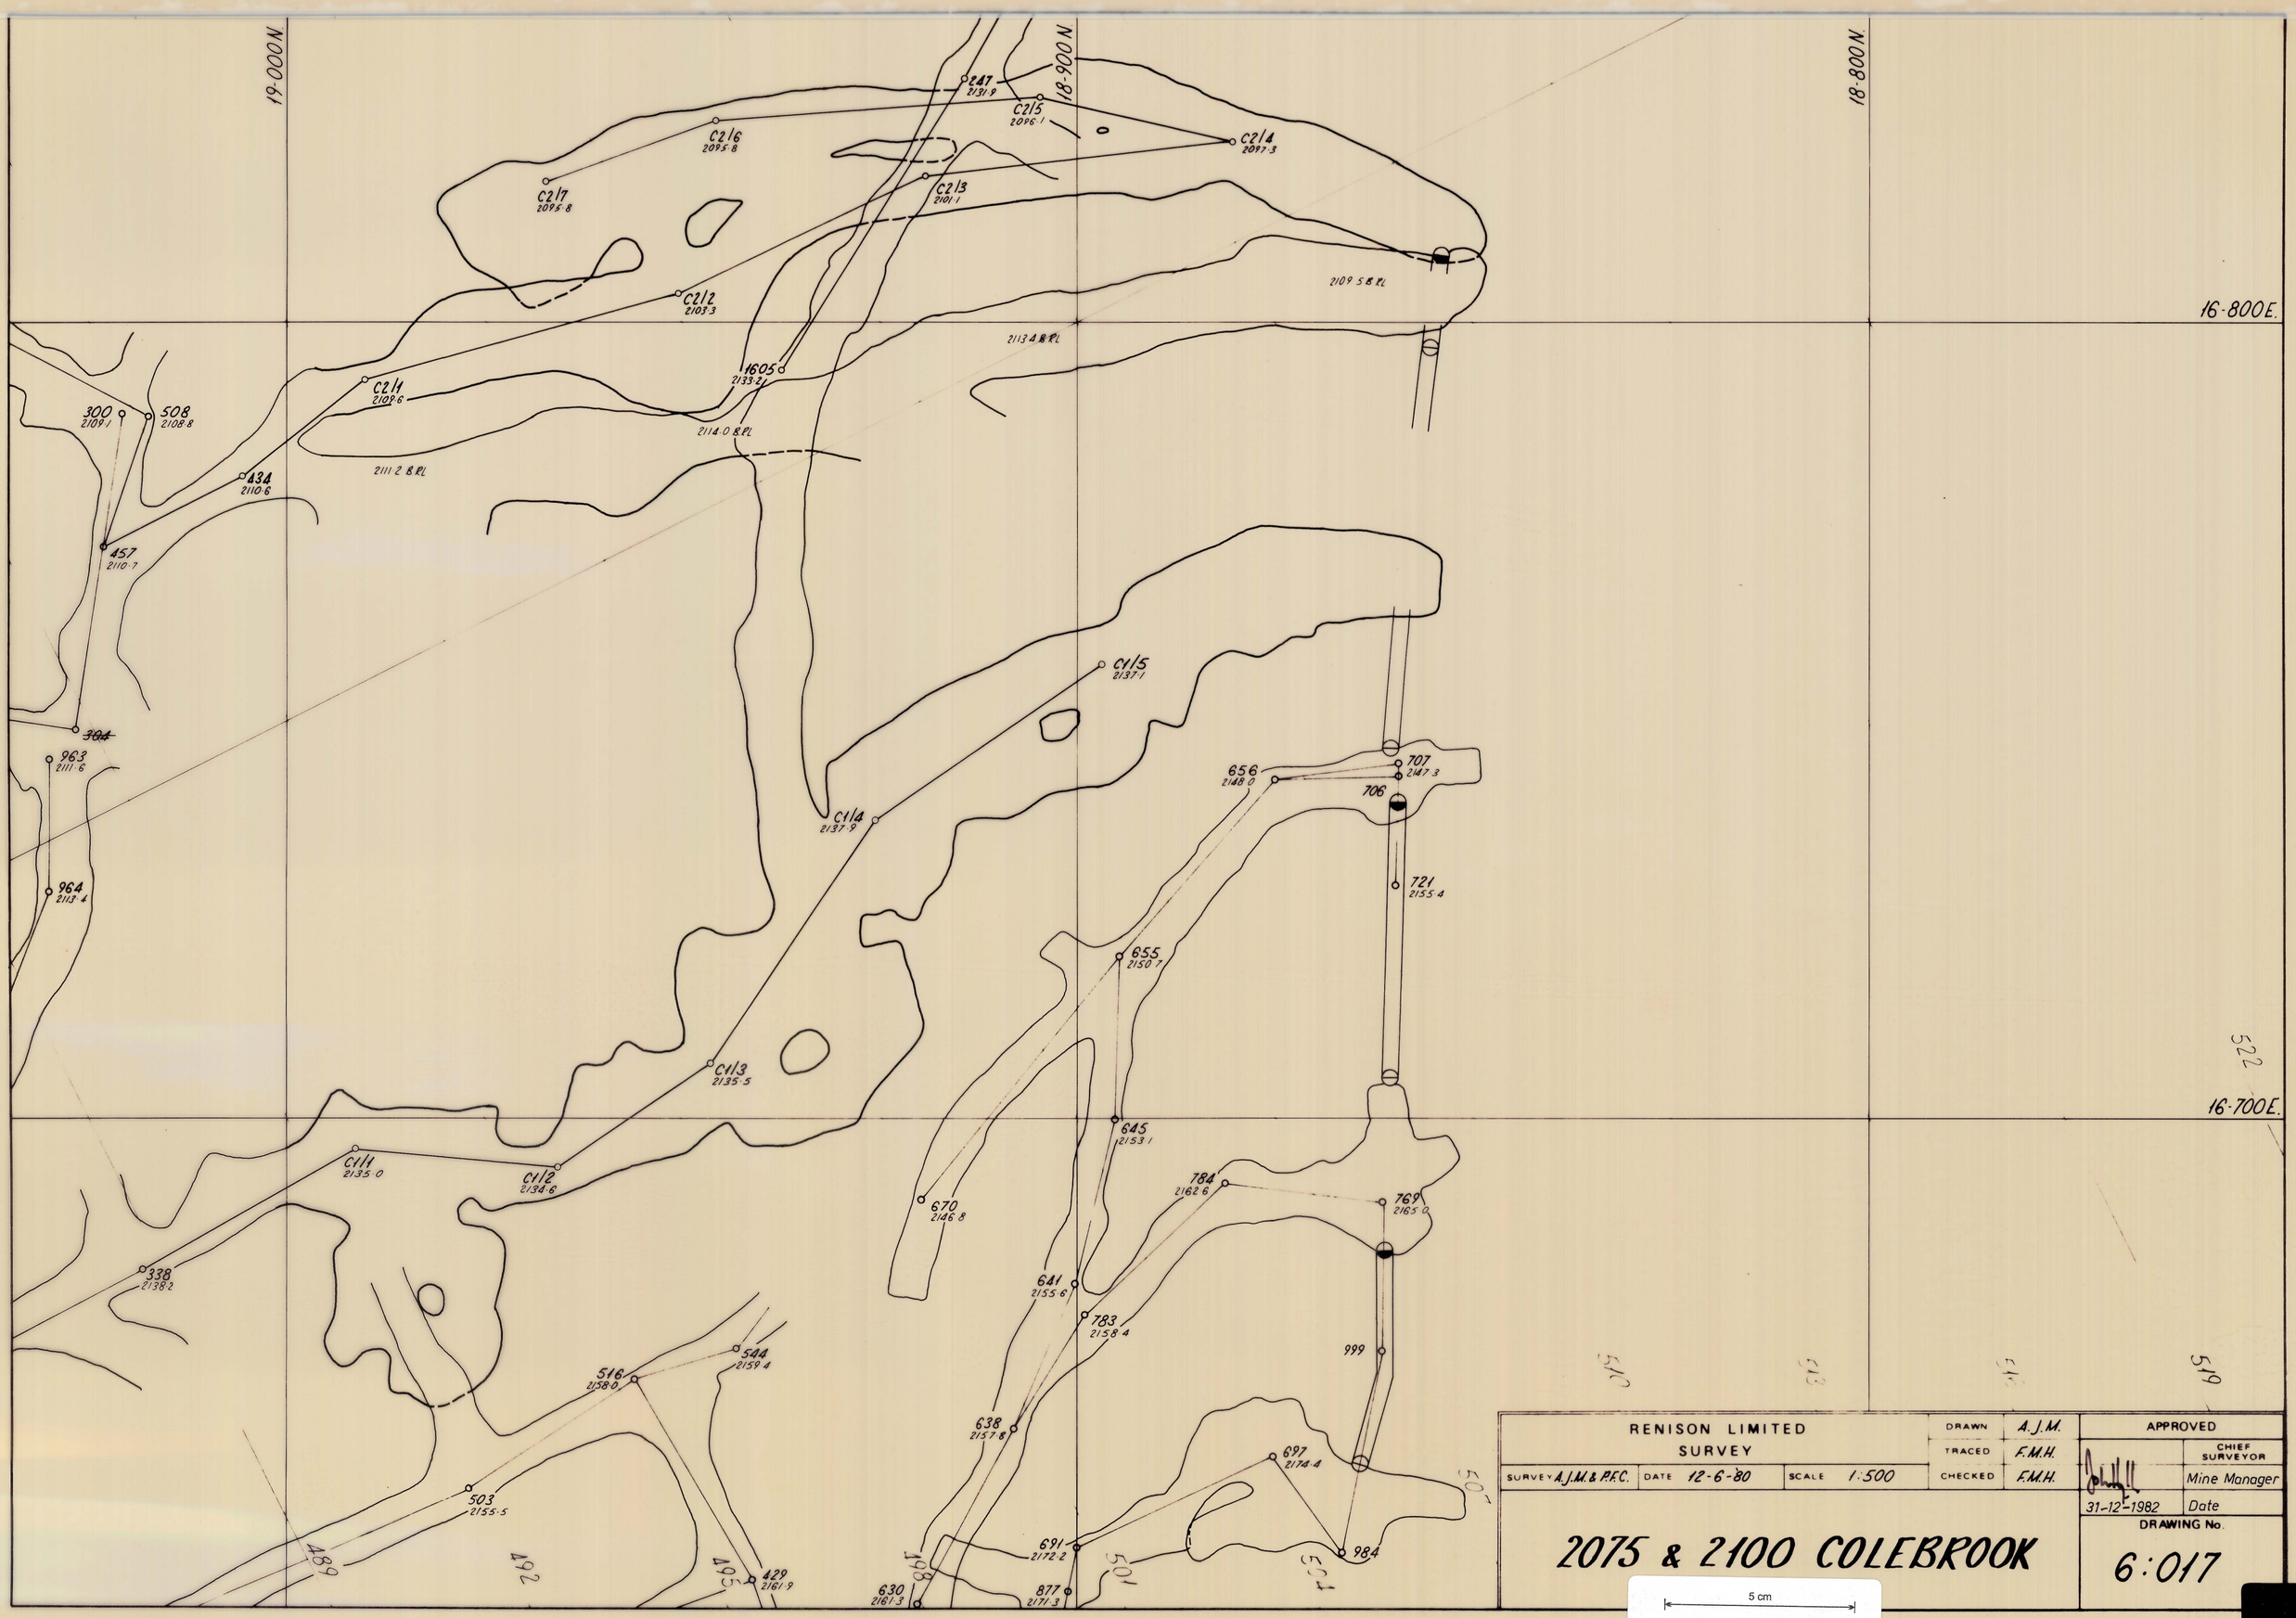

RENISON LIMITED SURVEY			DRAWN	A.J.M.	APPROVED
			TRACED	F.M.H.	CHIEF SURVEYOR
SURVEY A.J.M. & P.F.C.	DATE 12-6-80	SCALE 1:500	CHECKED	F.M.H.	Mine Manager
				31-12-1982	Date
2075 & 2100 COLEBROOK				DRAWING No. 6:017	

5 cm

0376 - 361