0376 – 370

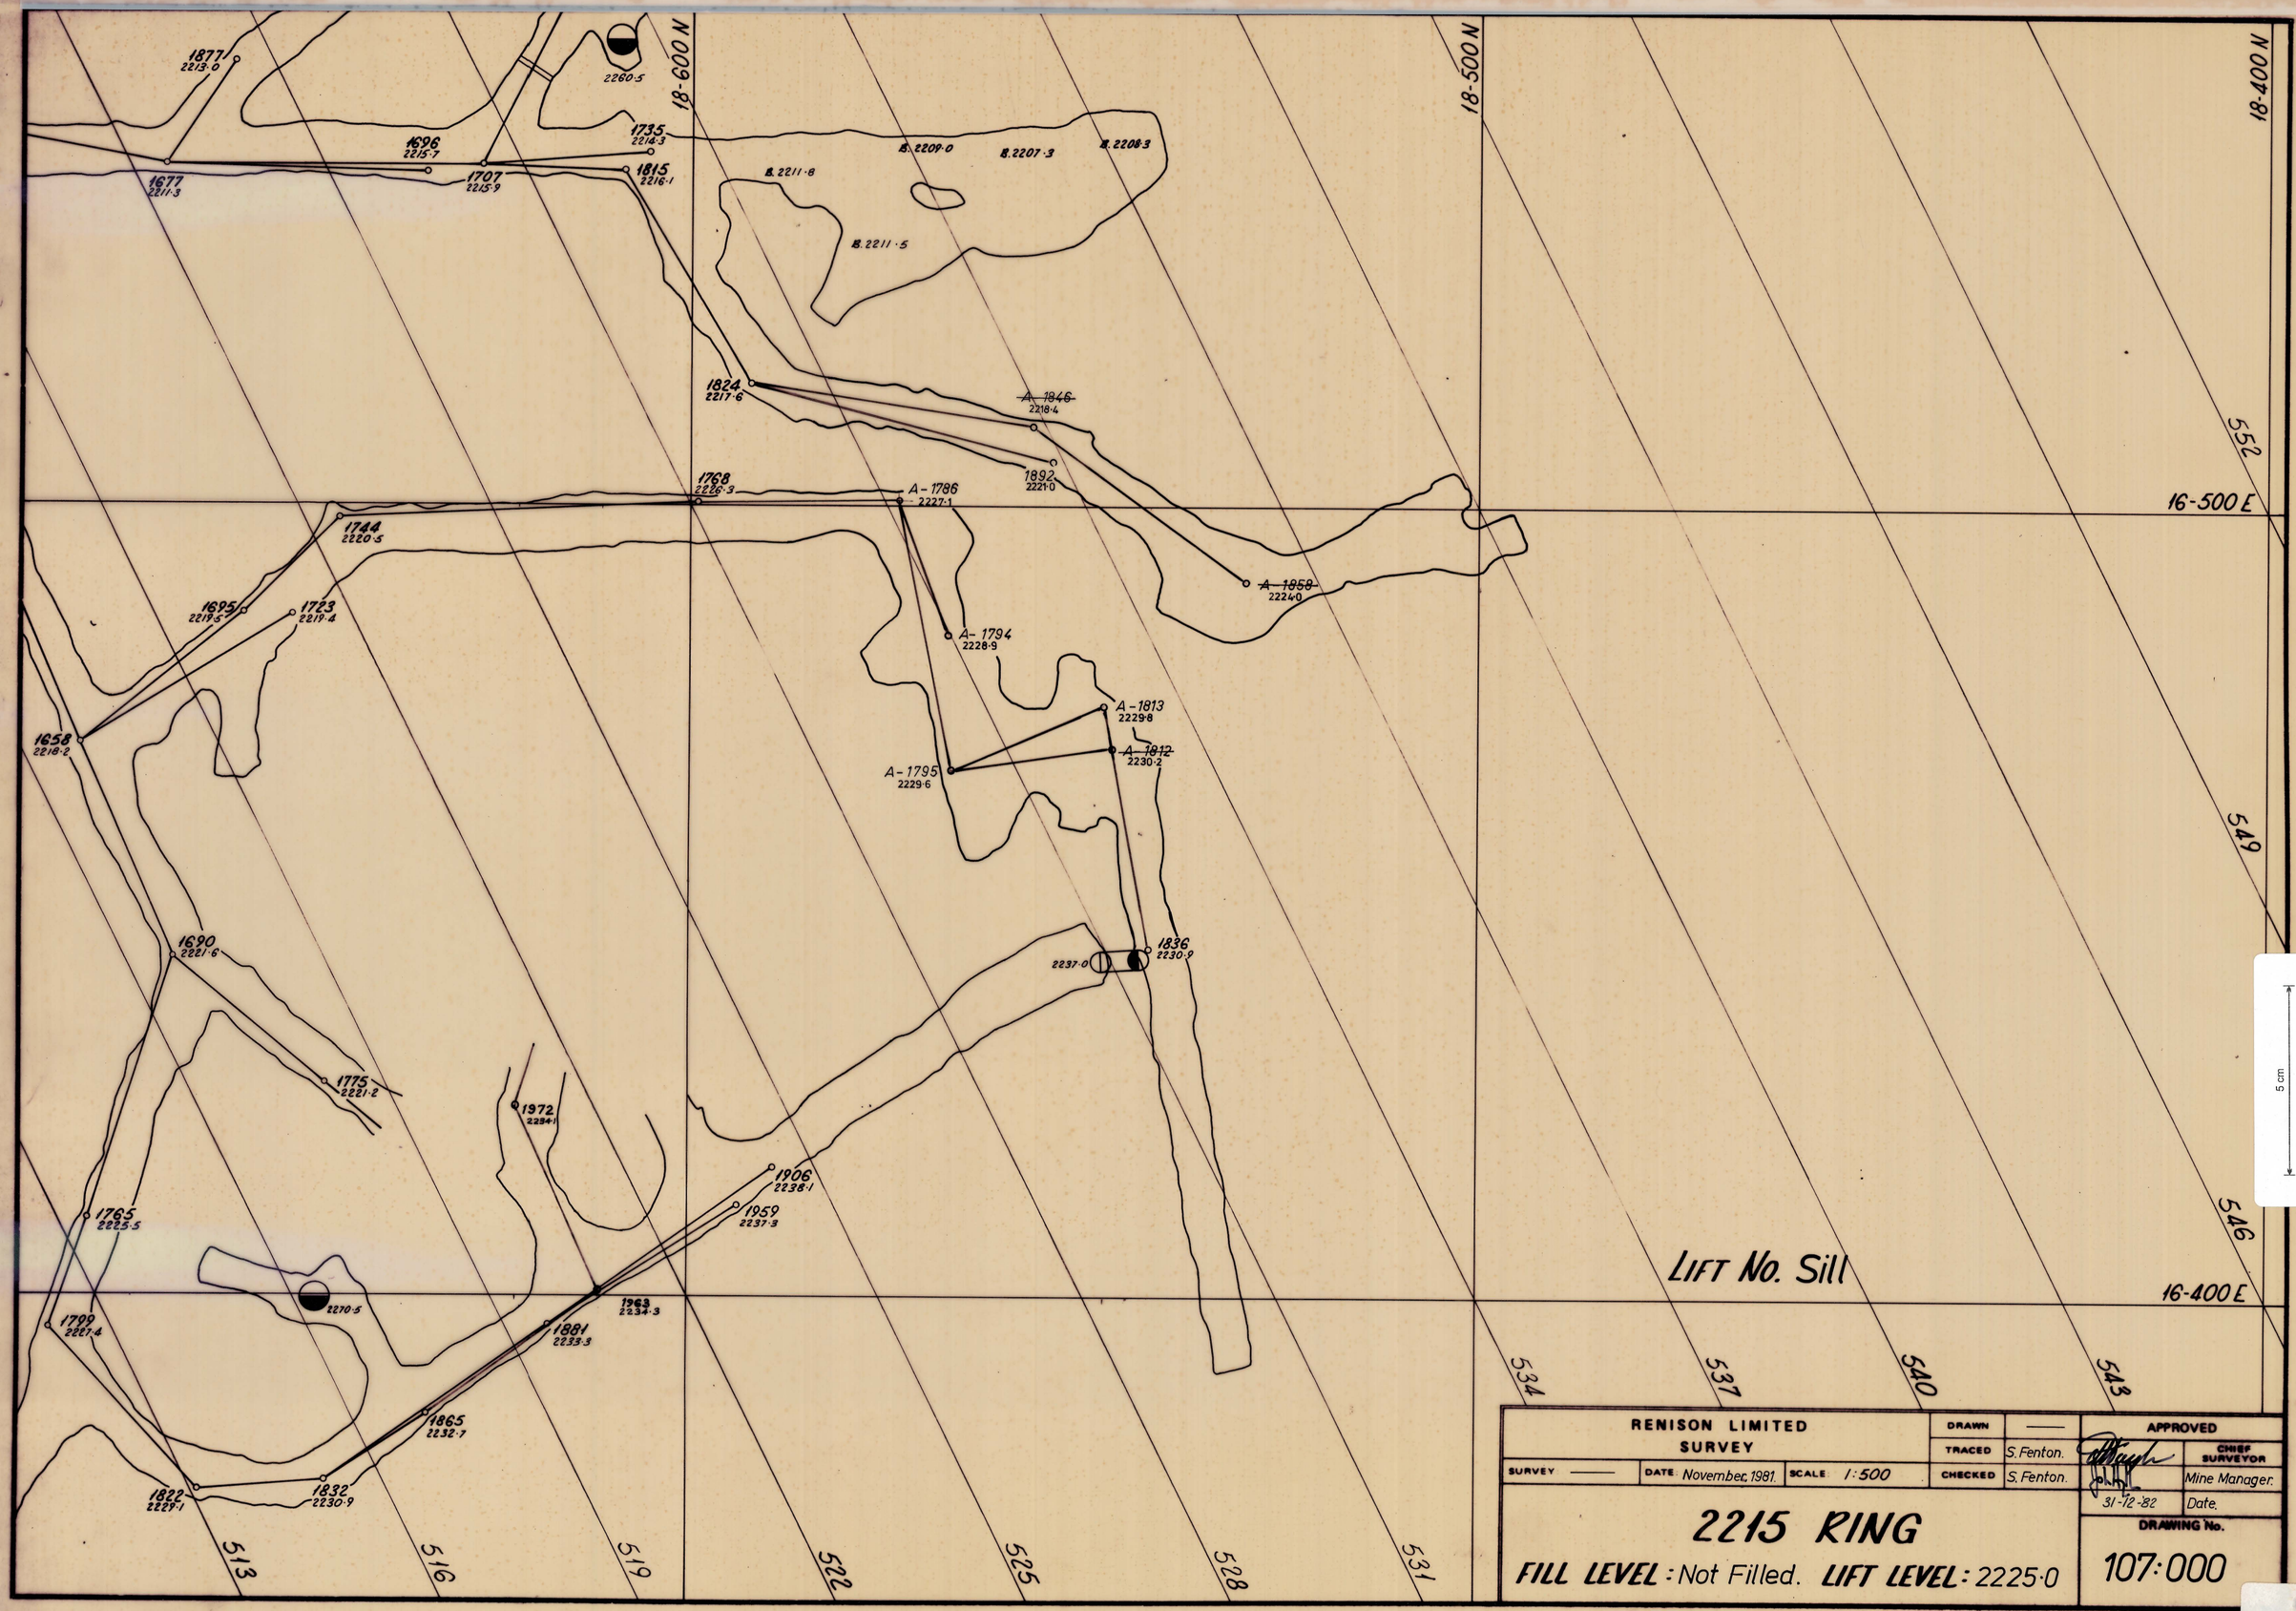

RENISON LIMITED SURVEY			DRAWN	—	APPROVED	
			TRACED	S. Fenton.		CHIEF SURVEYOR
SURVEY —	DATE November, 1981.	SCALE 1:500	CHECKED	S. Fenton.		Mine Manager.
					31-12-'82	Date.

2215 RING

FILL LEVEL: Not Filled. **LIFT LEVEL**: 2225·0

DRAWING No. 107:000

0376 – 370

83243