0376 – 372

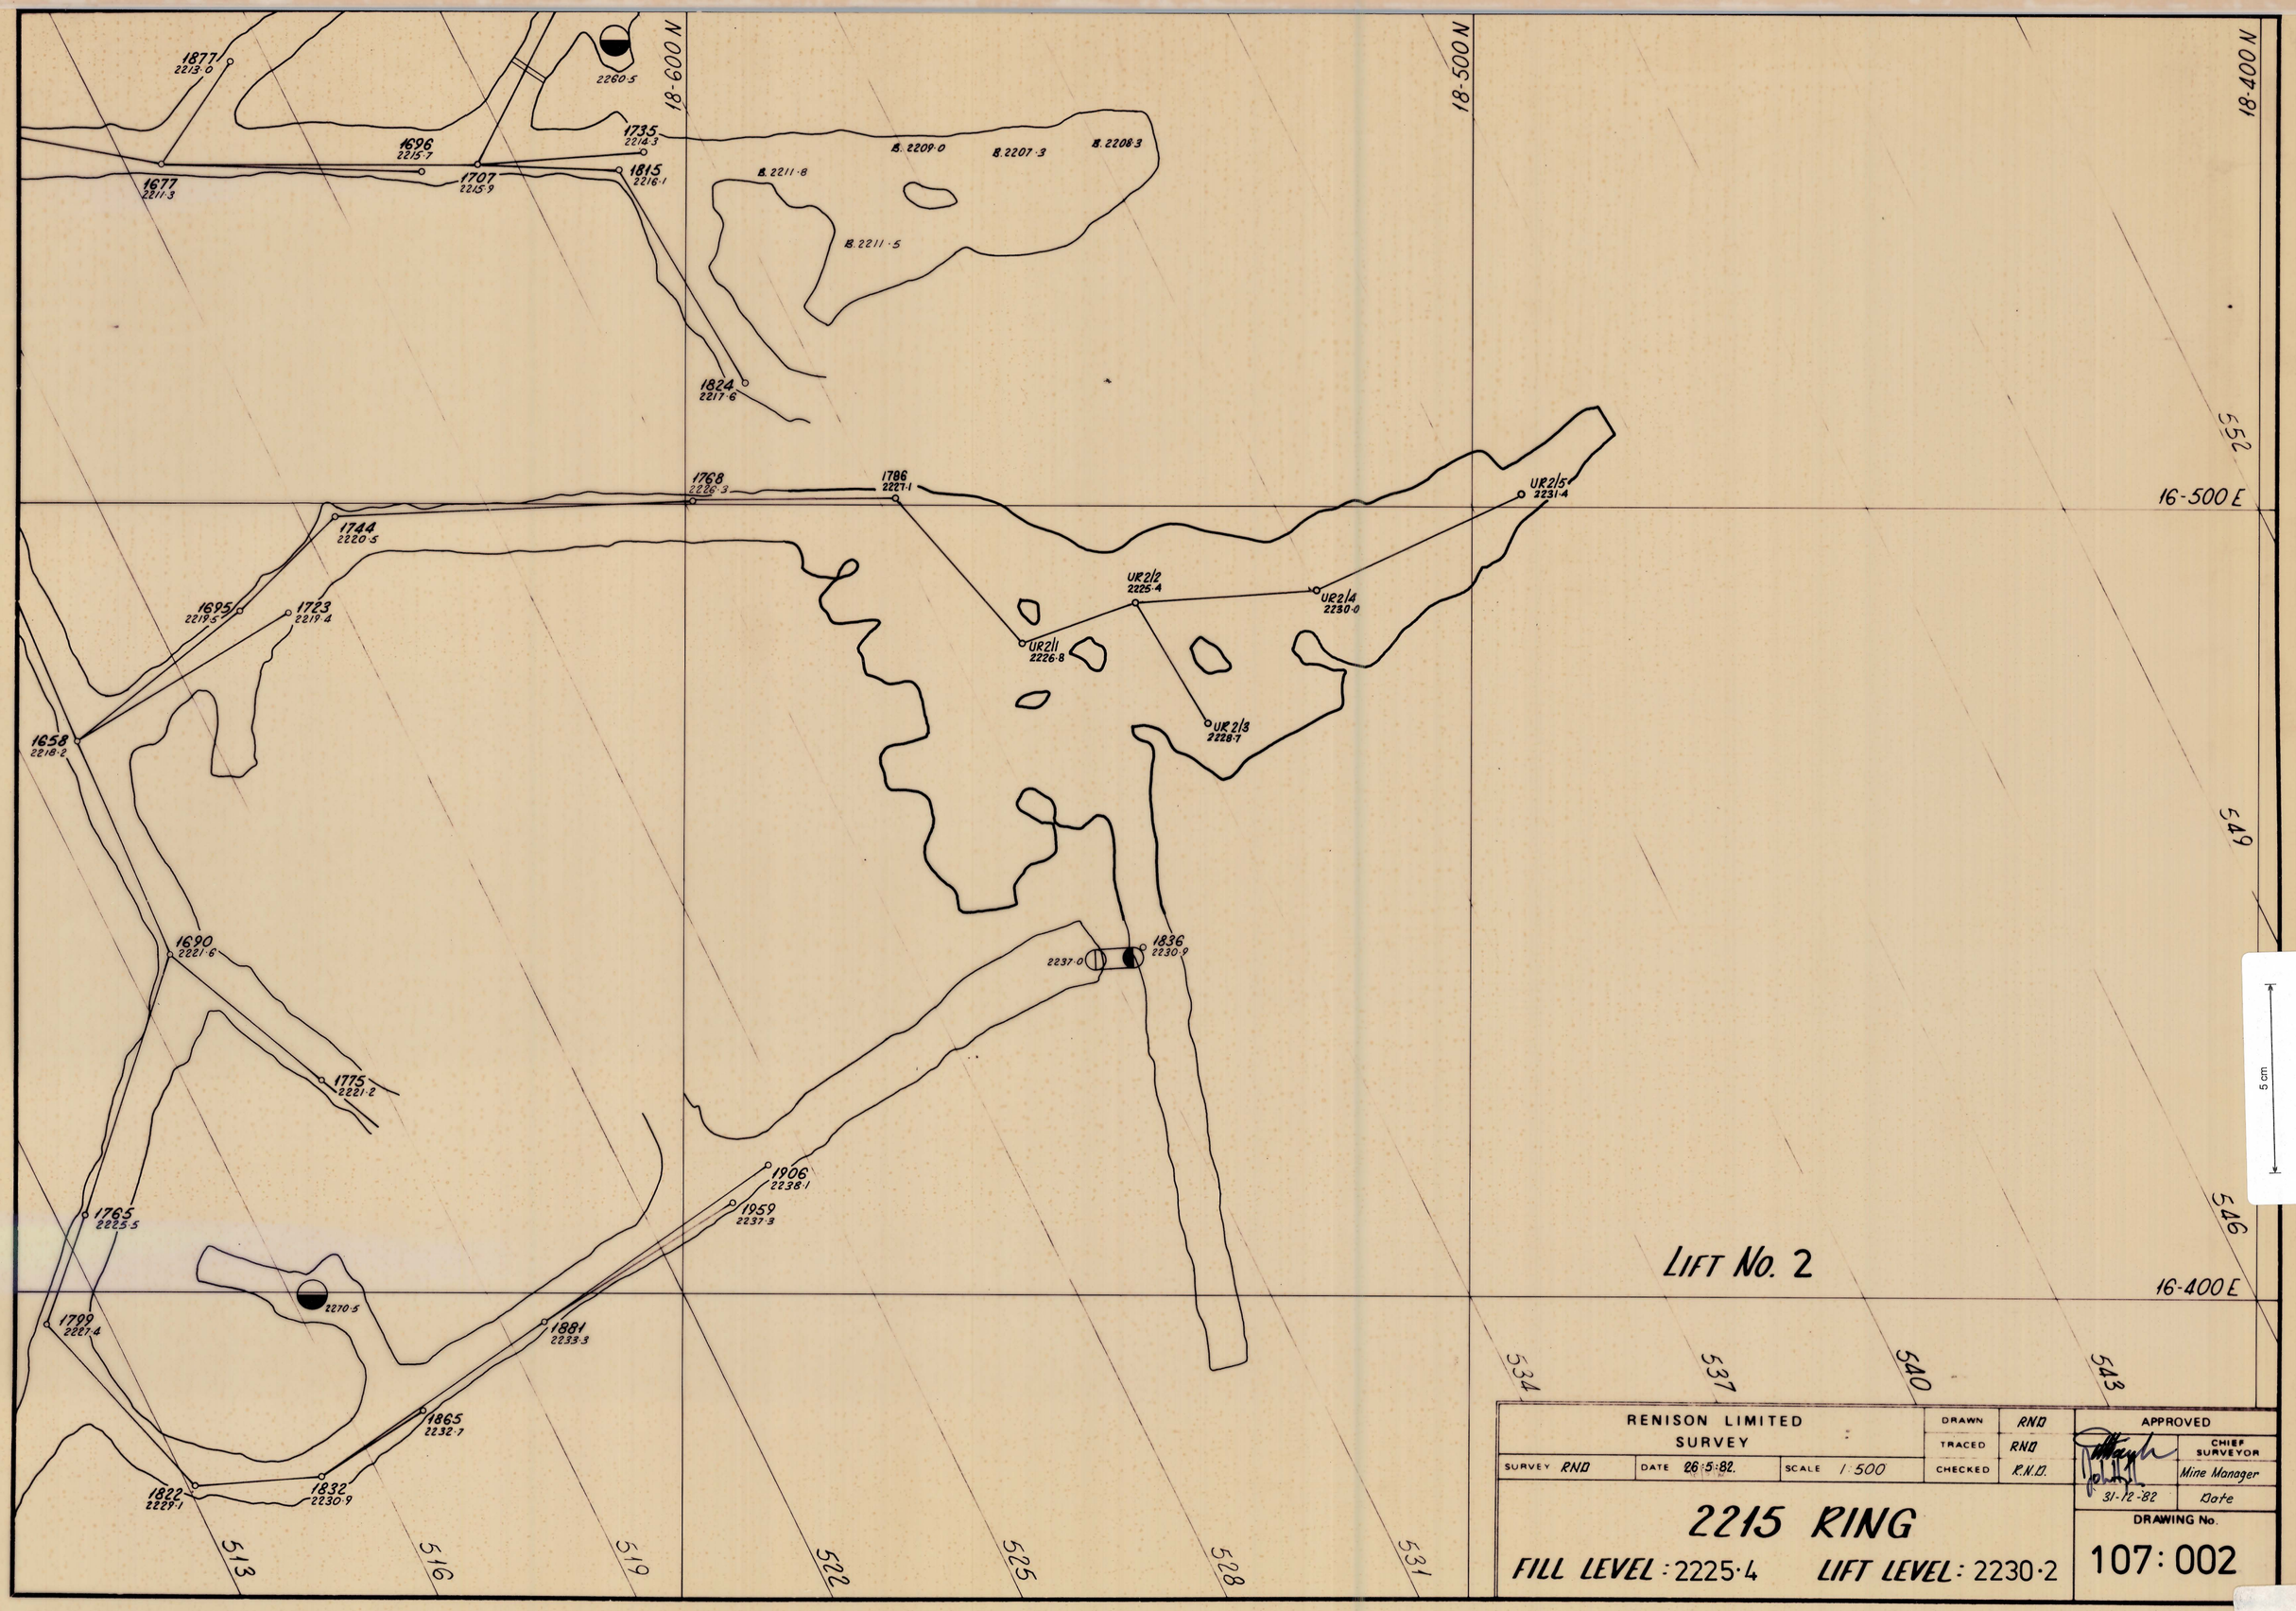

RENISON LIMITED SURVEY			DRAWN	RND	APPROVED
			TRACED	RND	CHIEF SURVEYOR
SURVEY RND	DATE 26·5·82.	SCALE 1:500	CHECKED	R.N.D.	Mine Manager
					31-12-82 Date
2215 RING					DRAWING No.
FILL LEVEL: 2225·4		LIFT LEVEL: 2230·2			107:002

83245