0376 – 373

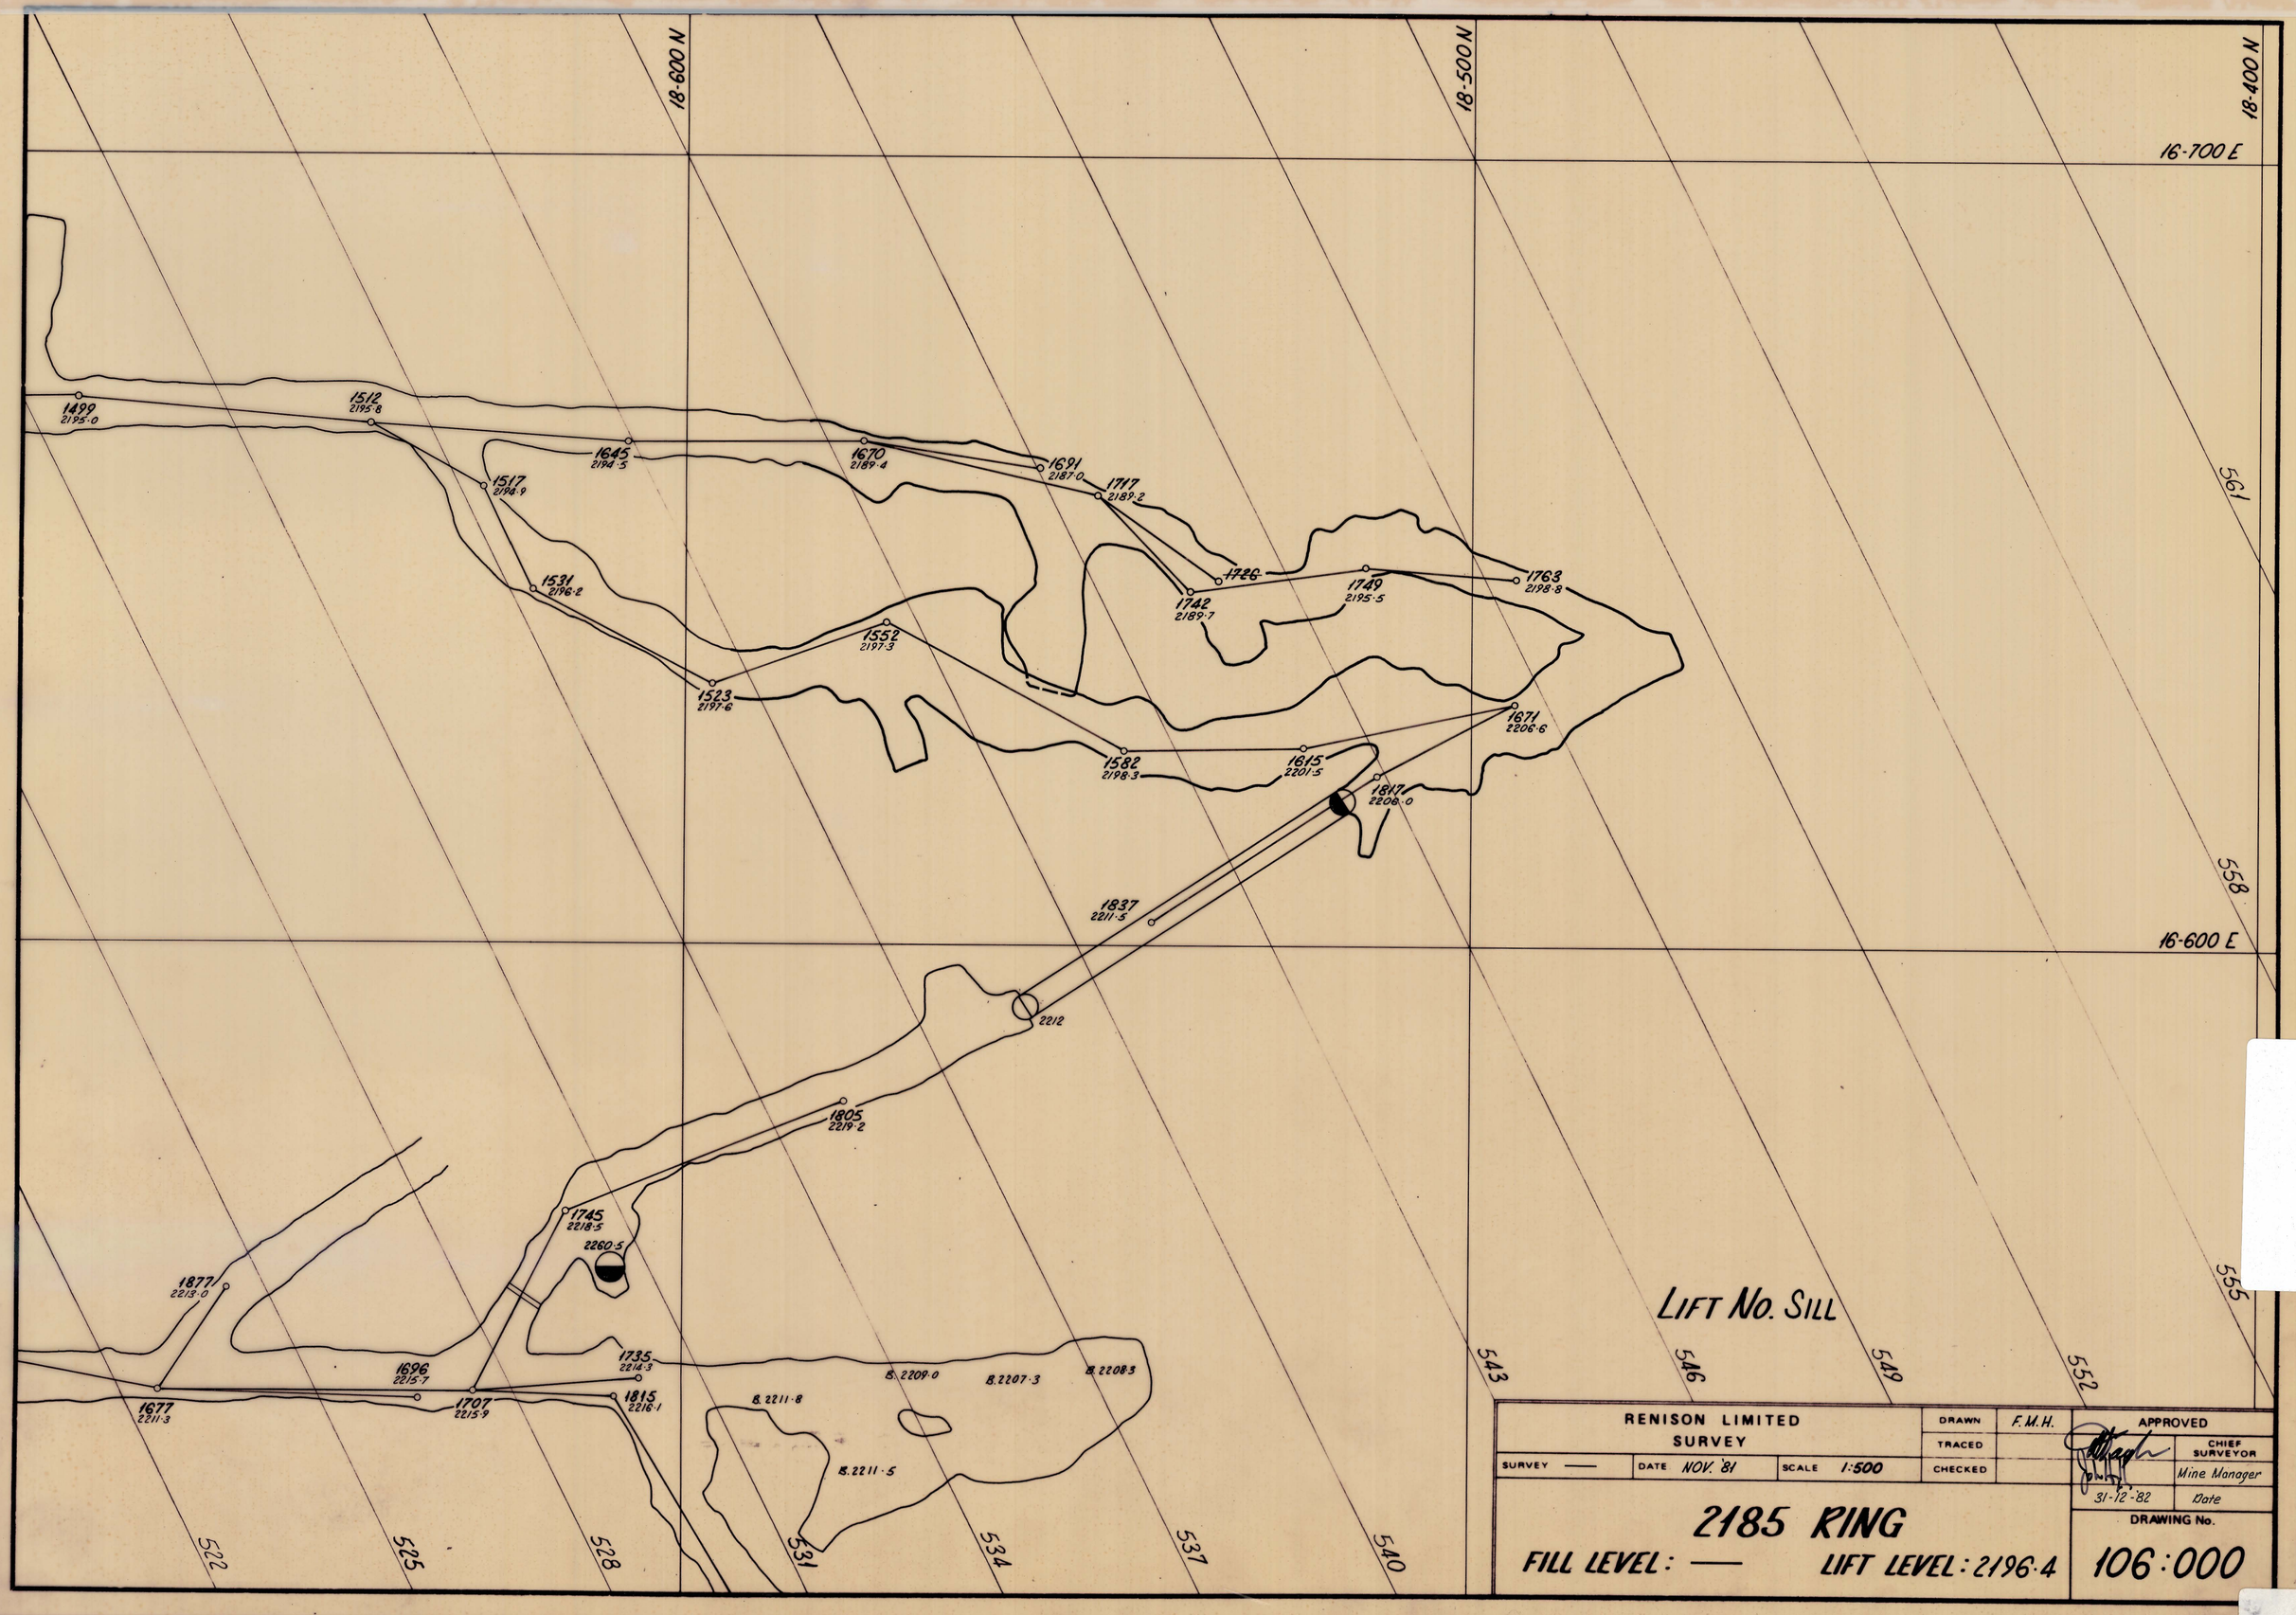

0376 – 373
5 cm
83246