0376 - 384

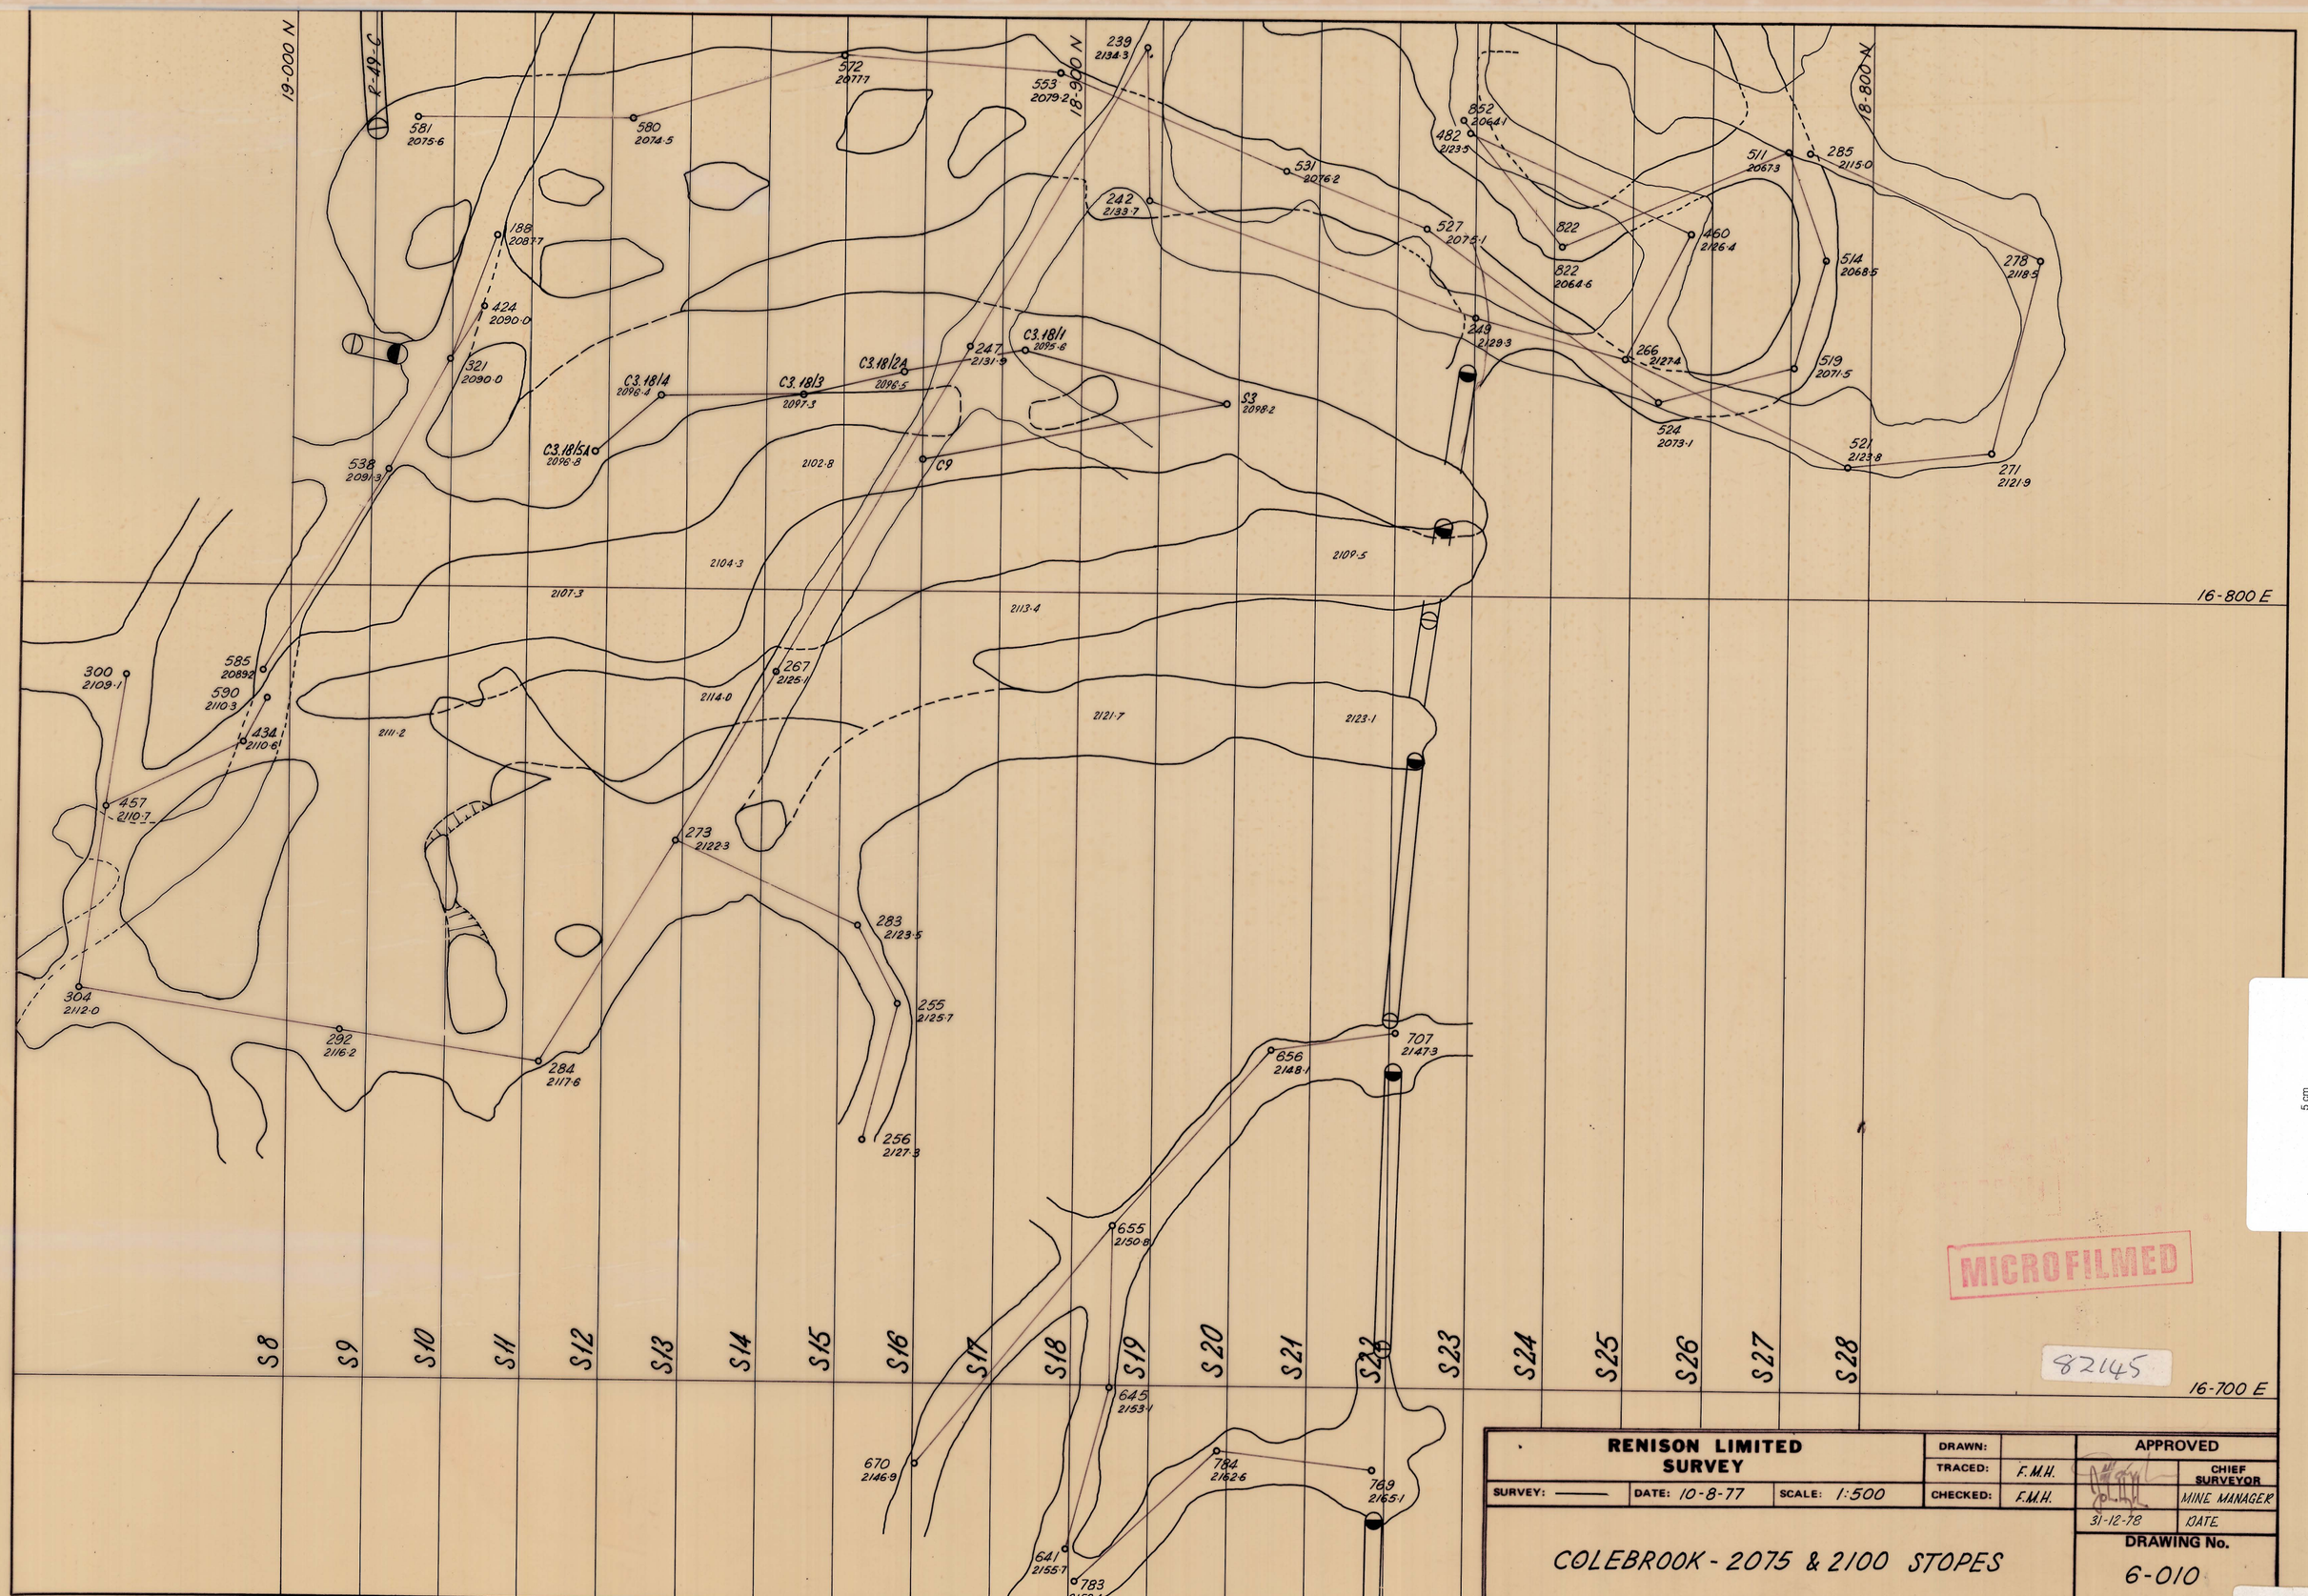

RENISON LIMITED SURVEY			DRAWN:		APPROVED	
SURVEY: ———	DATE: 10-8-77	SCALE: 1:500	TRACED:	F.M.H.		CHIEF SURVEYOR
			CHECKED:	F.M.H.		MINE MANAGER
					31-12-78	DATE
COLEBROOK - 2075 & 2100 STOPES					DRAWING No. 6-010	

A 9548

MICROFILMED

82145

0376 - 384

5 cm

83203