0376-387

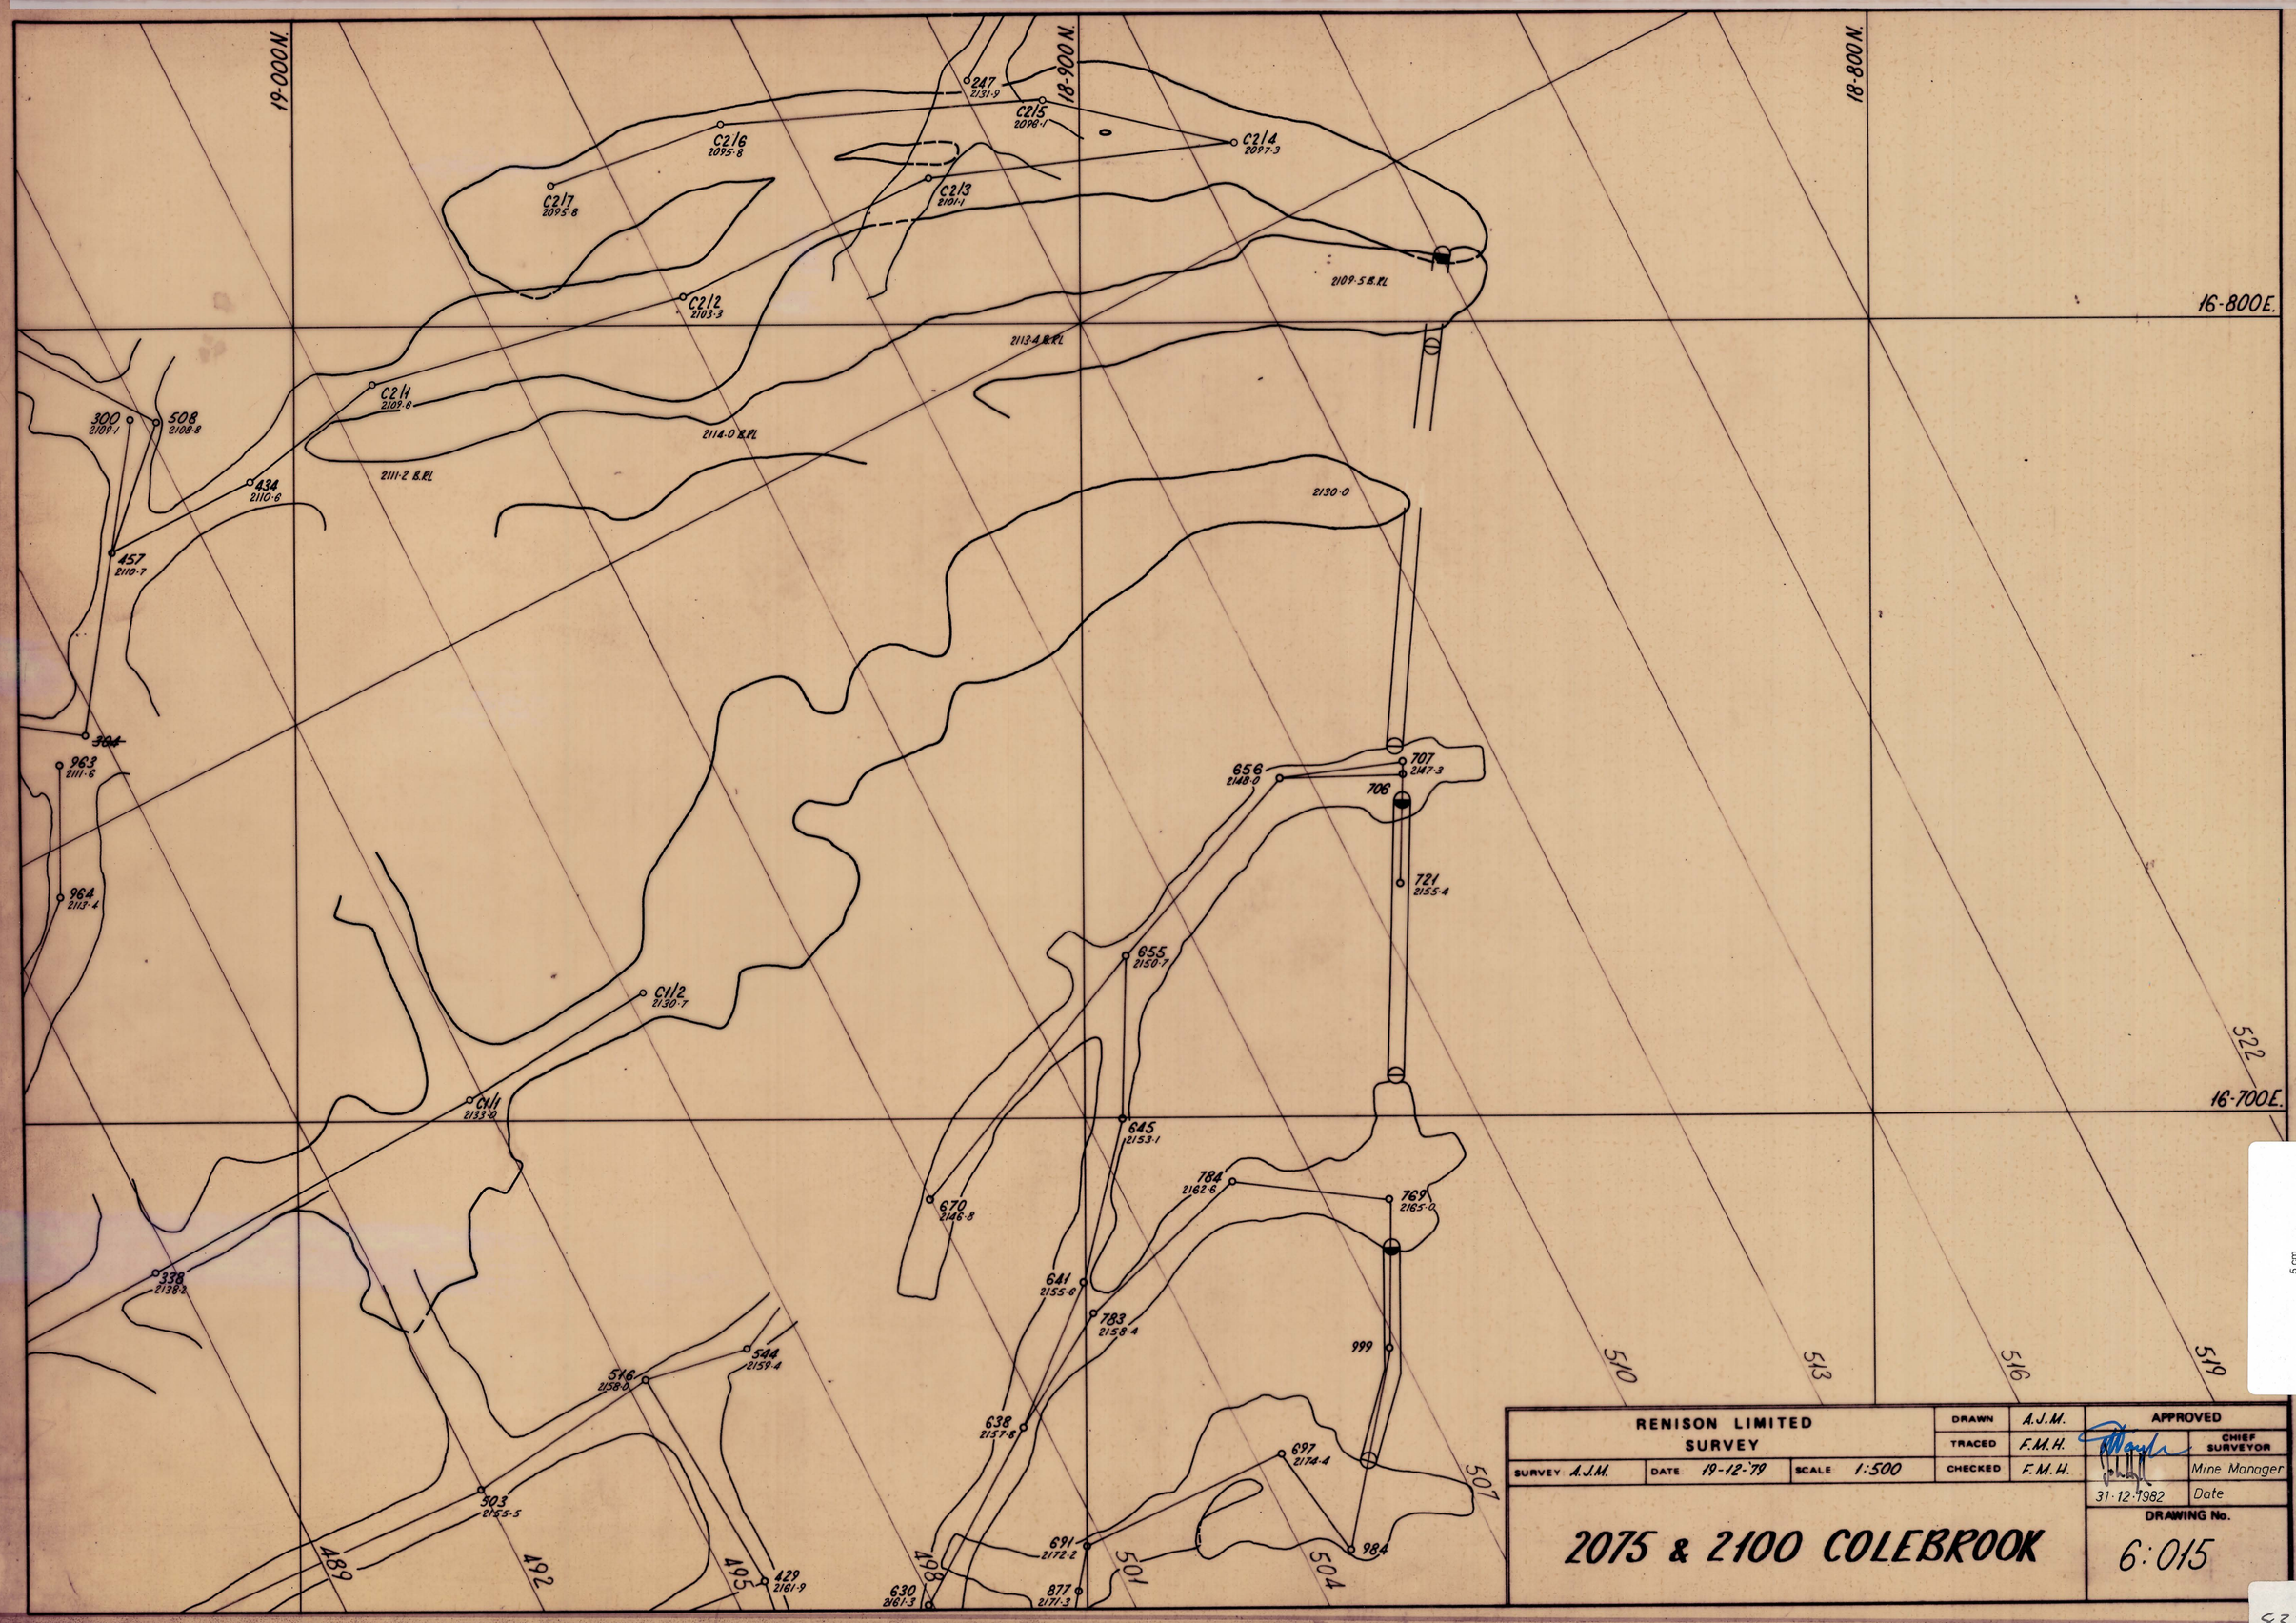
19-000N.
18-900N.
18-800N.
16-800E.
16-700E.
C216 2095·8
C217 2095·8
C215 2098·1
C214 2097·3
C213 2101·1
C212 2103·3
C211 2109·6
247 2131·9
2109·5 B.RL
2113·4 B.RL
2114·0 B.RL
2111·2 B.RL
2130·0
300 2109·1
508 2108·8
434 2110·6
457 2110·7
963 2111·6
964 2113·4
C112 2130·7
C111 2133·0
338 2138·2
656 2148·0
707 2147·3
706
721 2155·4
655 2150·7
645 2153·1
784 2162·6
769 2165·0
670 2146·8
641 2155·6
783 2158·4
999
638 2157·8
697 2174·4
984
691 2172·2
877 2171·3
630 2161·3
429 2161·9
516 2158·0
544 2159·4
503 2155·5
5 cm
0376-387

RENISON LIMITED SURVEY				DRAWN	A.J.M.	APPROVED	
				TRACED	F.M.H.		CHIEF SURVEYOR
SURVEY A.J.M.	DATE 19-12-79	SCALE 1:500		CHECKED	F.M.H.		Mine Manager
						31·12·1982	Date
2075 & 2100 COLEBROOK						DRAWING No. 6:015	

83208