0376-390

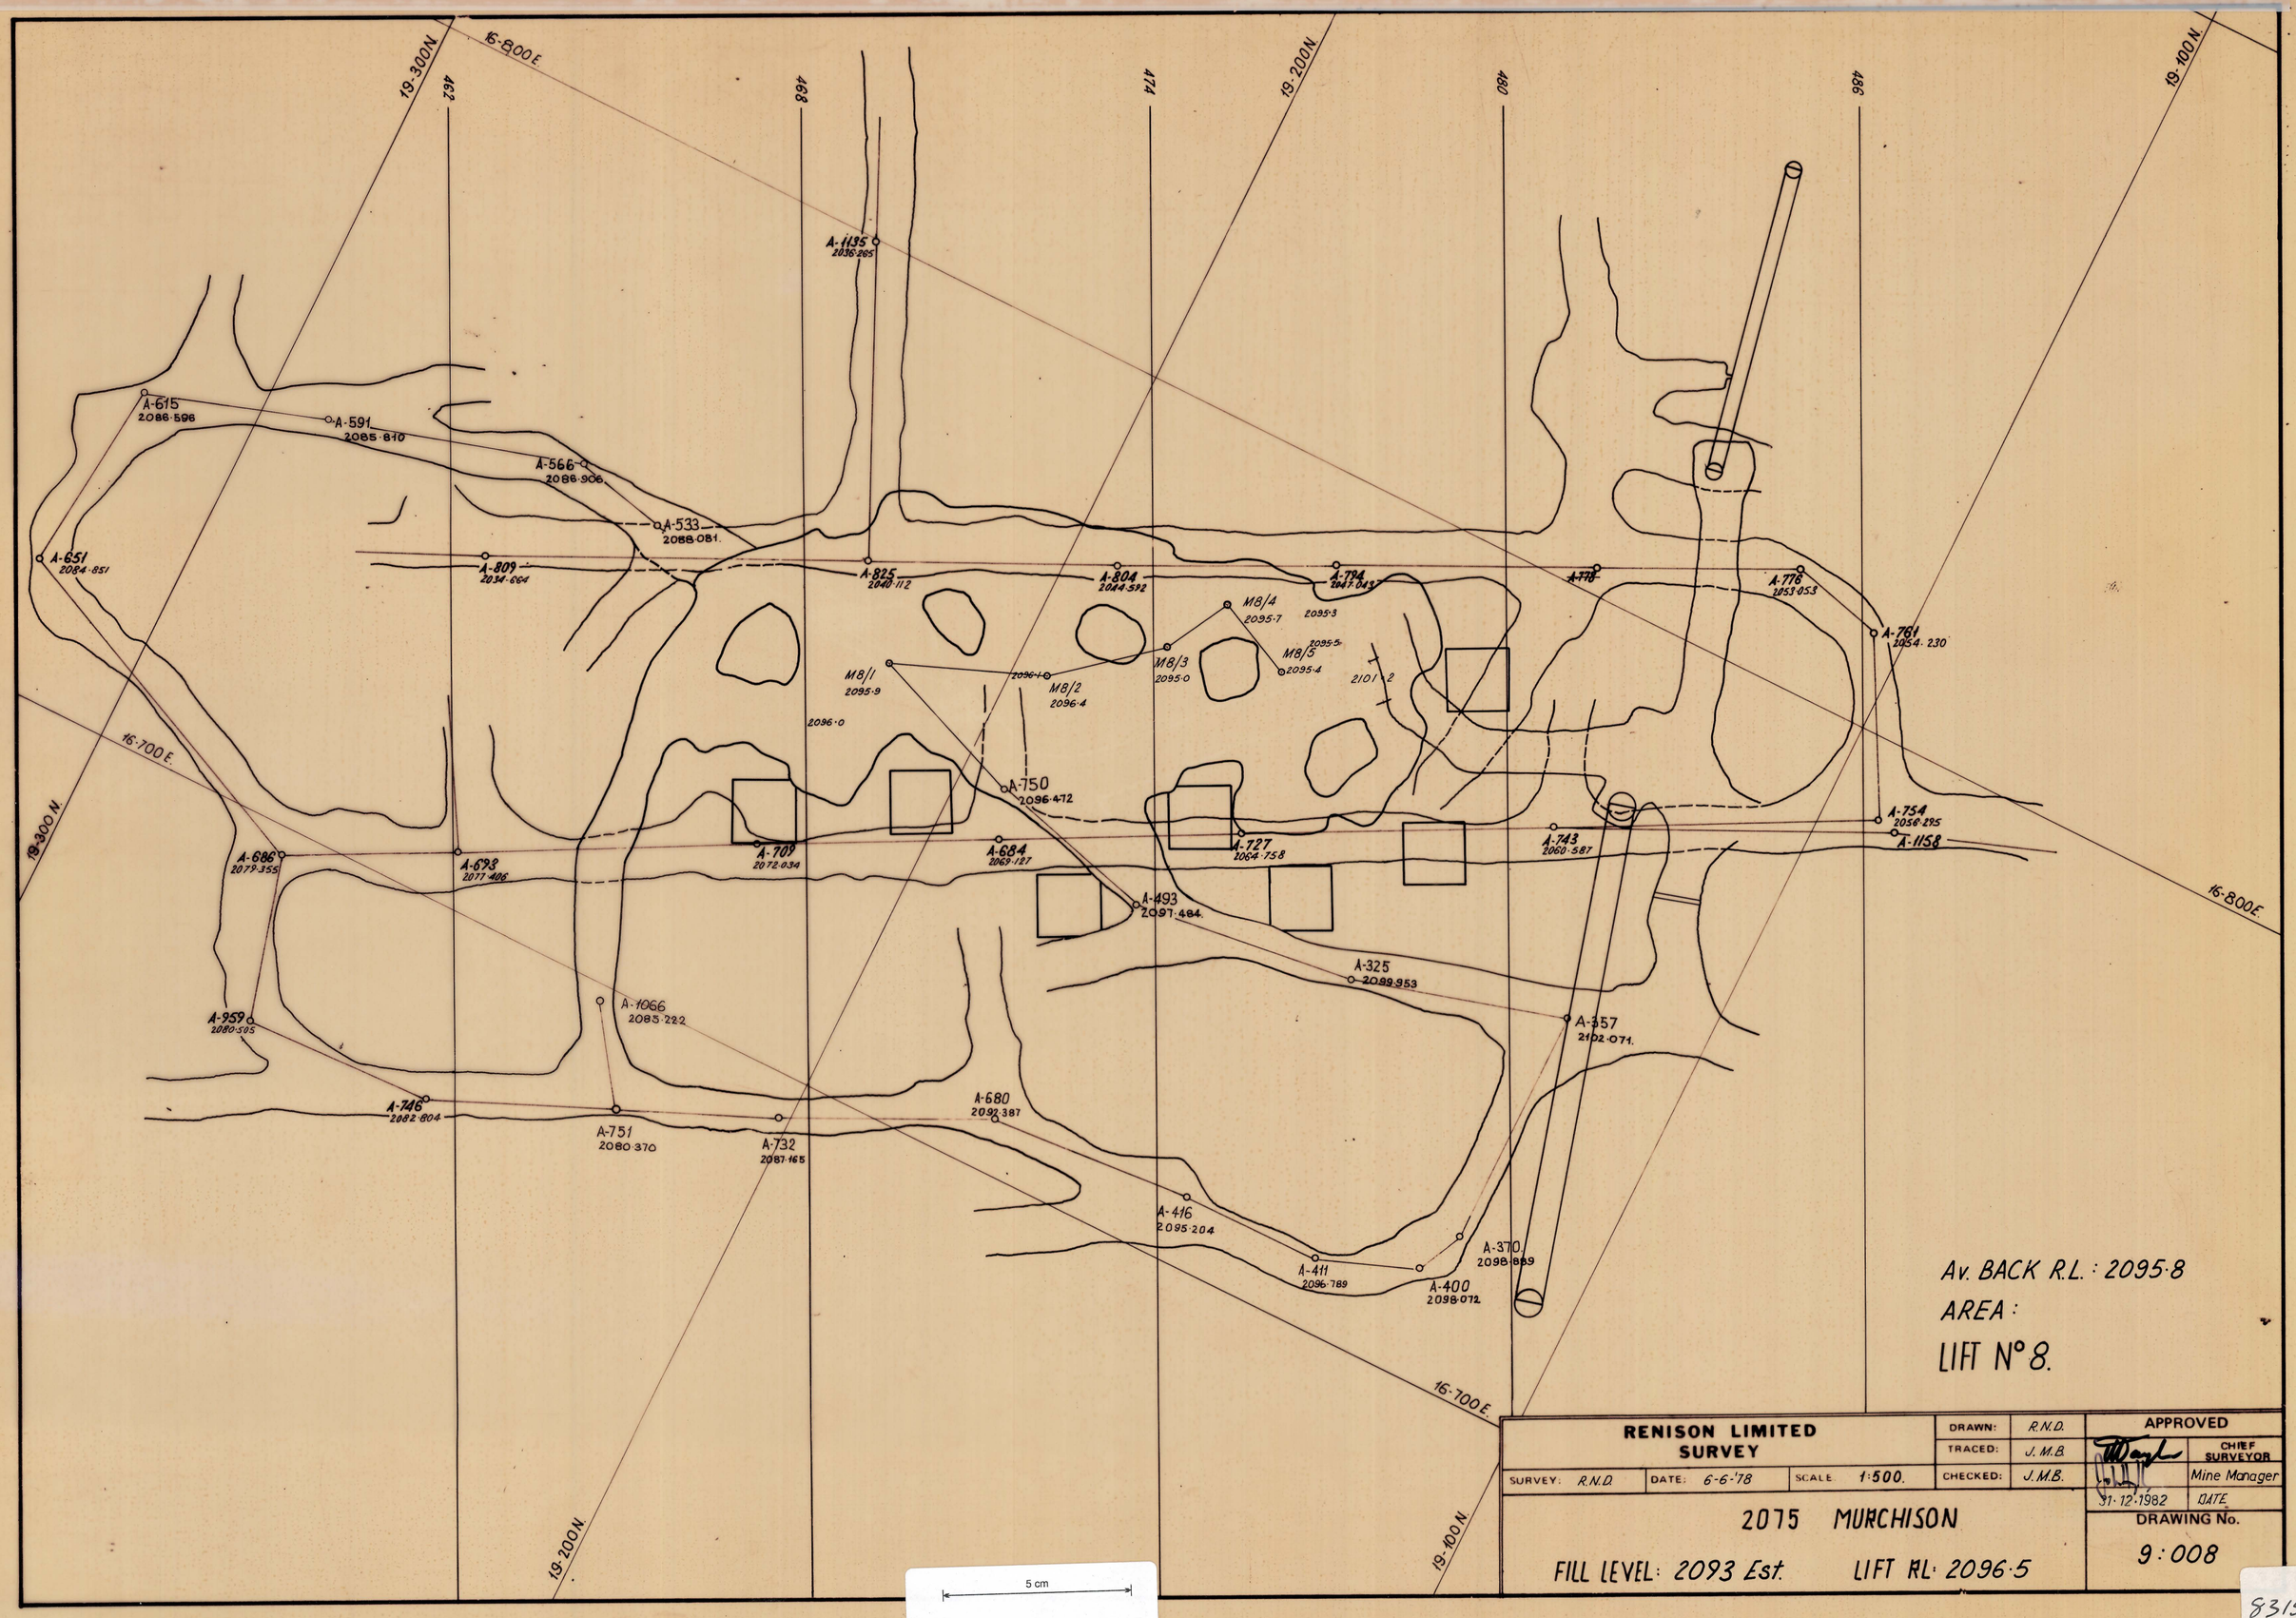

RENISON LIMITED SURVEY			DRAWN: R.N.D.	APPROVED
			TRACED: J.M.B.	CHIEF SURVEYOR
SURVEY: R.N.D.	DATE: 6-6-'78	SCALE 1:500.	CHECKED: J.M.B.	Mine Manager
				31·12·1982 DATE
2075 MURCHISON				DRAWING No.
FILL LEVEL: 2093 Est.		LIFT RL: 2096·5		9:008

0376-390

83153