0376 - 397

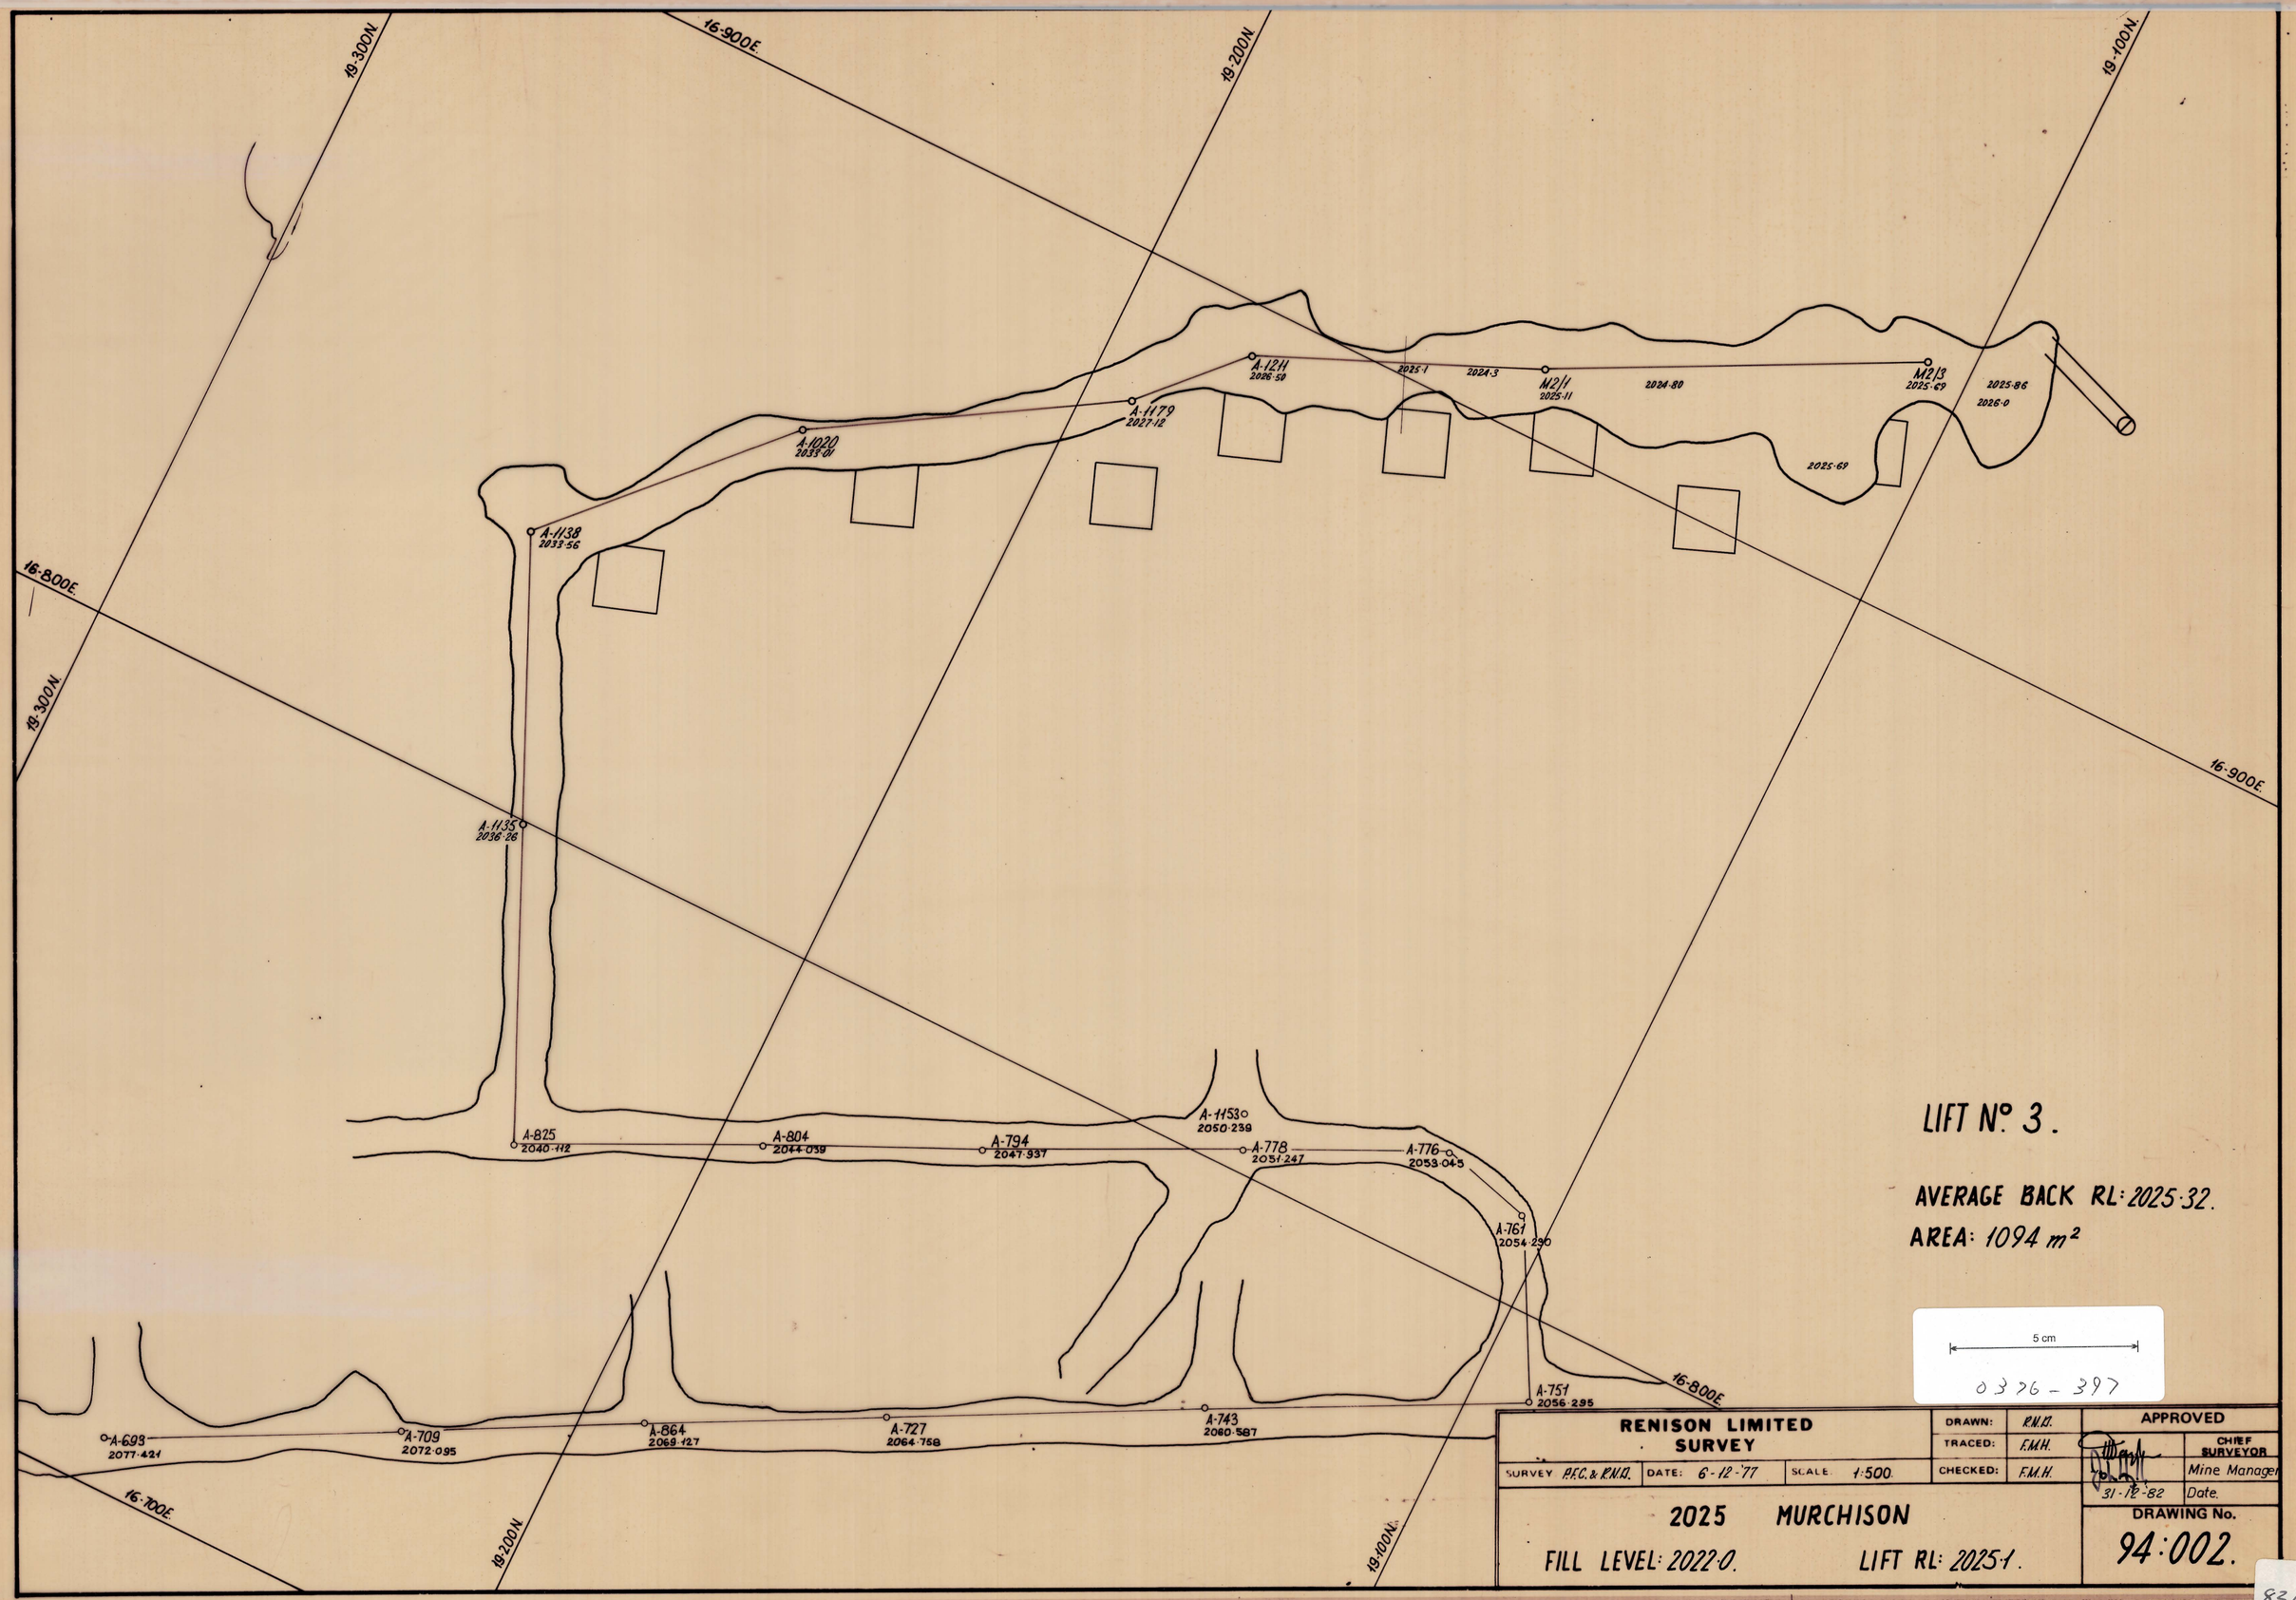


83160