0376 – 400

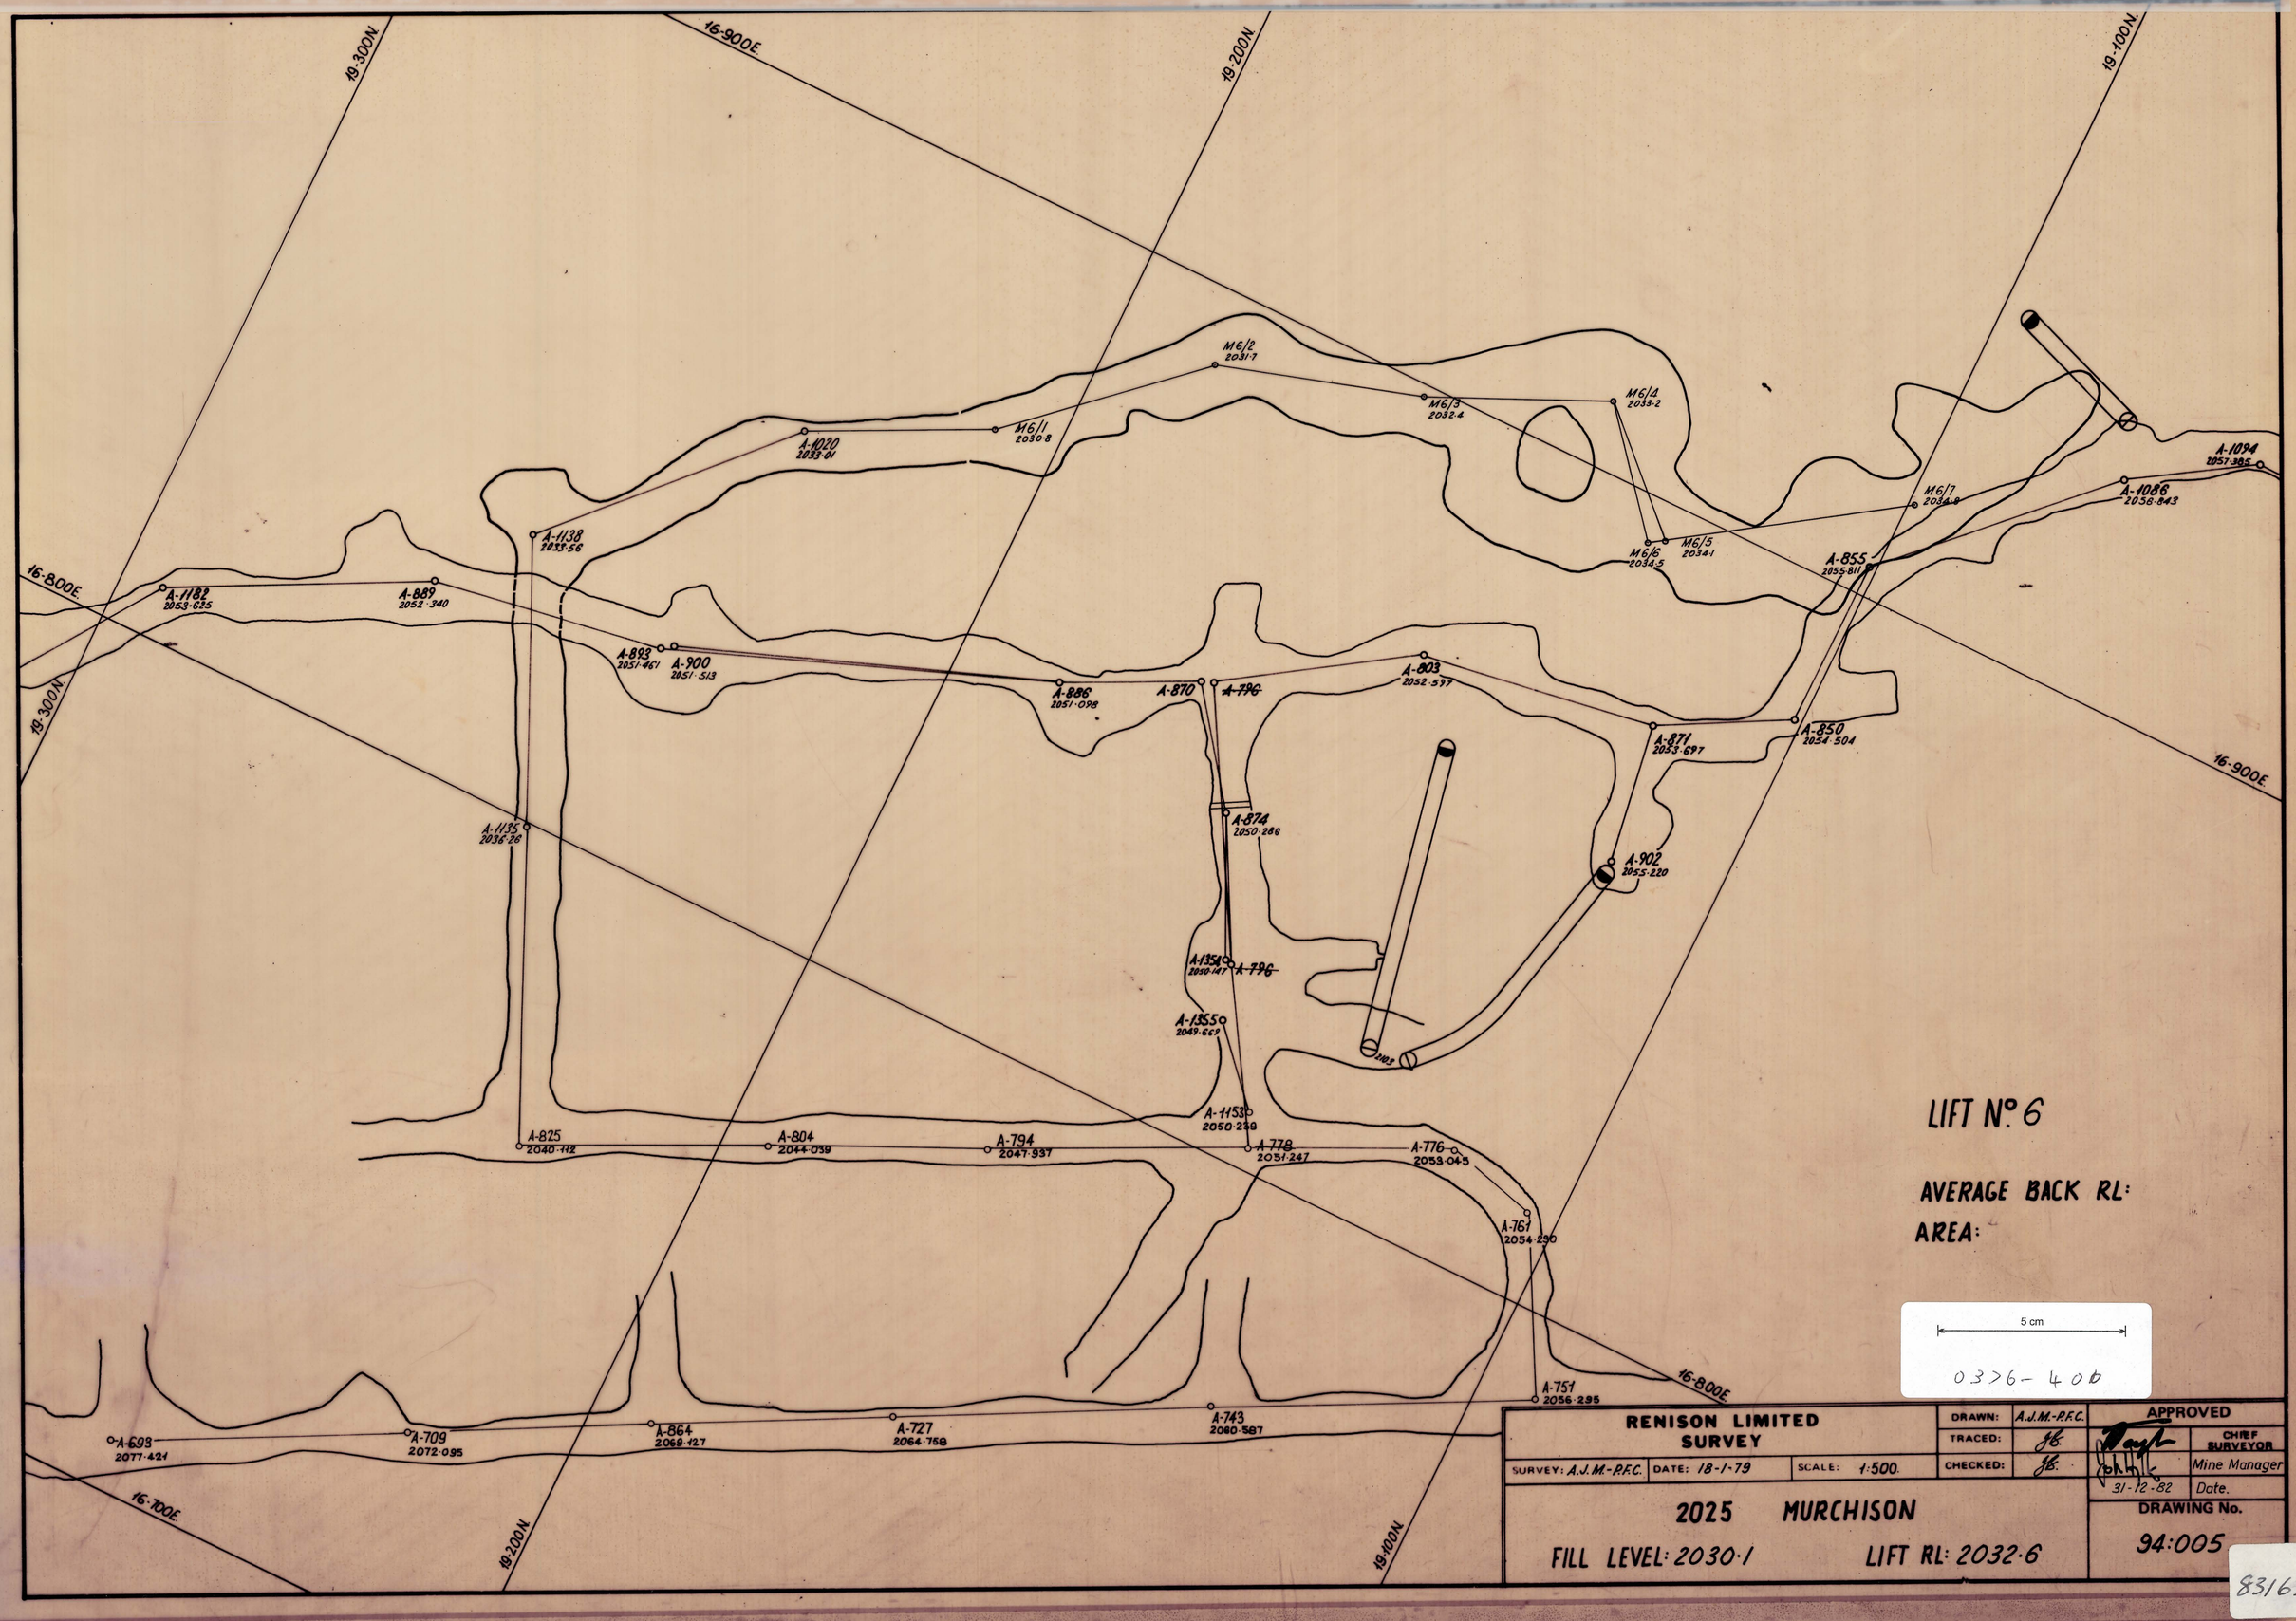
19-300N.
16-900E.
19-200N.
19-100N.
16-800E.
19-300N.
16-900E.
16-700E.
19-200N.
19-100N.
16-800E.
M6/2
2031·7
M6/3
2032·4
M6/4
2033·2
M6/1
2030·8
A-1020
2033·01
A-1138
2037·56
A-1182
2053·635
A-889
2052·340
A-893
2051·461
A-900
2051·513
A-886
2051·098
A-870
A-796
A-803
2052·537
A-871
2053·697
A-850
2054·504
A-855
2055·811
M6/7
2034·8
M6/6
2034·5
M6/5
2034·1
A-1094
2057·385
A-1086
2058·843
A-874
2050·286
A-902
2055·220
A-1135
2036·26
A-1354
2050·147
A-796
A-1355
2049·667
A-1153
2050·239
A-825
2040·112
A-804
2044·039
A-794
2047·937
A-778
2051·247
A-776
2053·045
A-761
2054·250
A-751
2056·295
A-693
2077·421
A-709
2072·095
A-864
2069·127
A-727
2064·758
A-743
2060·587
LIFT Nº 6
AVERAGE BACK RL:
AREA:
5 cm
0376-400
RENISON LIMITED
SURVEY
SURVEY: A.J.M.-P.F.C.
DATE: 18-1-79
SCALE: 1:500.
DRAWN: A.J.M.-P.F.C.
TRACED: J.B.
CHECKED: J.B.
APPROVED
CHIEF SURVEYOR
Mine Manager
31-12-82
Date.
2025 MURCHISON
FILL LEVEL: 2030·1
LIFT RL: 2032·6
DRAWING No.
94:005
83163