0376 - 404

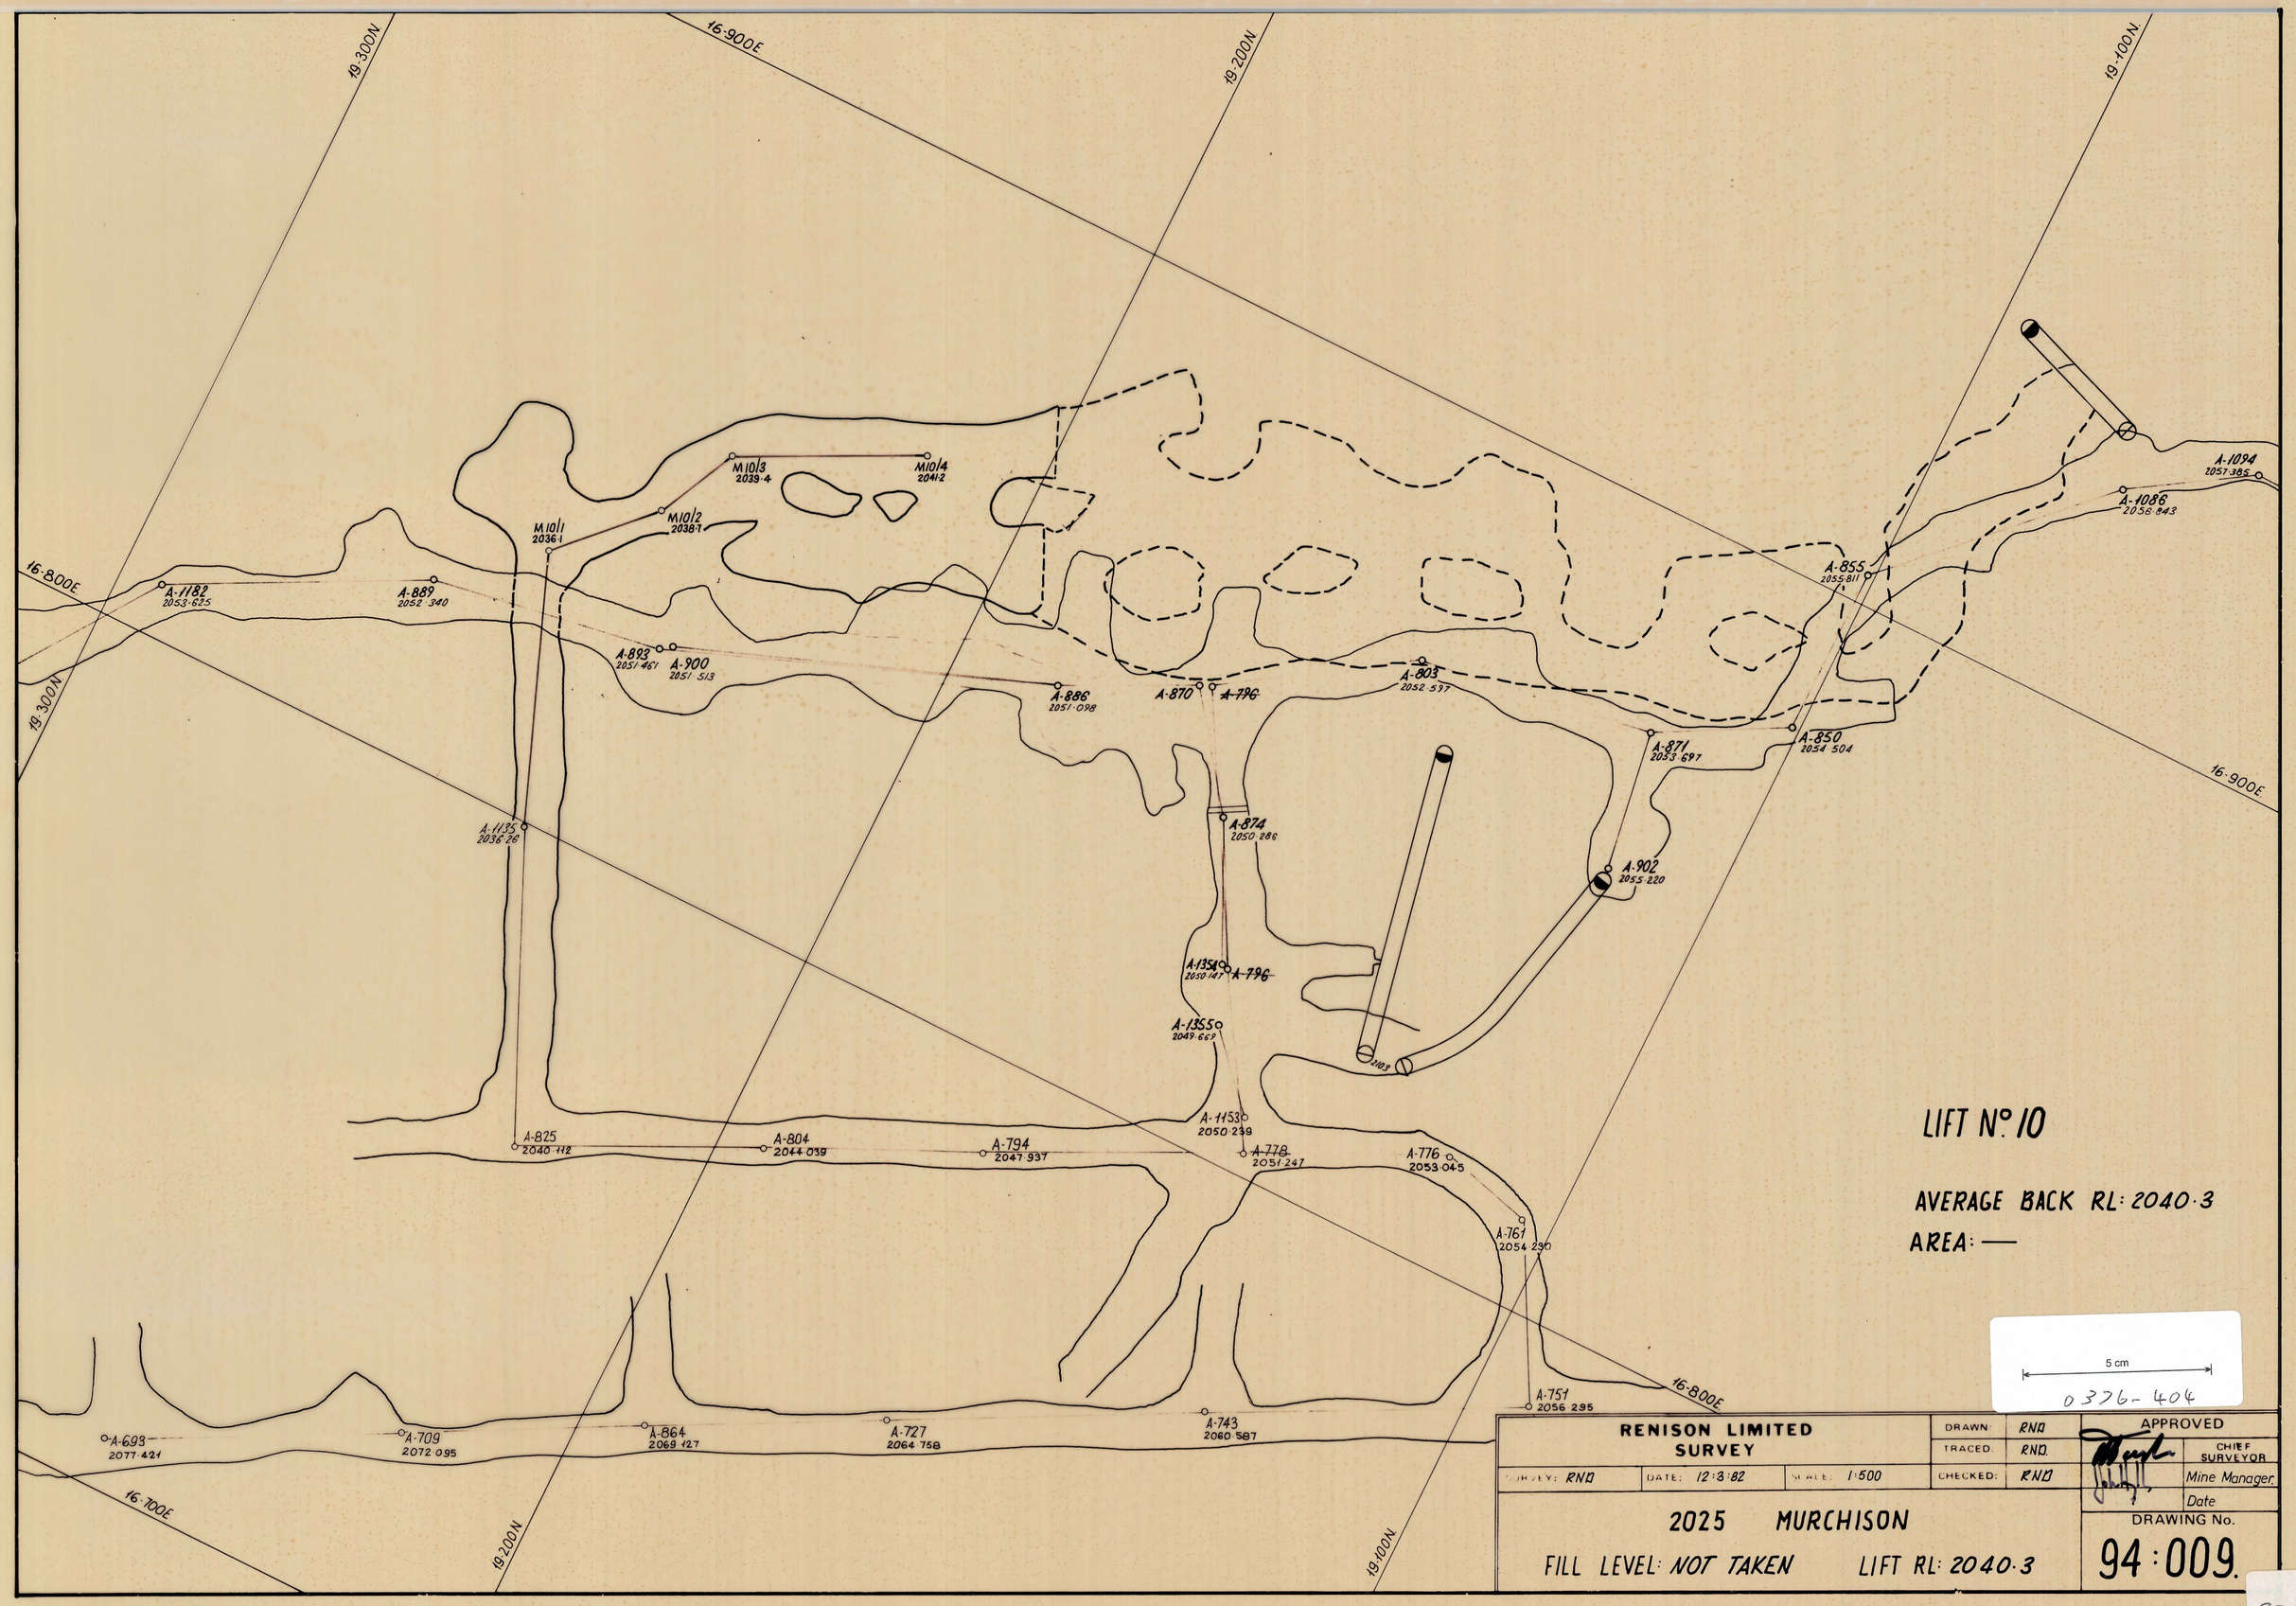

LIFT Nº 10

AVERAGE BACK RL: 2040·3

AREA: —

5 cm

0376-404

RENISON LIMITED SURVEY			DRAWN: RNO	APPROVED	
			TRACED: RNO	CHIEF SURVEYOR	
SURVEY: RNO	DATE: 12·3·82	SCALE: 1:500	CHECKED: RNO	Mine Manager	
				Date	
2025 MURCHISON				DRAWING No.	
FILL LEVEL: NOT TAKEN		LIFT RL: 2040·3		94:009.	

83167