0376- 407

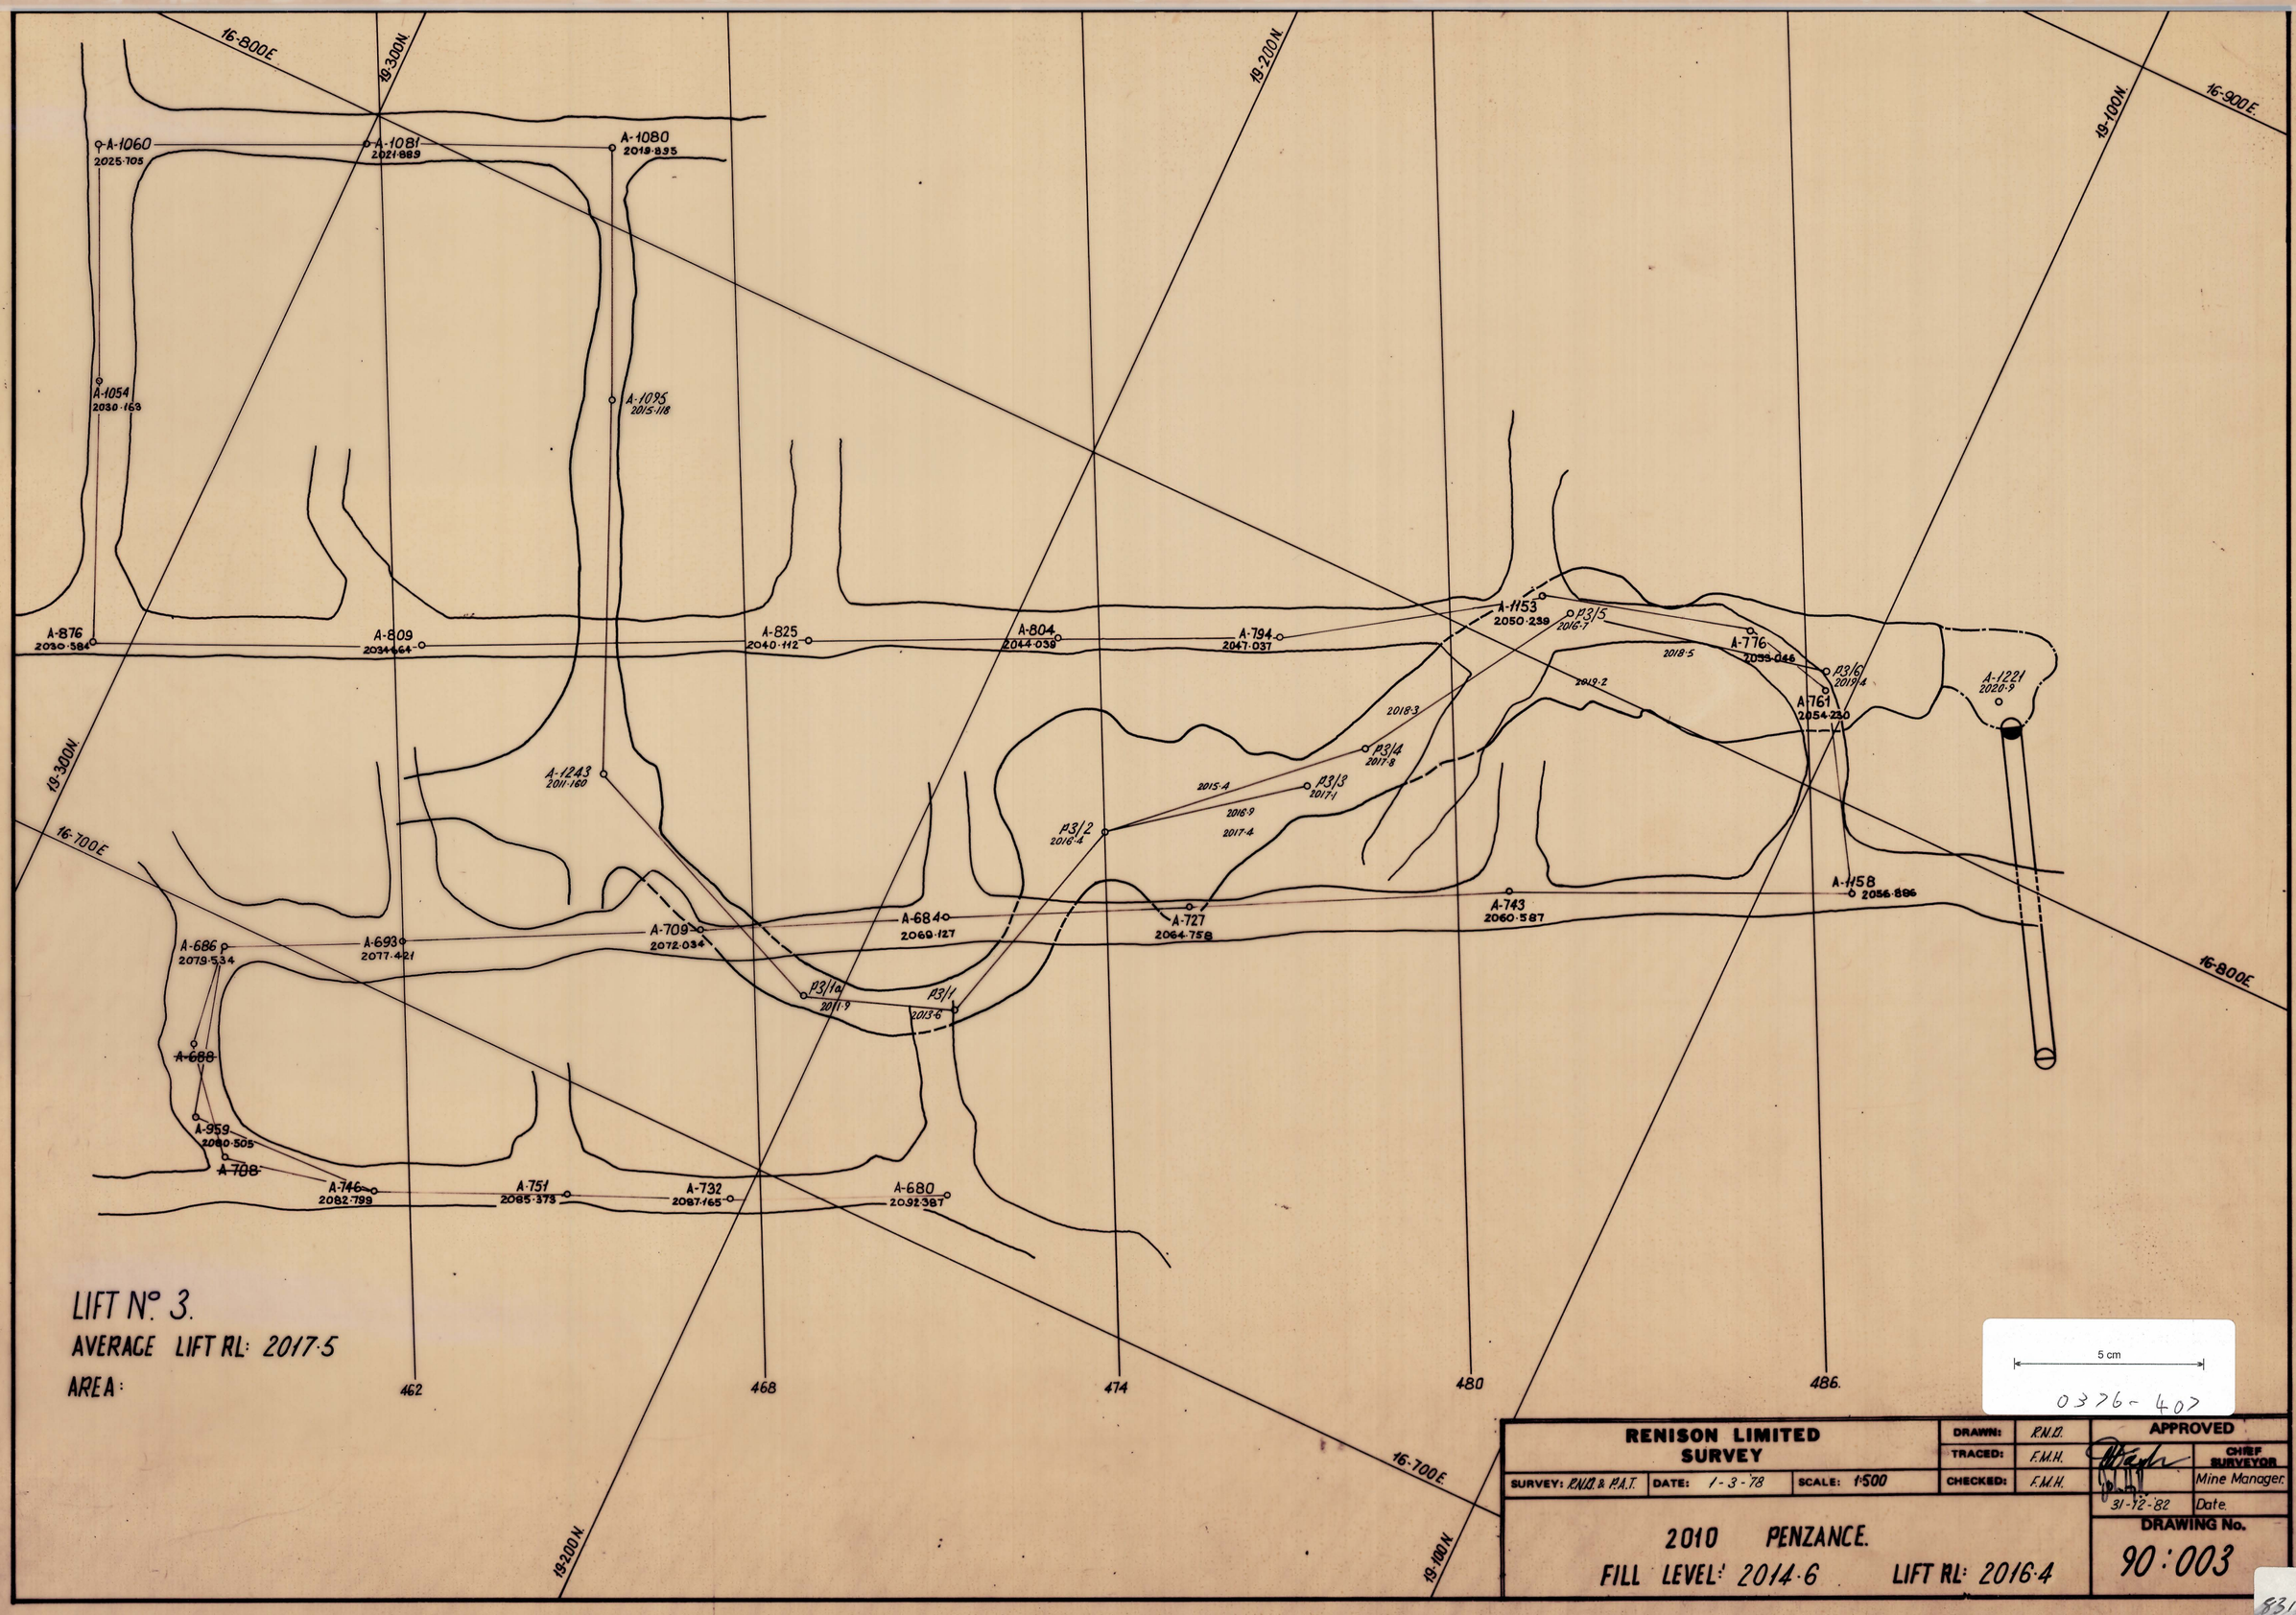
16-800E
19-300N
19-200N
19-100N
16-900E
16-700E
A-1060
2025·705
A-1081
2021·889
A-1080
2019·895
A-1054
2030·168
A-1095
2015·118
A-876
2030·584
A-809
2034·664
A-825
2040·112
A-804
2044·039
A-794
2047·037
A-1153
2050·239
P3/5
2016·7
A-776
2053·045
P3/6
2019·4
A-761
2054·230
A-1221
2020·9
2018·5
2019·2
2018·3
P3/4
2017·8
P3/3
2017·1
2015·4
2016·9
2017·4
P3/2
2016·4
A-1243
2011·160
A-1158
2056·896
A-743
2060·587
A-727
2064·758
A-684
2060·127
A-709
2072·034
A-693
2077·421
A-686
2079·534
P3/1a
2011·9
P3/1
2013·6
~~A-688~~
A-959
2080·505
~~A-708~~
A-746
2082·799
A-751
2085·373
A-732
2087·165
A-680
2092·387
462
468
474
480
486.
LIFT N° 3.
AVERAGE LIFT RL: 2017·5
AREA:
5 cm
0376- 407
RENISON LIMITED
SURVEY
SURVEY: R.N.D. & P.A.T.
DATE: 1-3-78
SCALE: 1:500
DRAWN: R.N.D.
TRACED: F.M.H.
CHECKED: F.M.H.
APPROVED
CHIEF SURVEYOR
Mine Manager.
31-12-82
Date.
DRAWING No.
90:003
2010 PENZANCE.
FILL LEVEL: 2014·6
LIFT RL: 2016·4
83170