0376-409

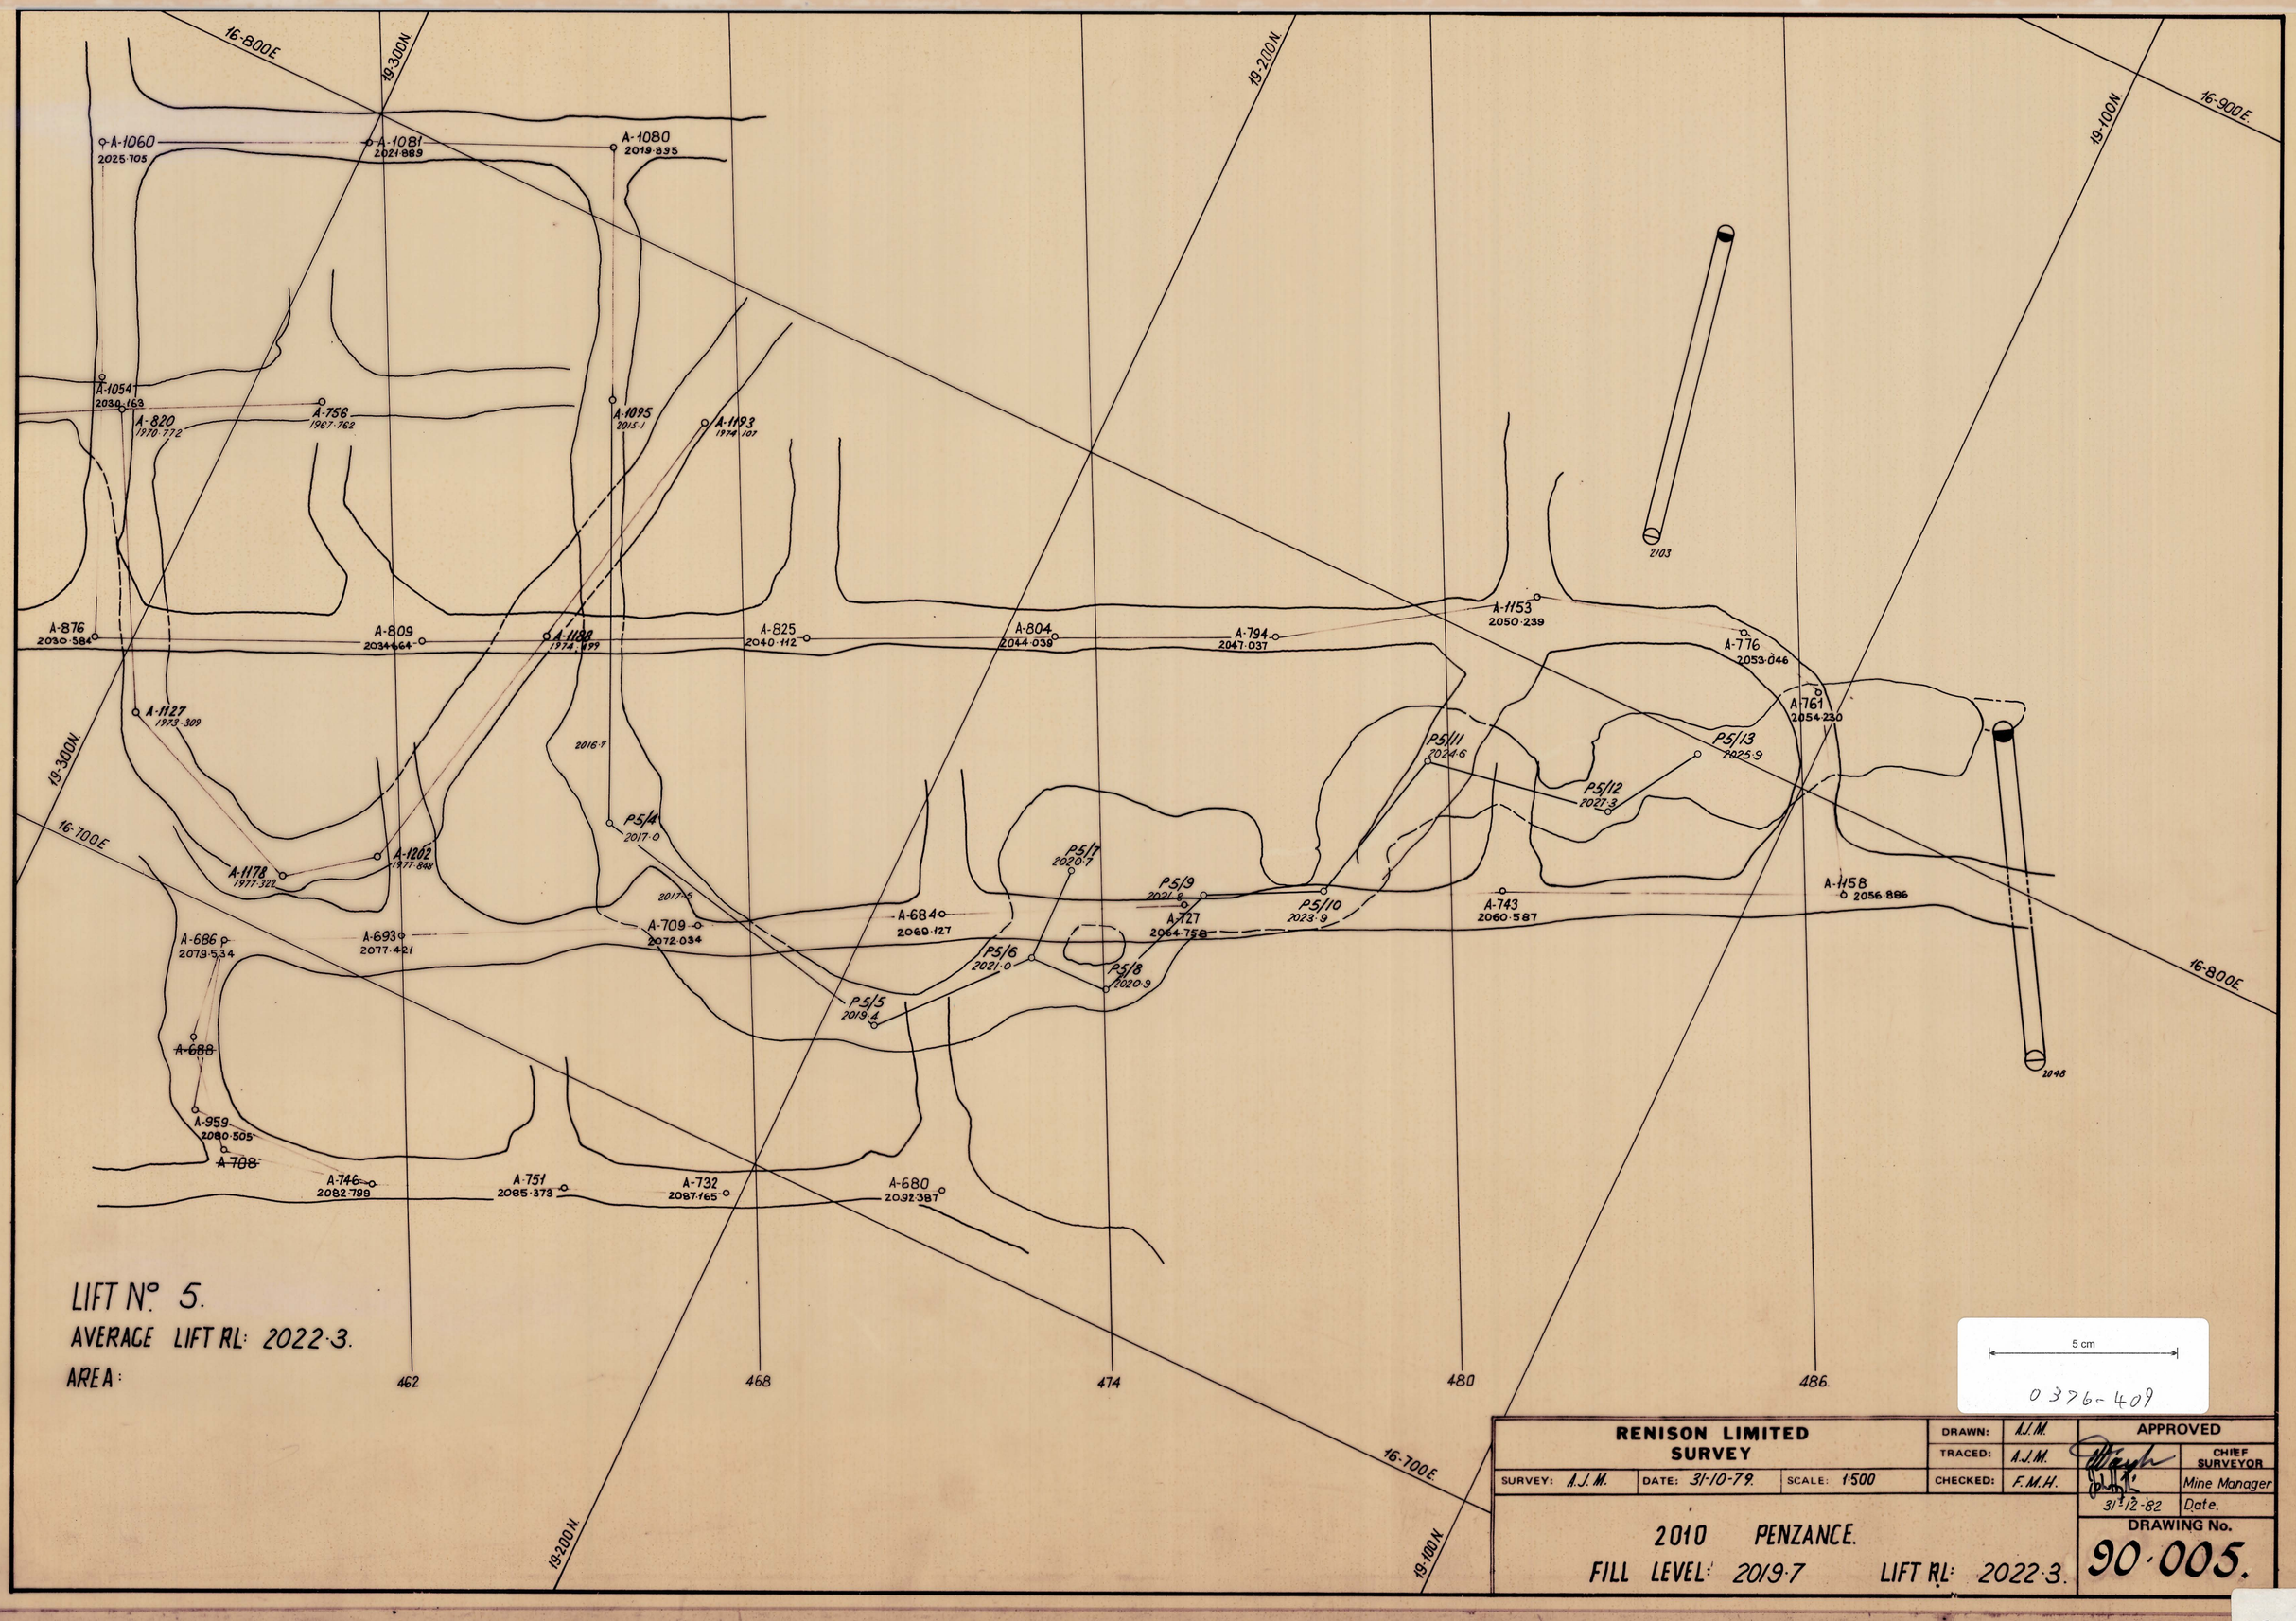

83172