0376-415

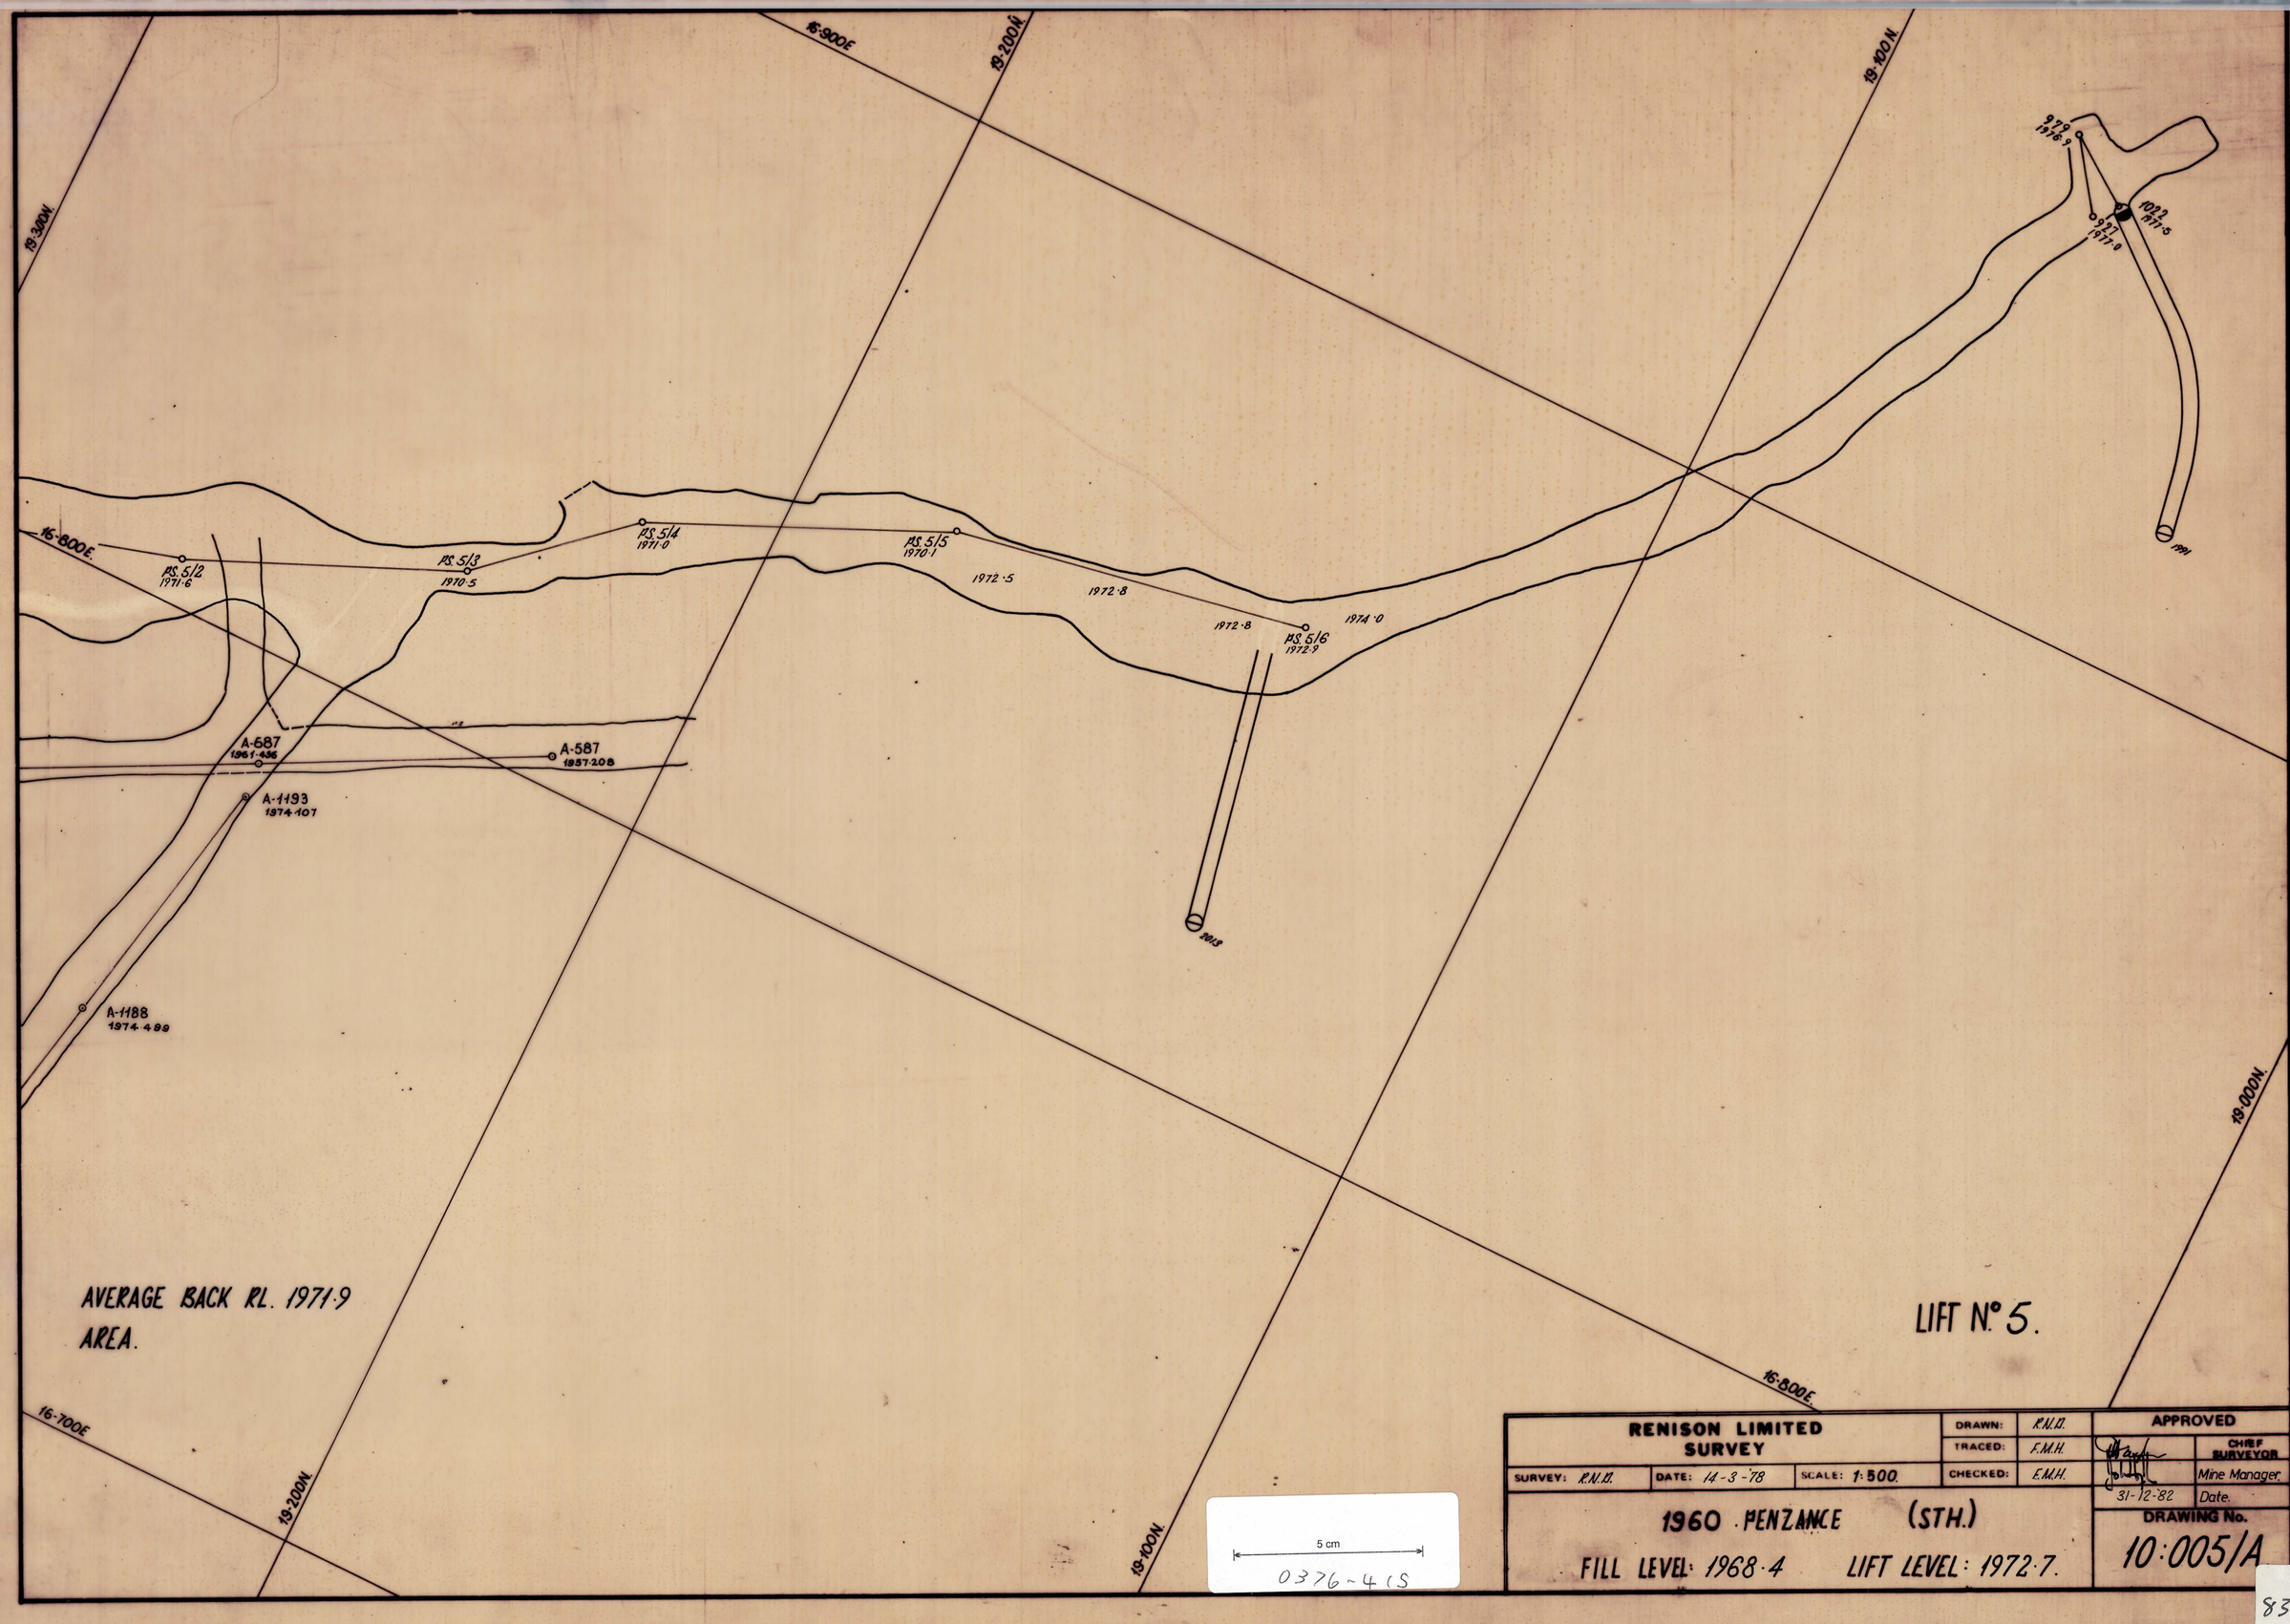

RENISON LIMITED SURVEY		DRAWN: R.N.D.	APPROVED	
		TRACED: F.M.H.		CHIEF SURVEYOR
SURVEY: R.N.D.	DATE: 14-3-78	SCALE: 1:500.	CHECKED: E.M.H.	Mine Manager.
			31-12-82	Date.
1960 PENZANCE (STH.)			DRAWING No.	
FILL LEVEL: 1968·4	LIFT LEVEL: 1972·7.		10:005/A	

83181