0376-417

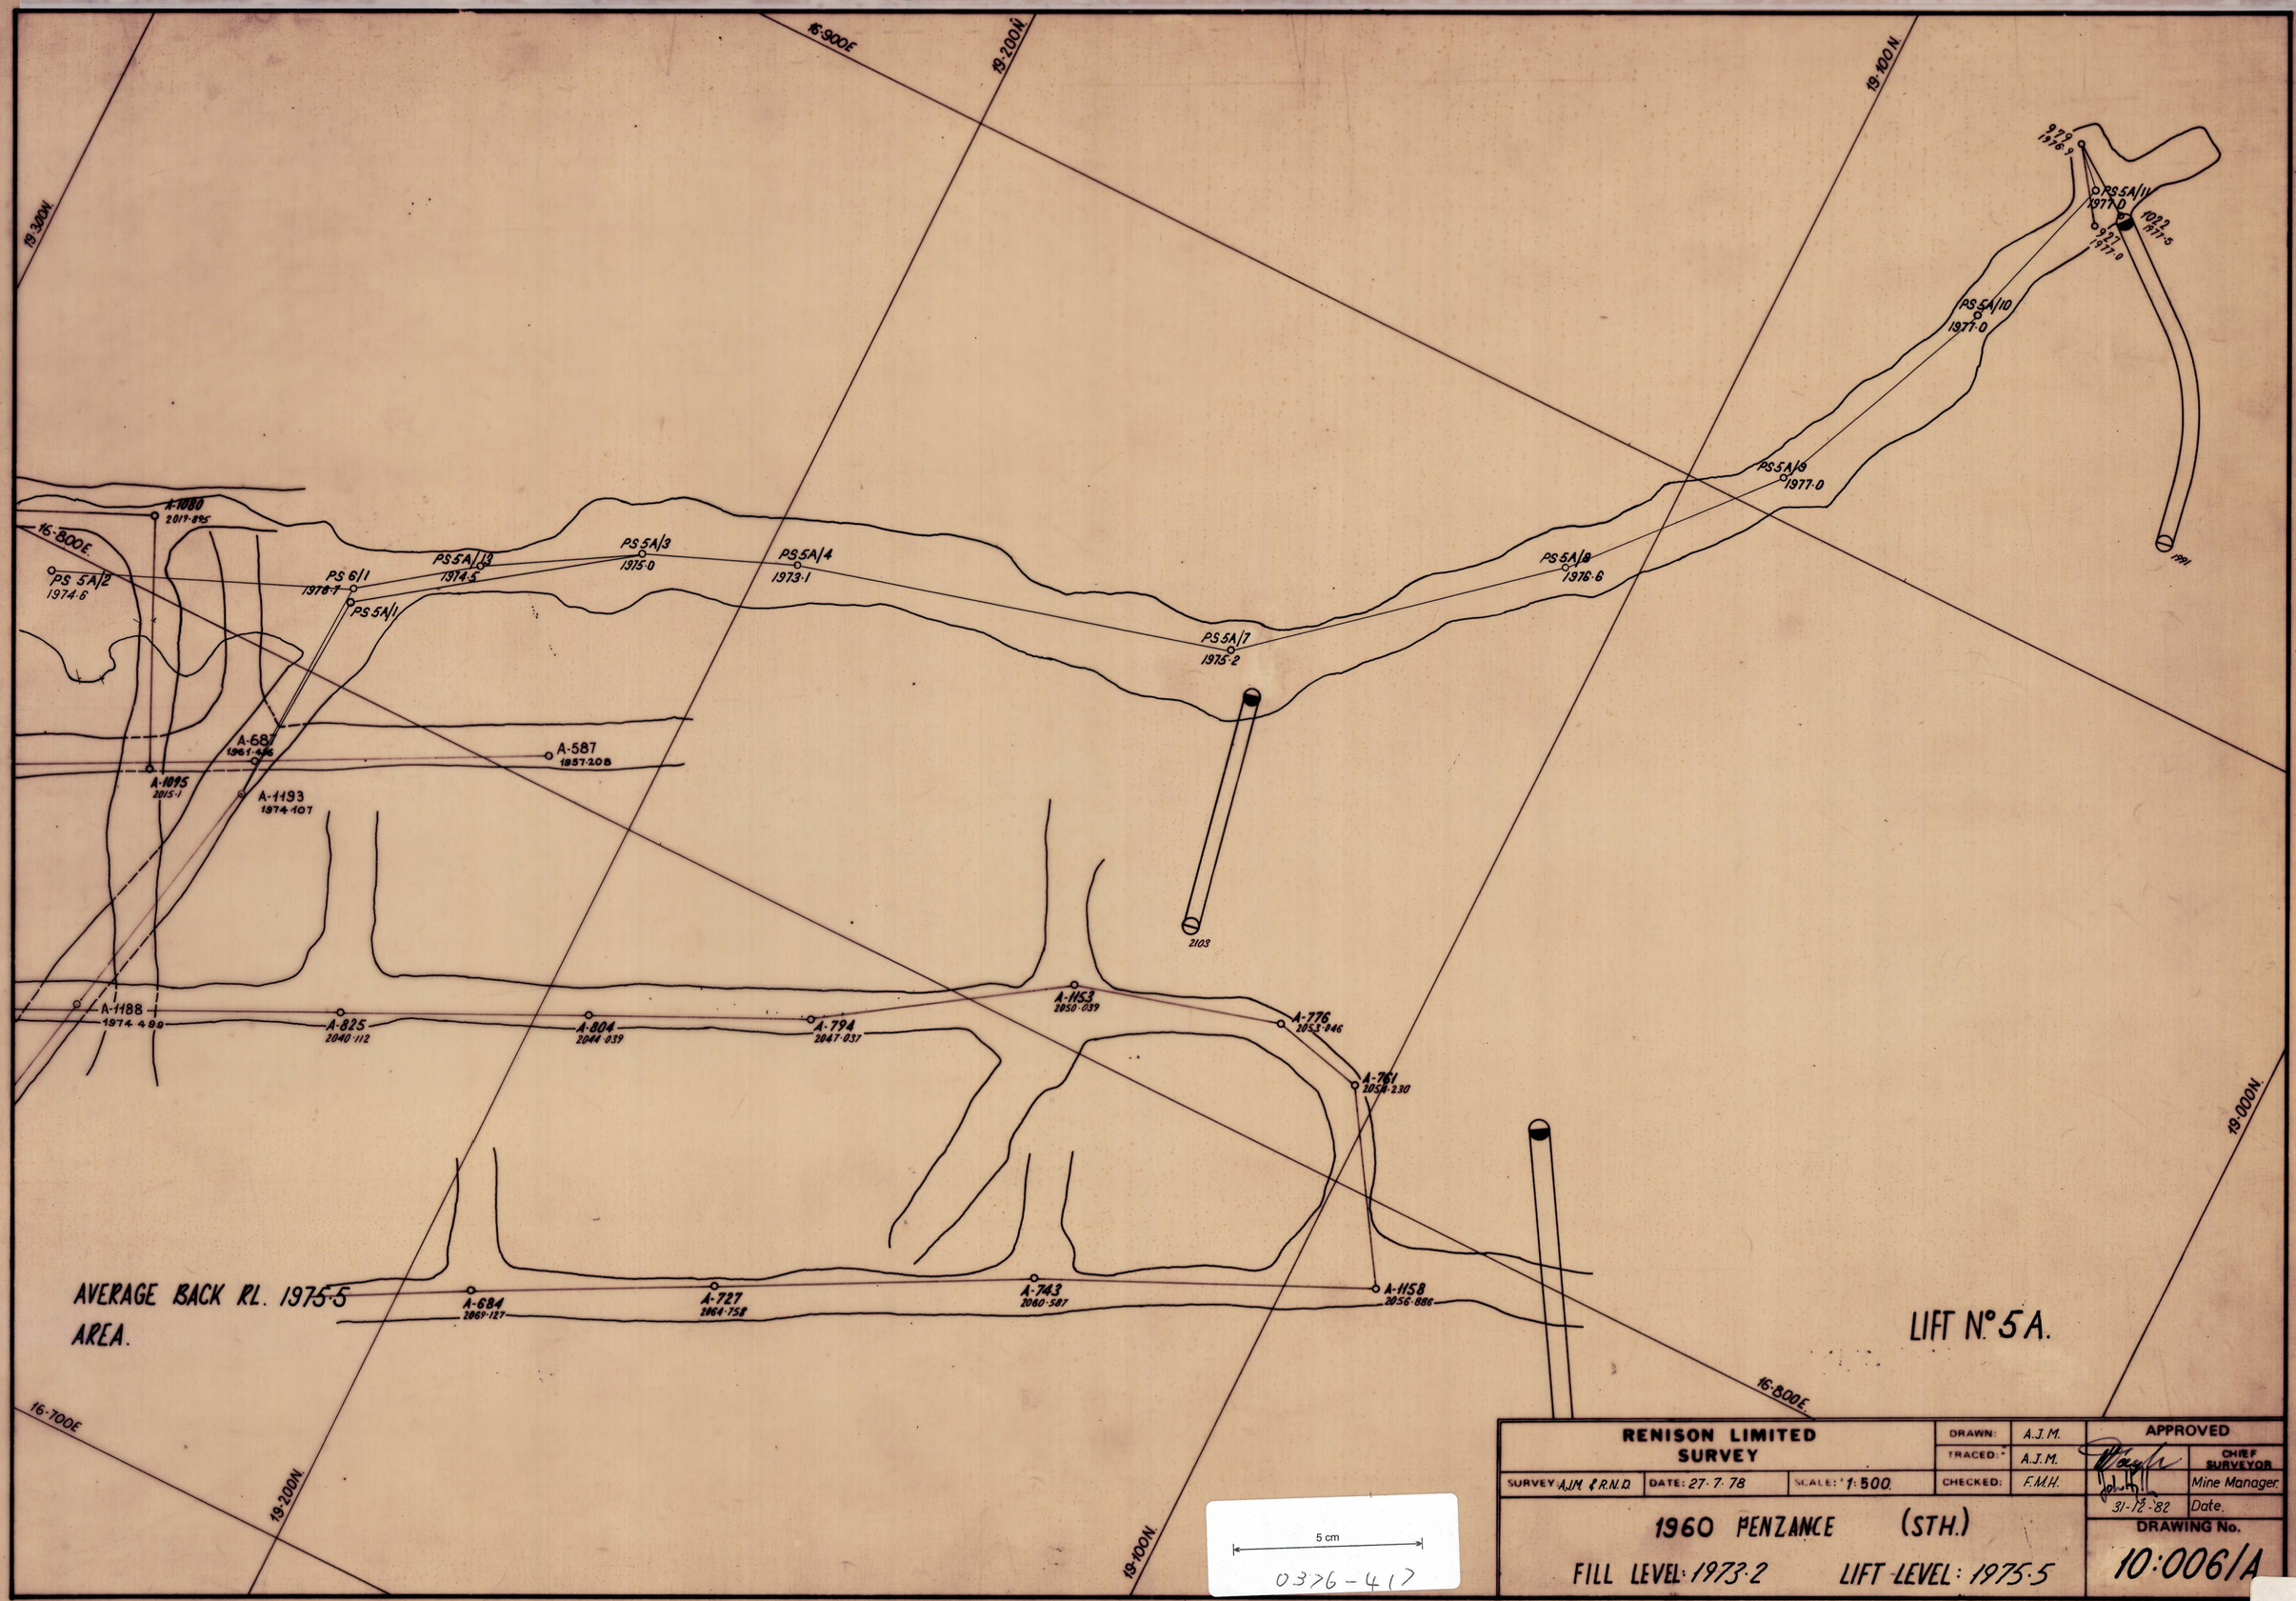

RENISON LIMITED SURVEY			DRAWN:	A.J.M.	APPROVED	
			TRACED:	A.J.M.		CHIEF SURVEYOR
SURVEY A.J.M. & R.N.D.	DATE: 27·7·78	SCALE: 1:500	CHECKED:	F.M.H.		Mine Manager
					31-12-82	Date.
1960 PENZANCE (STH.)					DRAWING No.	
FILL LEVEL: 1973·2		LIFT LEVEL: 1975·5			10:0061A	

83183