0376 - 418

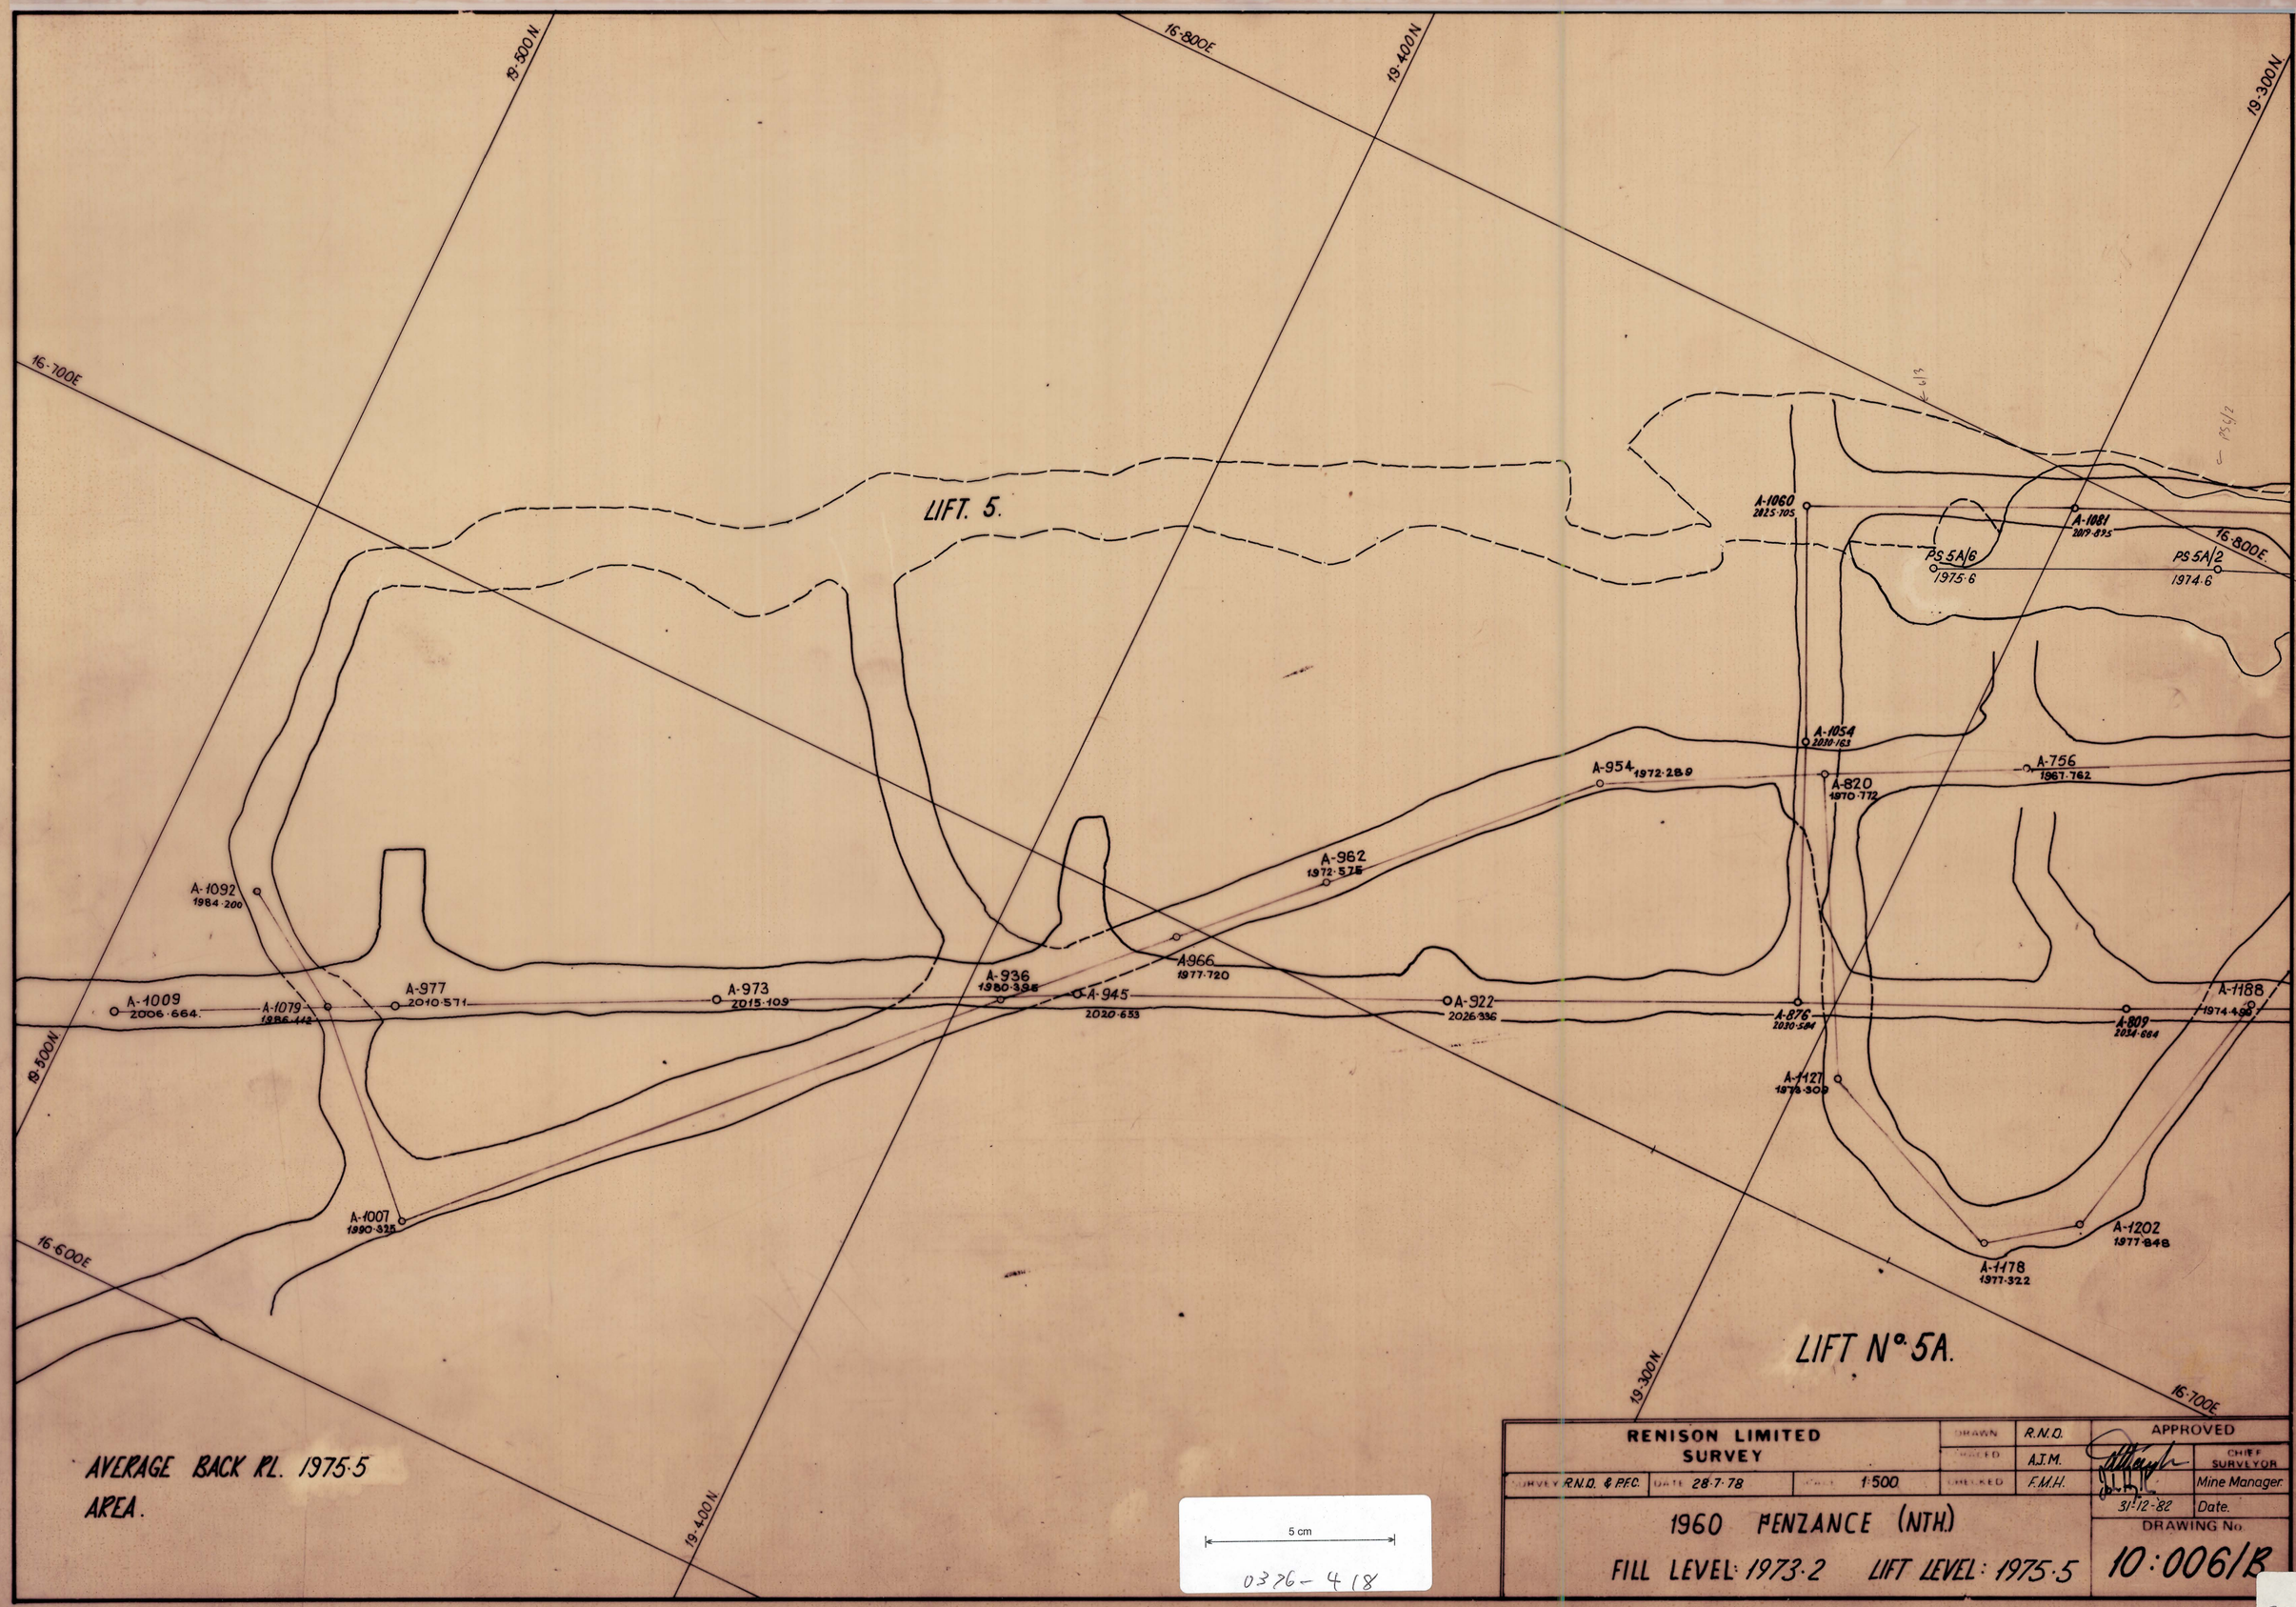

RENISON LIMITED SURVEY		DRAWN	R.N.O.	APPROVED
		TRACED	A.J.M.	CHIEF SURVEYOR
SURVEY R.N.O. & P.F.C.	DATE 28-7-78	SCALE 1:500	CHECKED F.M.H.	Mine Manager
1960 PENZANCE (NTH.)				31-12-82 Date.
FILL LEVEL: 1973·2	LIFT LEVEL: 1975·5			DRAWING No. 10:006/B

83184