0376-420

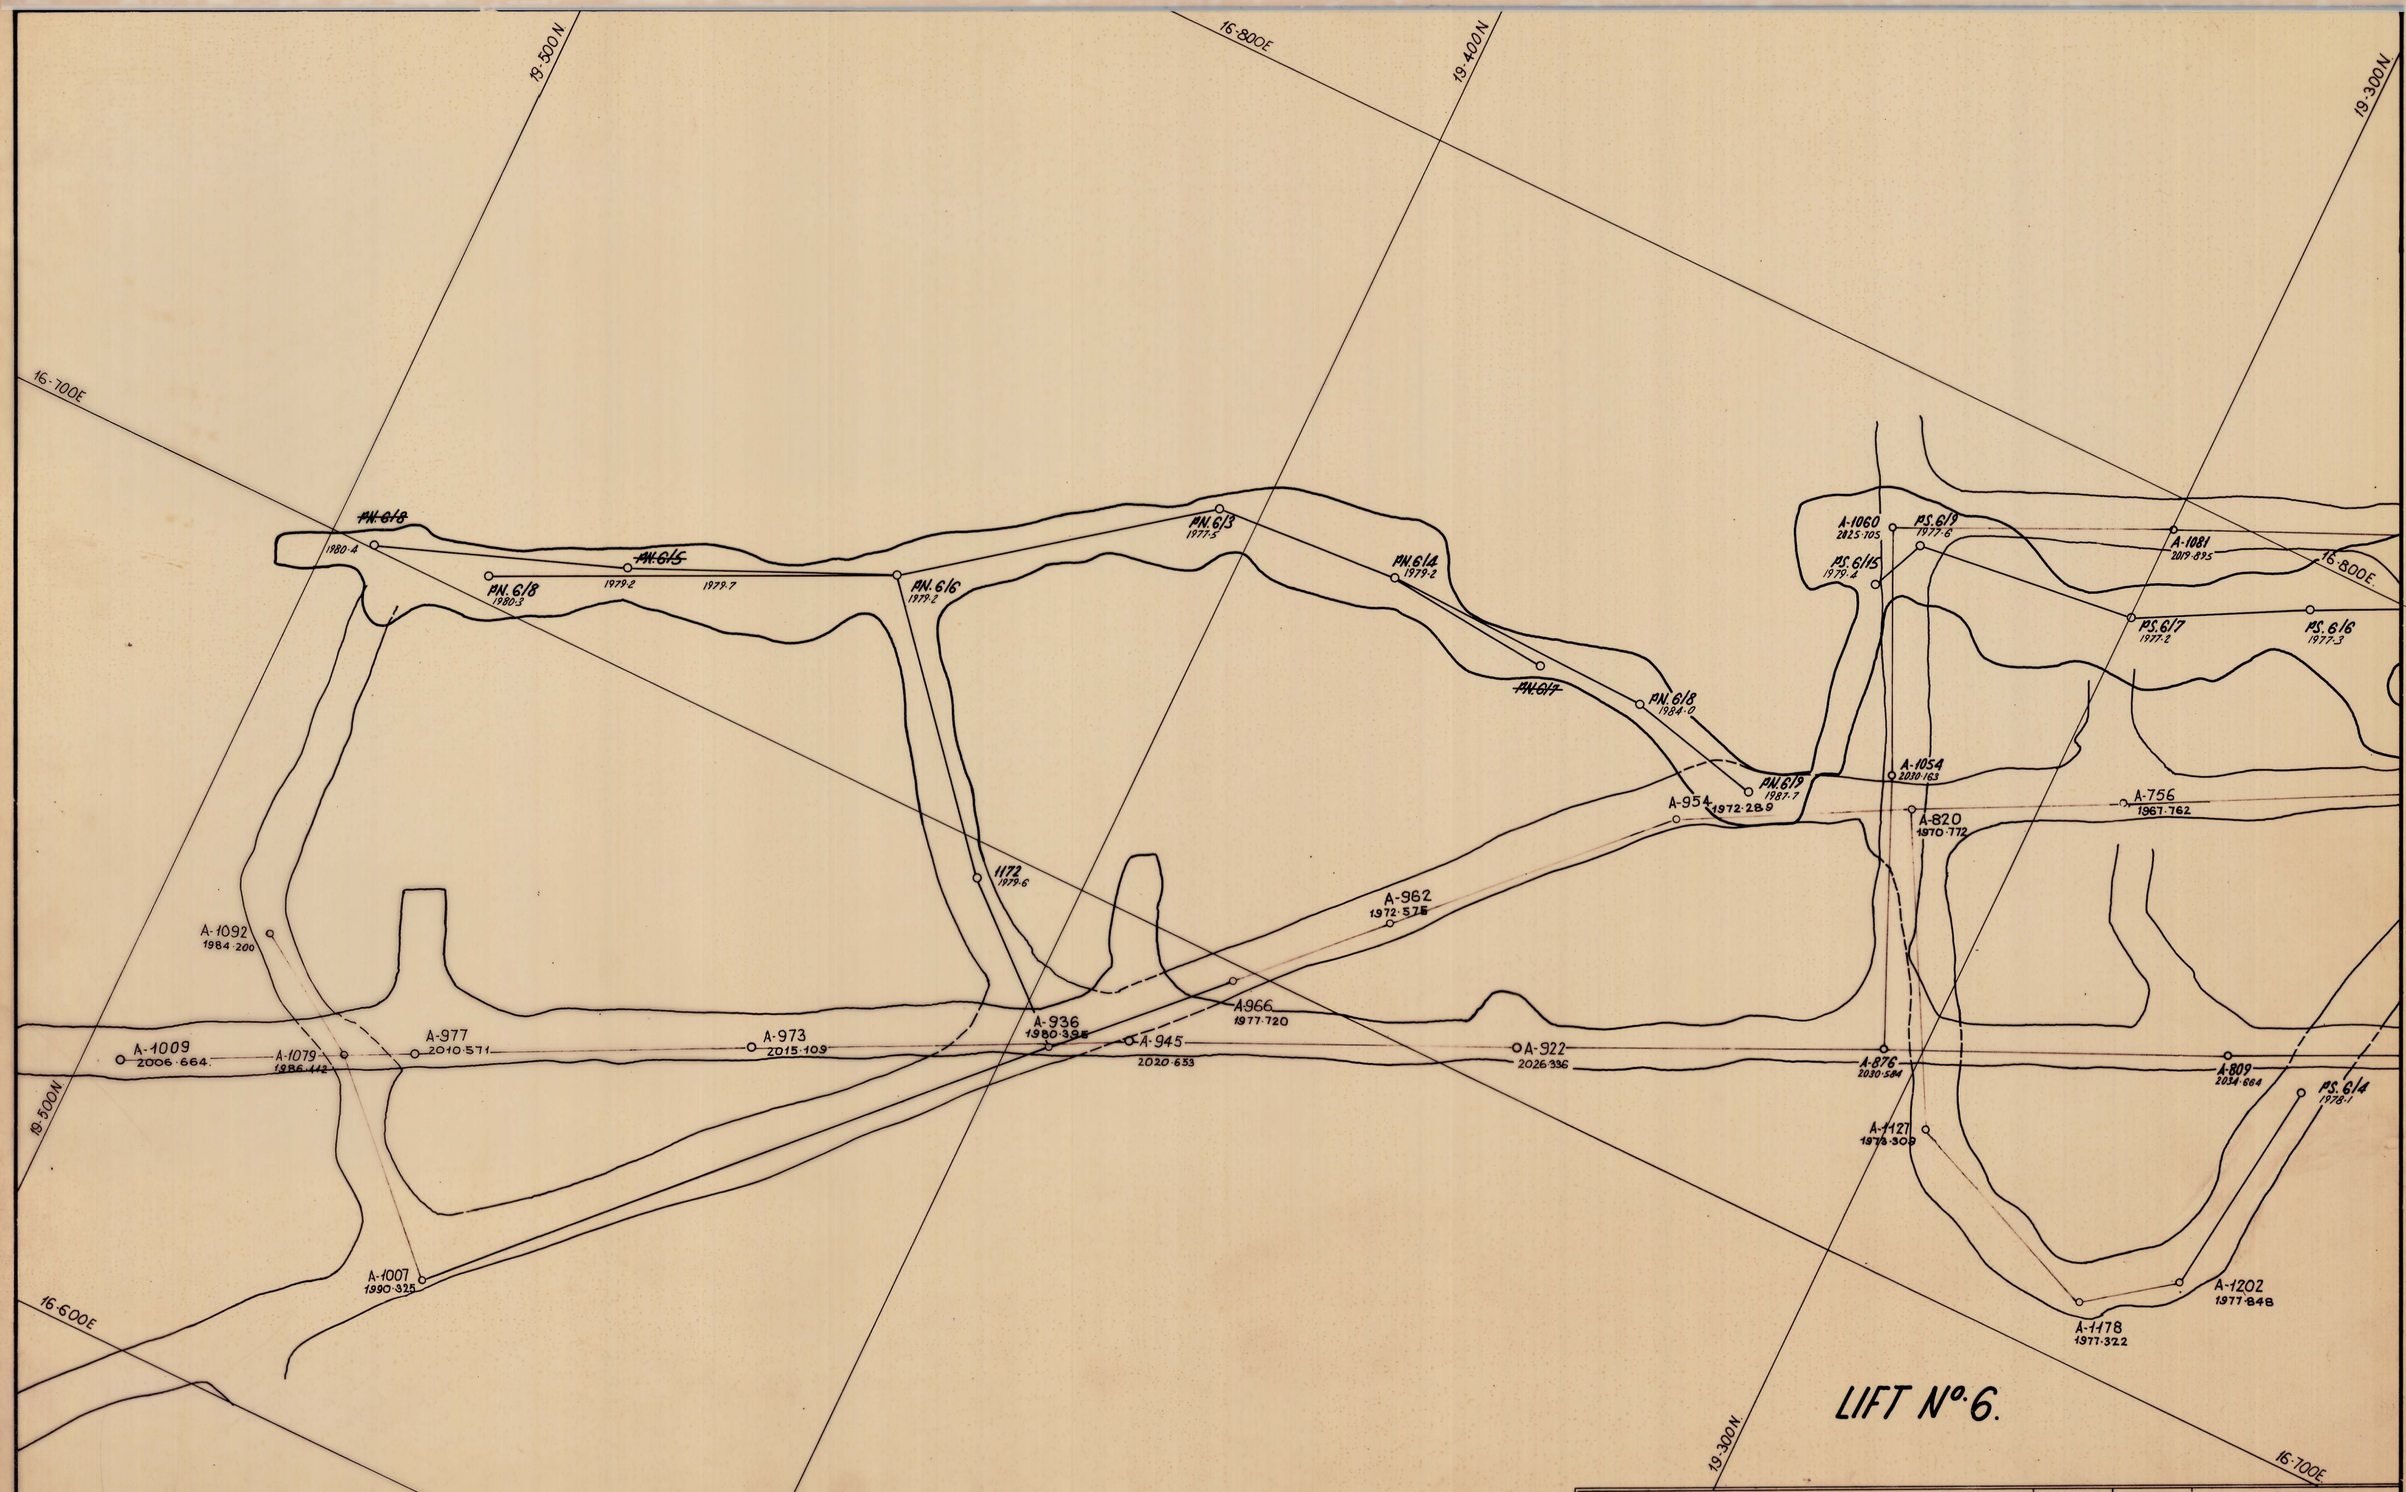

LIFT No. 6.

AVERAGE BACK RL. 1980·8.
AREA.

5 cm

0376-420

RENISON LIMITED SURVEY	DRAWN	A.J.M.	APPROVED
	PLOTTED	F.M.H.	CHIEF SURVEYOR
SURVEY A.J.M. / DATE 26-6-'79 / SCALE 1:500	CHECKED	F.M.H.	Mine Manager.
			31-12-82 Date.
1960 PENZANCE (NTH.)			DRAWING No.
FILL LEVEL: 1977·1 LIFT LEVEL: 1980·8			10:007/B

83186