0376 - 421

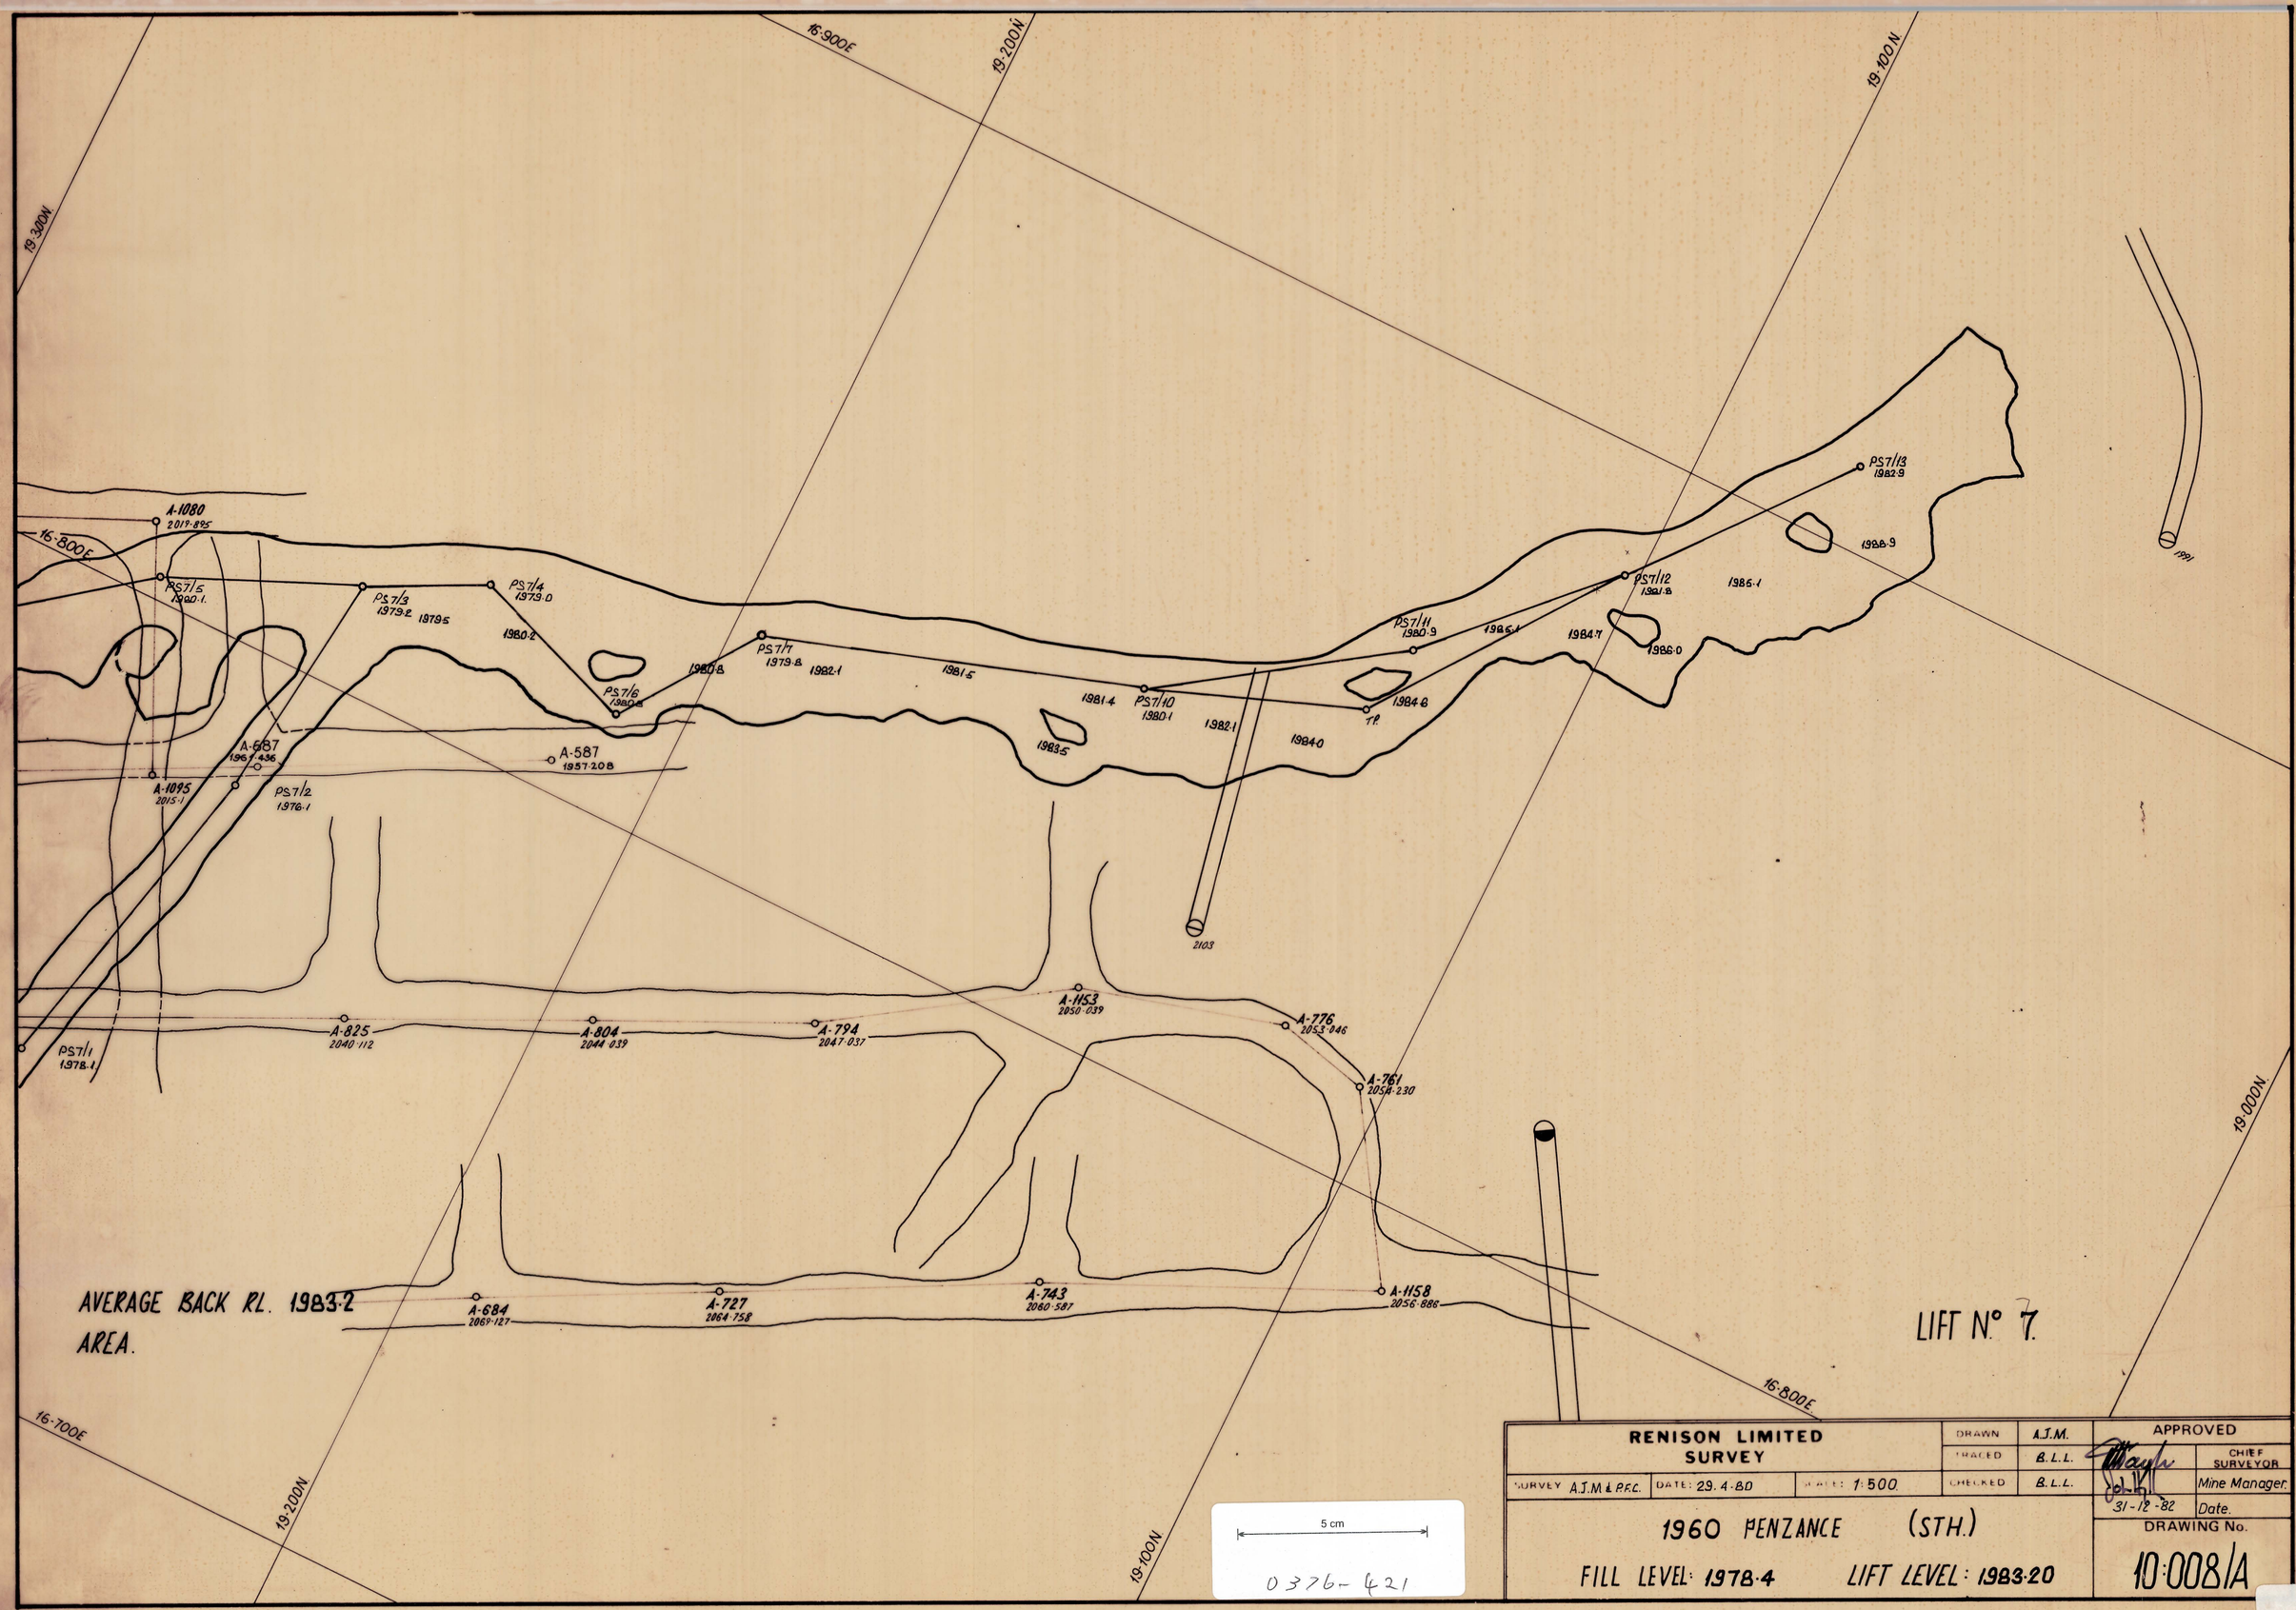

RENISON LIMITED SURVEY			DRAWN	A.J.M.	APPROVED
			TRACED	B.L.L.	CHIEF SURVEYOR
SURVEY A.J.M & P.F.C.	DATE: 29.4.80	SCALE: 1:500	CHECKED	B.L.L.	Mine Manager.
					31-12-82 Date.
1960 PENZANCE (STH.)					DRAWING No.
FILL LEVEL: 1978·4		LIFT LEVEL: 1983·20			10·008/A

0376-421

83187