0376-424

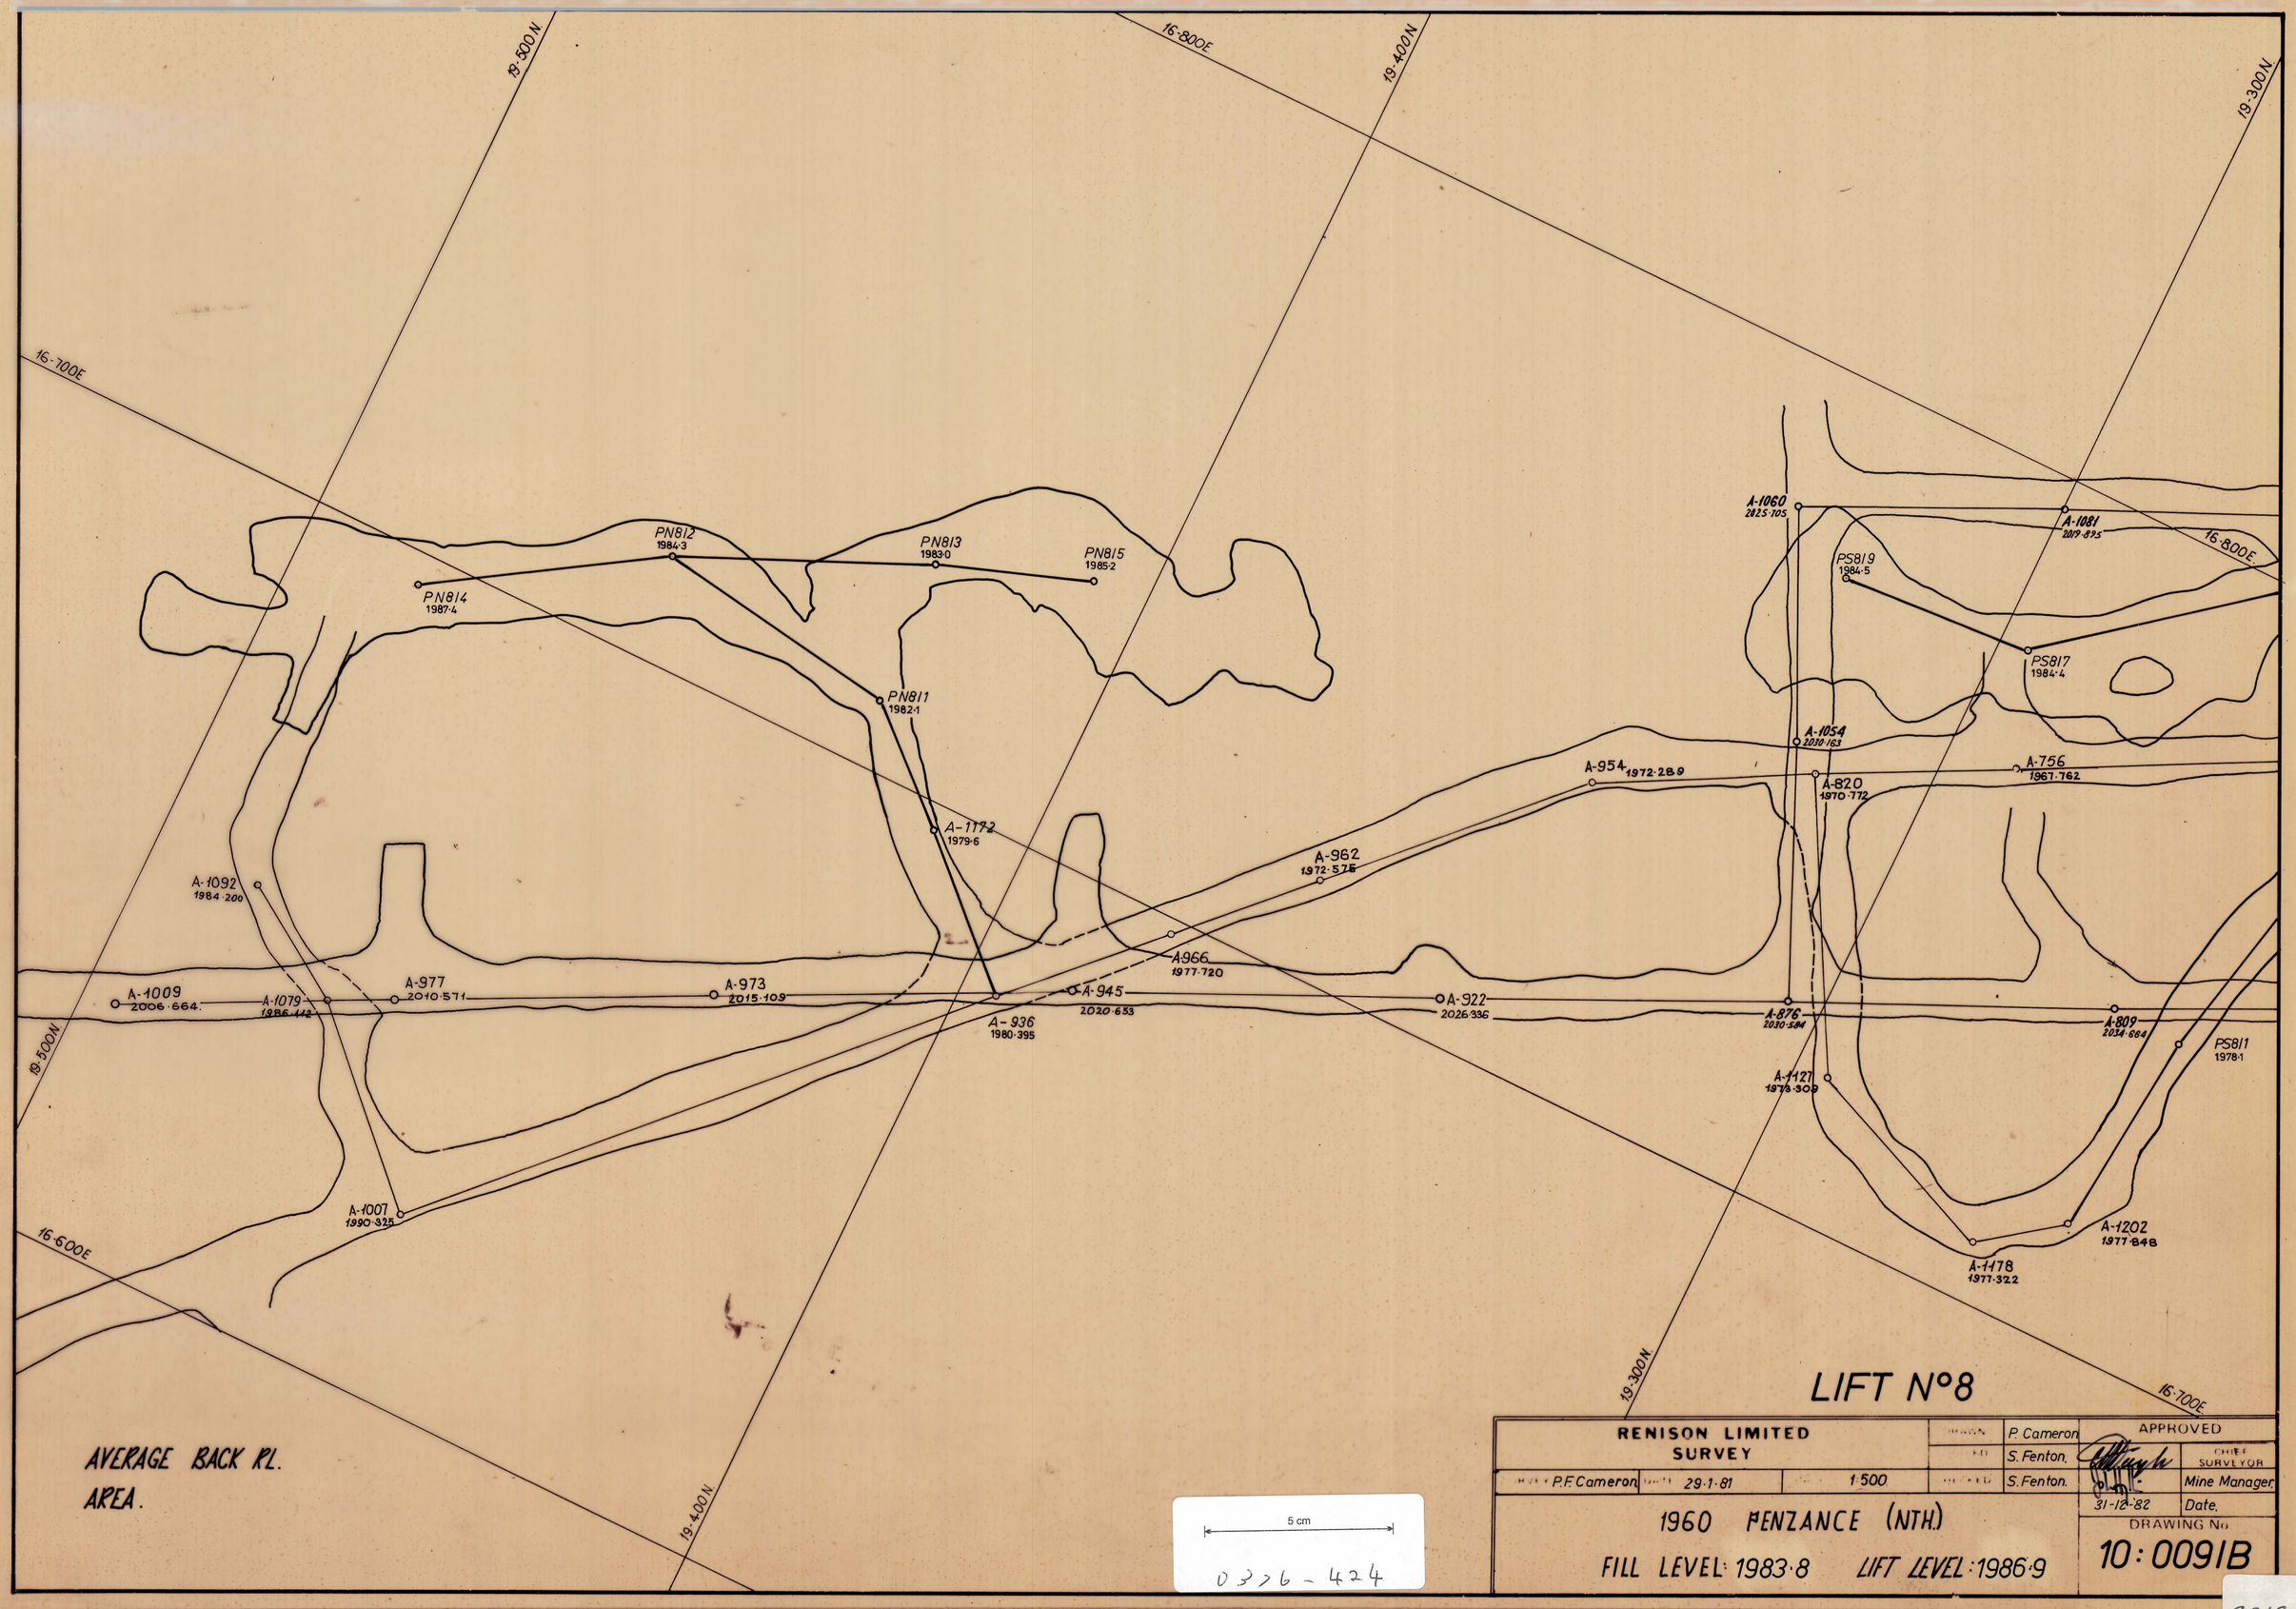

LIFT N°8

RENISON LIMITED SURVEY	DRAWN P. Cameron		APPROVED
	CKD S. Fenton.		CHIEF SURVEYOR
DRAWN P.F. Cameron DATE 29·1·81	SCALE 1:500	CHECKED S. Fenton.	Mine Manager
			31-12-82 Date.
1960 PENZANCE (NTH.)			DRAWING No
FILL LEVEL: 1983·8	LIFT LEVEL: 1986·9		10:0091B

0376-424

83190