0376 - 430

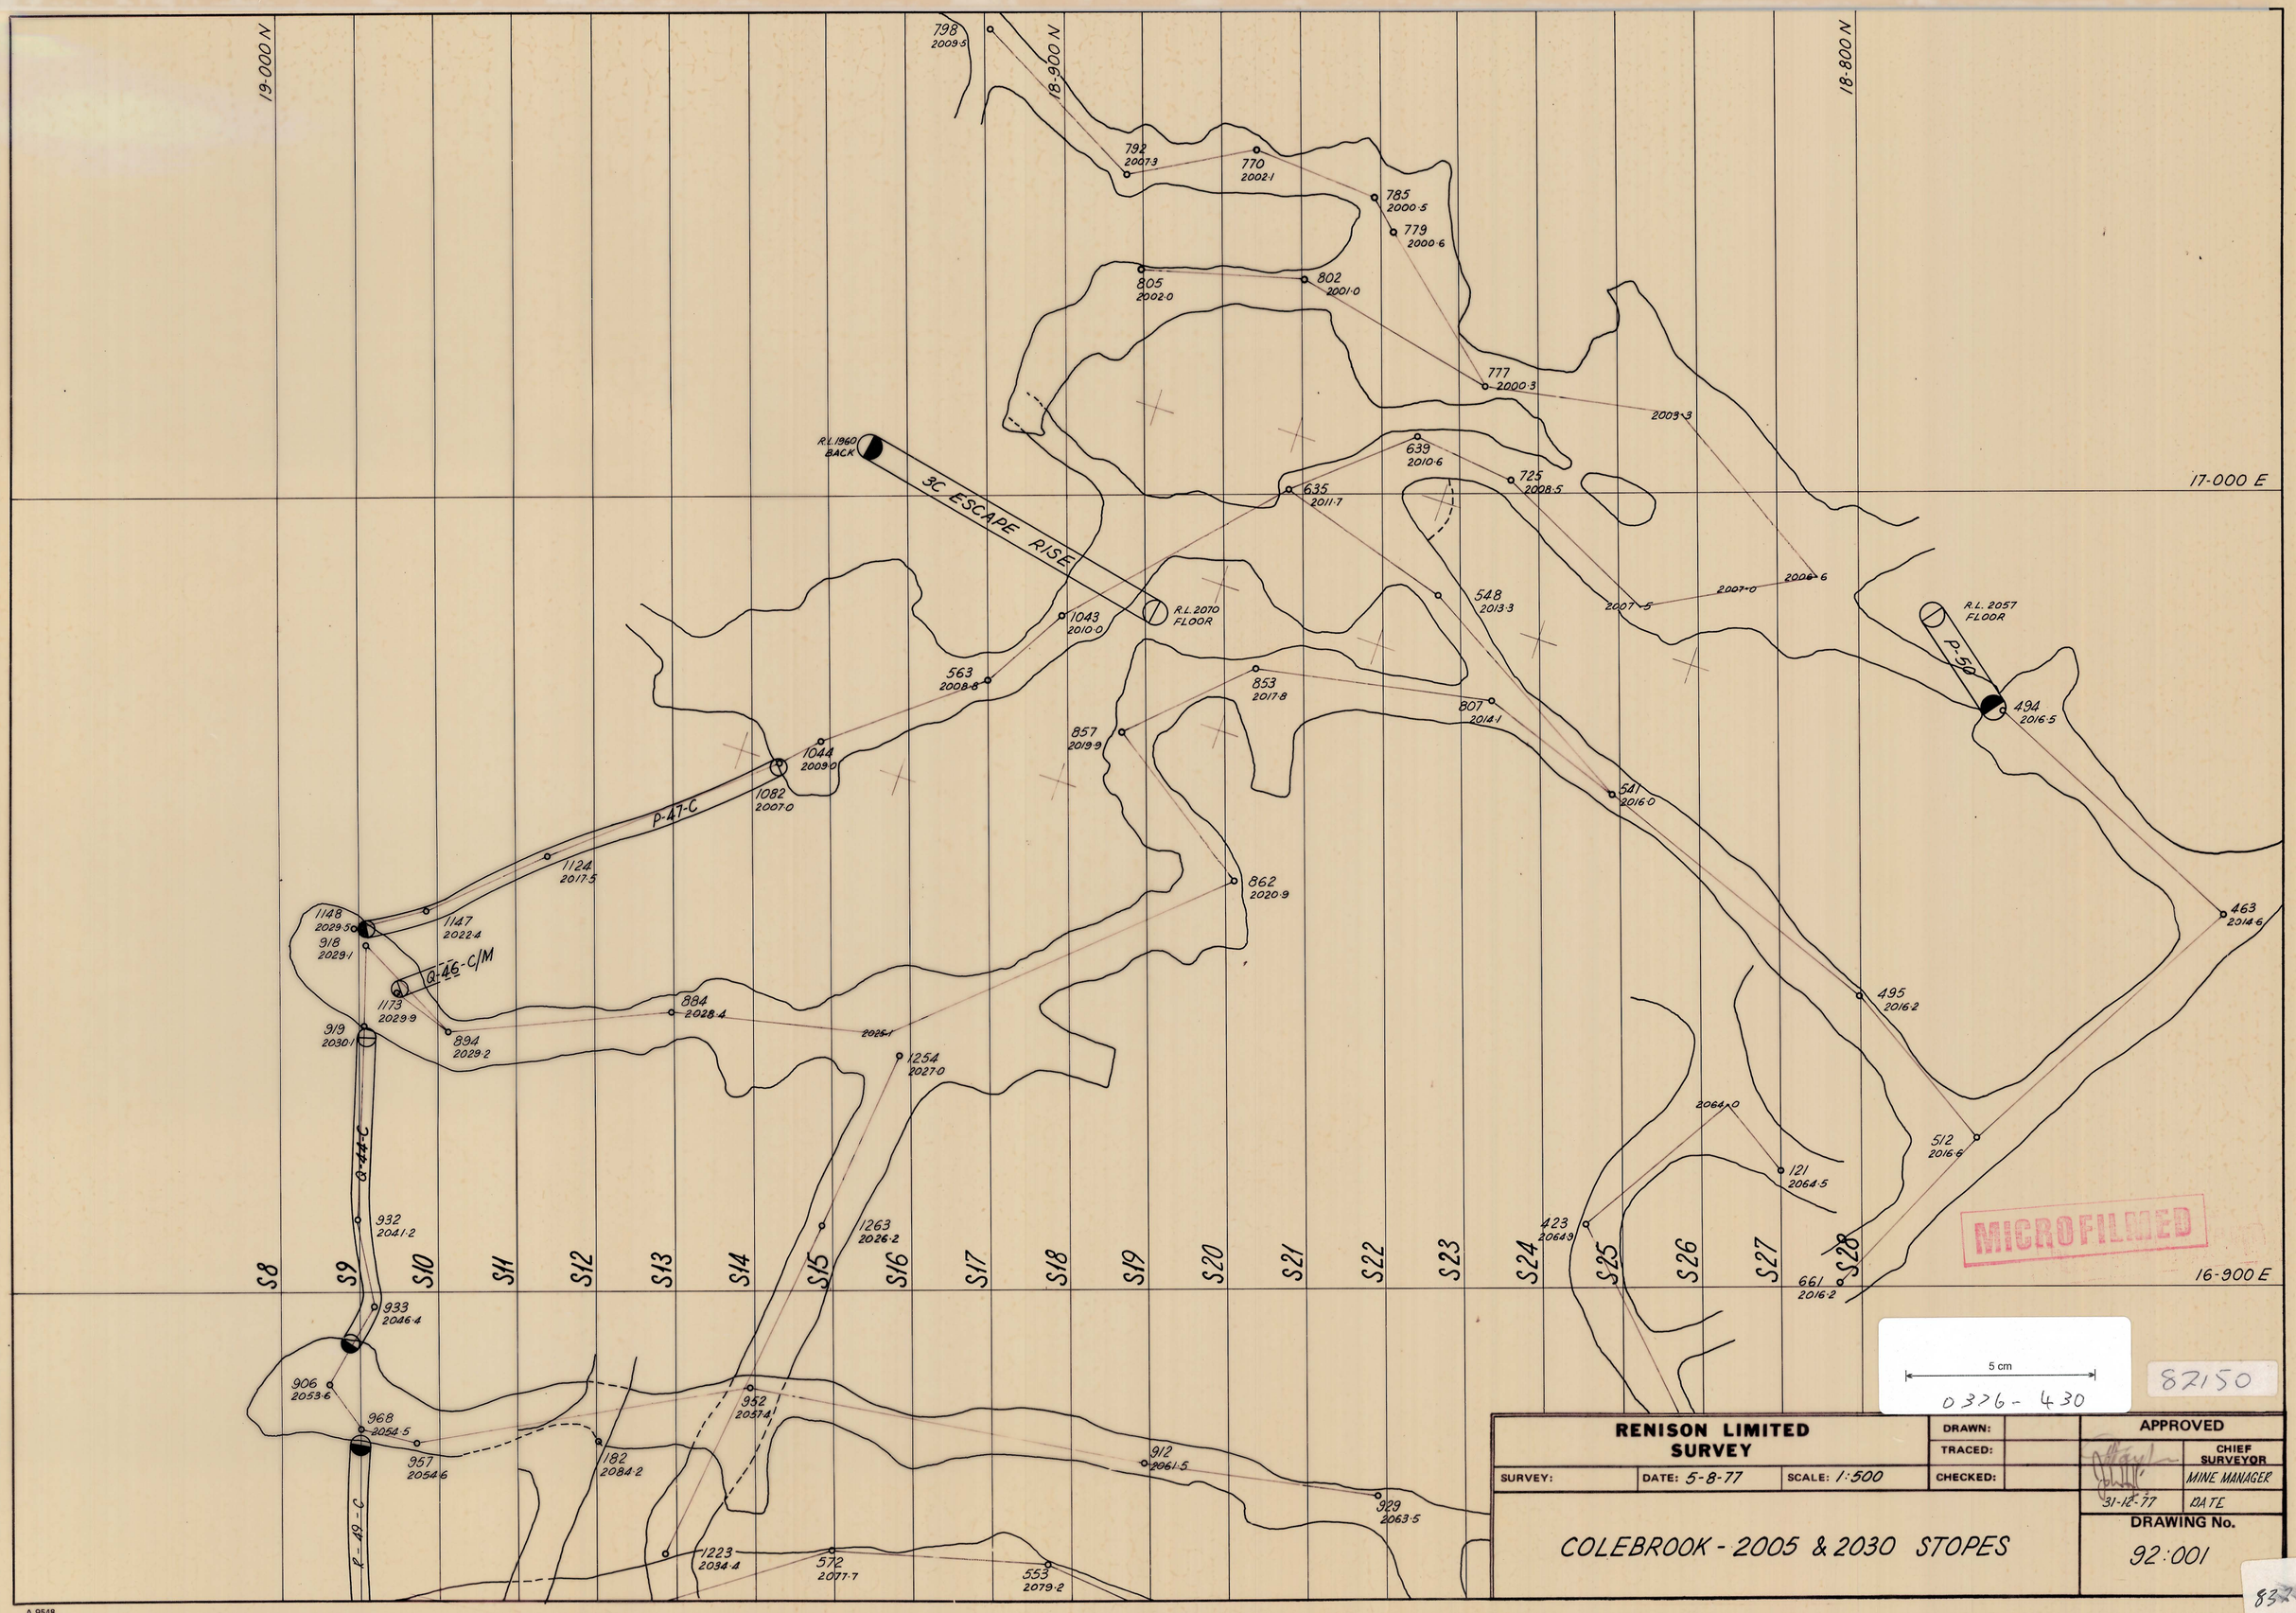
19-000 N
18-900 N
18-800 N
17-000 E
16-900 E
S8
S9
S10
S11
S12
S13
S14
S15
S16
S17
S18
S19
S20
S21
S22
S23
S24
S25
S26
S27
S28
3C ESCAPE RISE
R.L. 1960 BACK
R.L. 2070 FLOOR
R.L. 2057 FLOOR
P-47-C
Q-46-C/M
Q-44-C
P-49-C
P-50
798 2009·5
792 2007·3
770 2002·1
785 2000·5
779 2000·6
805 2002·0
802 2001·0
777 2000·3
2008·3
639 2010·6
635 2011·7
725 2008·5
548 2013·3
2007·5
2007·0
2006·6
1043 2010·0
563 2008·8
853 2017·8
807 2014·1
857 2019·9
1044 2009·0
1082 2007·0
541 2016·0
1124 2017·5
862 2020·9
1148 2029·5
1147 2022·4
918 2029·1
1173 2029·9
884 2028·4
894 2029·2
919 2030·1
2025·1
1254 2027·0
463 2014·6
495 2016·2
2064·0
121 2064·5
512 2016·6
932 2041·2
1263 2026·2
423 2064·9
661 2016·2
933 2046·4
906 2053·6
968 2054·5
957 2054·6
952 2057·4
182 2084·2
912 2061·5
929 2063·5
1223 2034·4
572 2077·7
553 2079·2
MICROFILMED
5 cm
0376 - 430
82150
RENISON LIMITED
SURVEY
DRAWN:
TRACED:
CHECKED:
SURVEY:
DATE: 5-8-77
SCALE: 1:500
APPROVED
CHIEF SURVEYOR
MINE MANAGER
31-12-77
DATE
COLEBROOK - 2005 & 2030 STOPES
DRAWING No.
92:001
A 9548
83214