0376-433

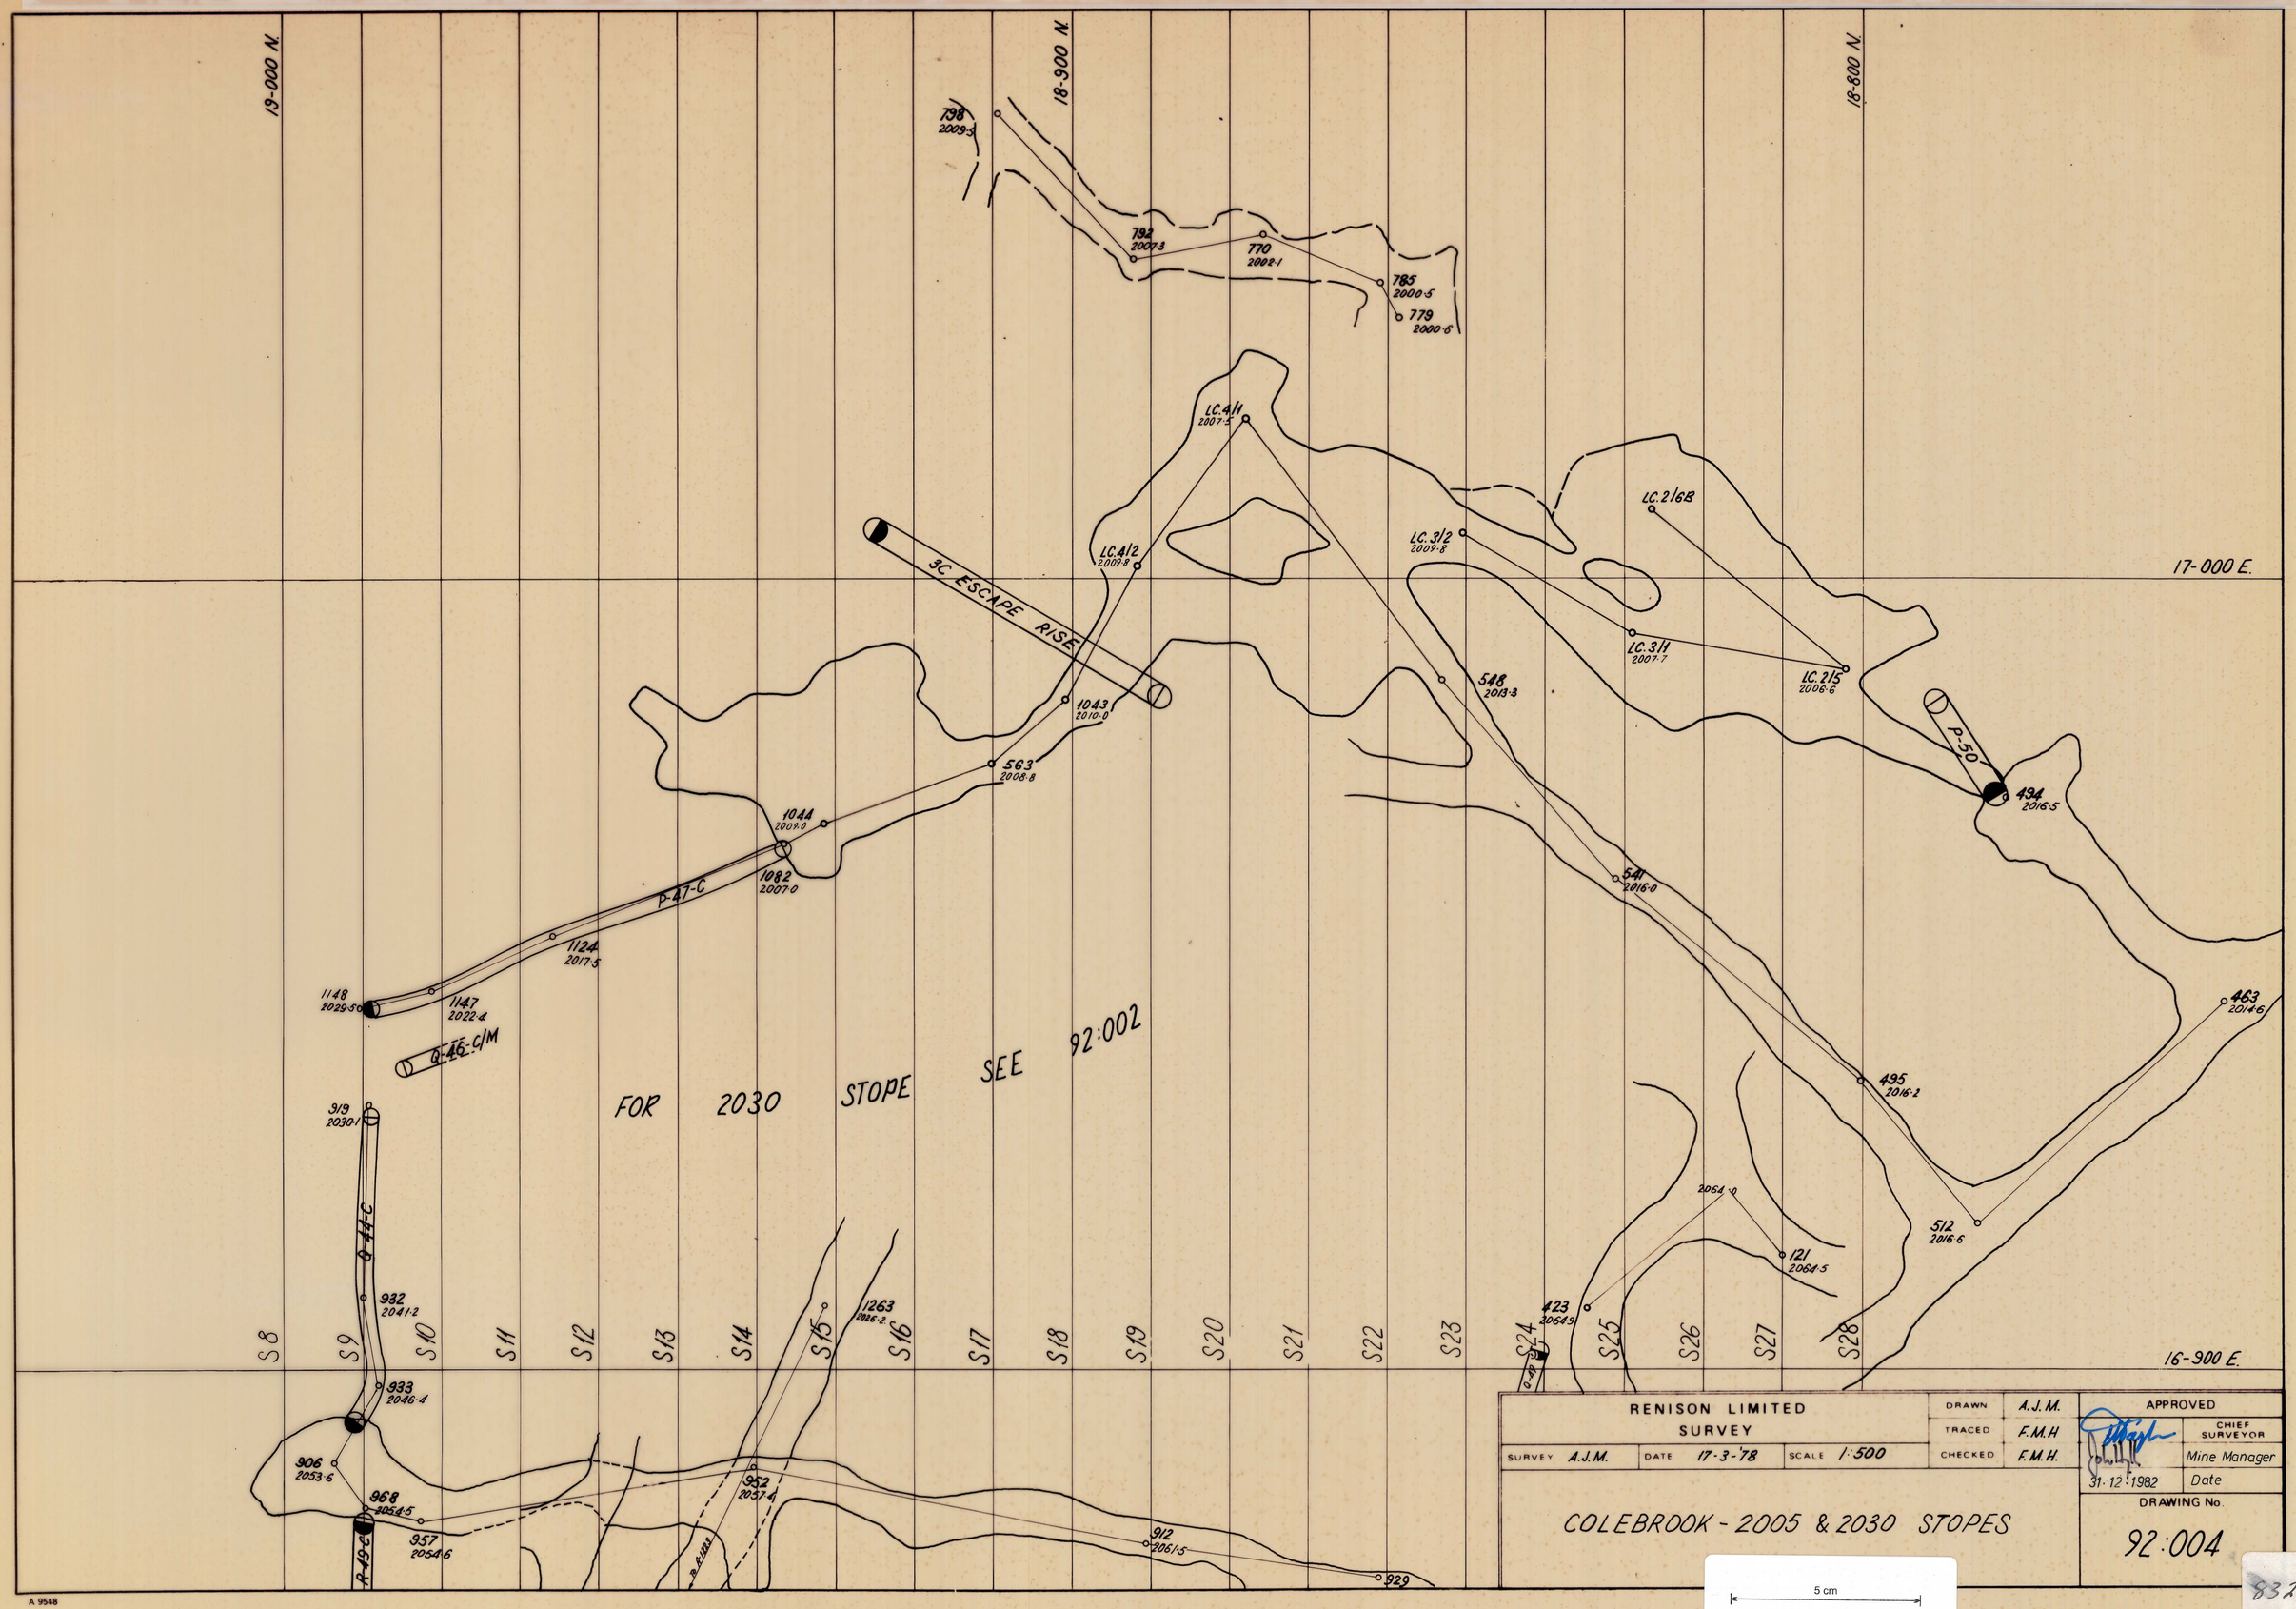

0376-433

83217