0376 - 437

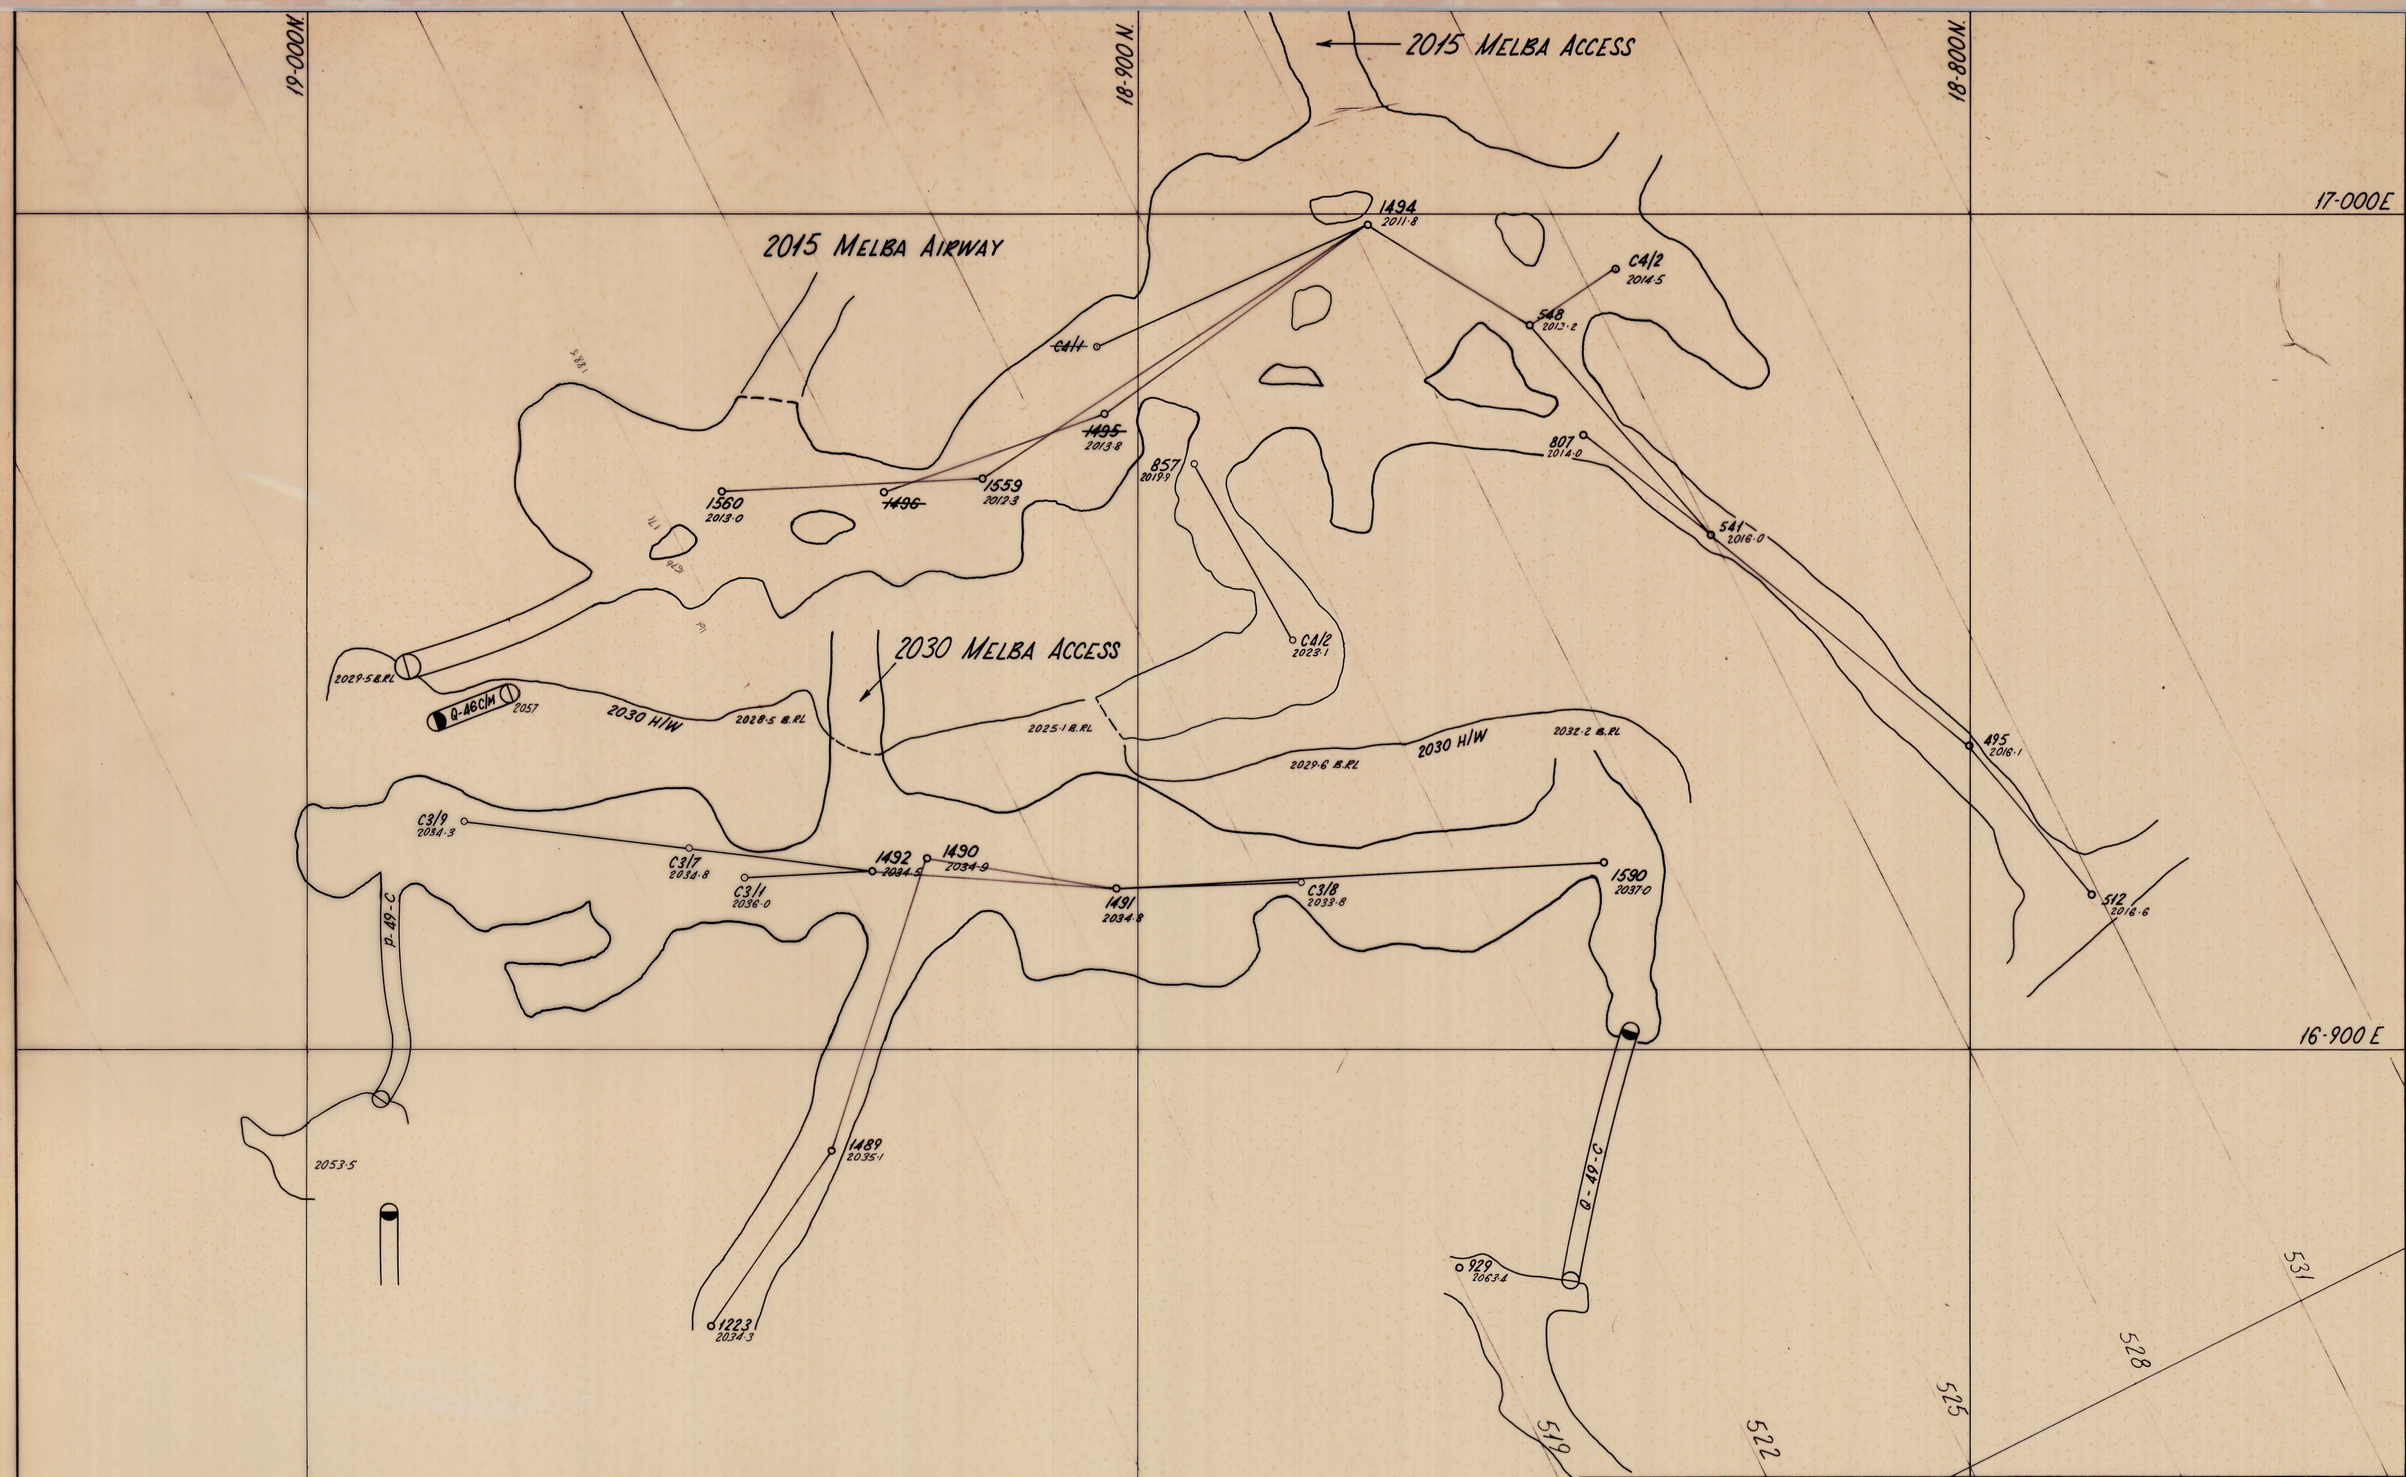

RENISON LIMITED SURVEY			DRAWN	A.J.M.	APPROVED	
			TRACED	A.J.M.		CHIEF SURVEYOR
SURVEY A.J.M.	DATE 21·12·79	SCALE 1:500	CHECKED	F.M.H.		Mine Manager
					31·12·1982	Date.
2005 & 2030 COLEBROOK					DRAWING No. 92:008.	

83221