0376- 441

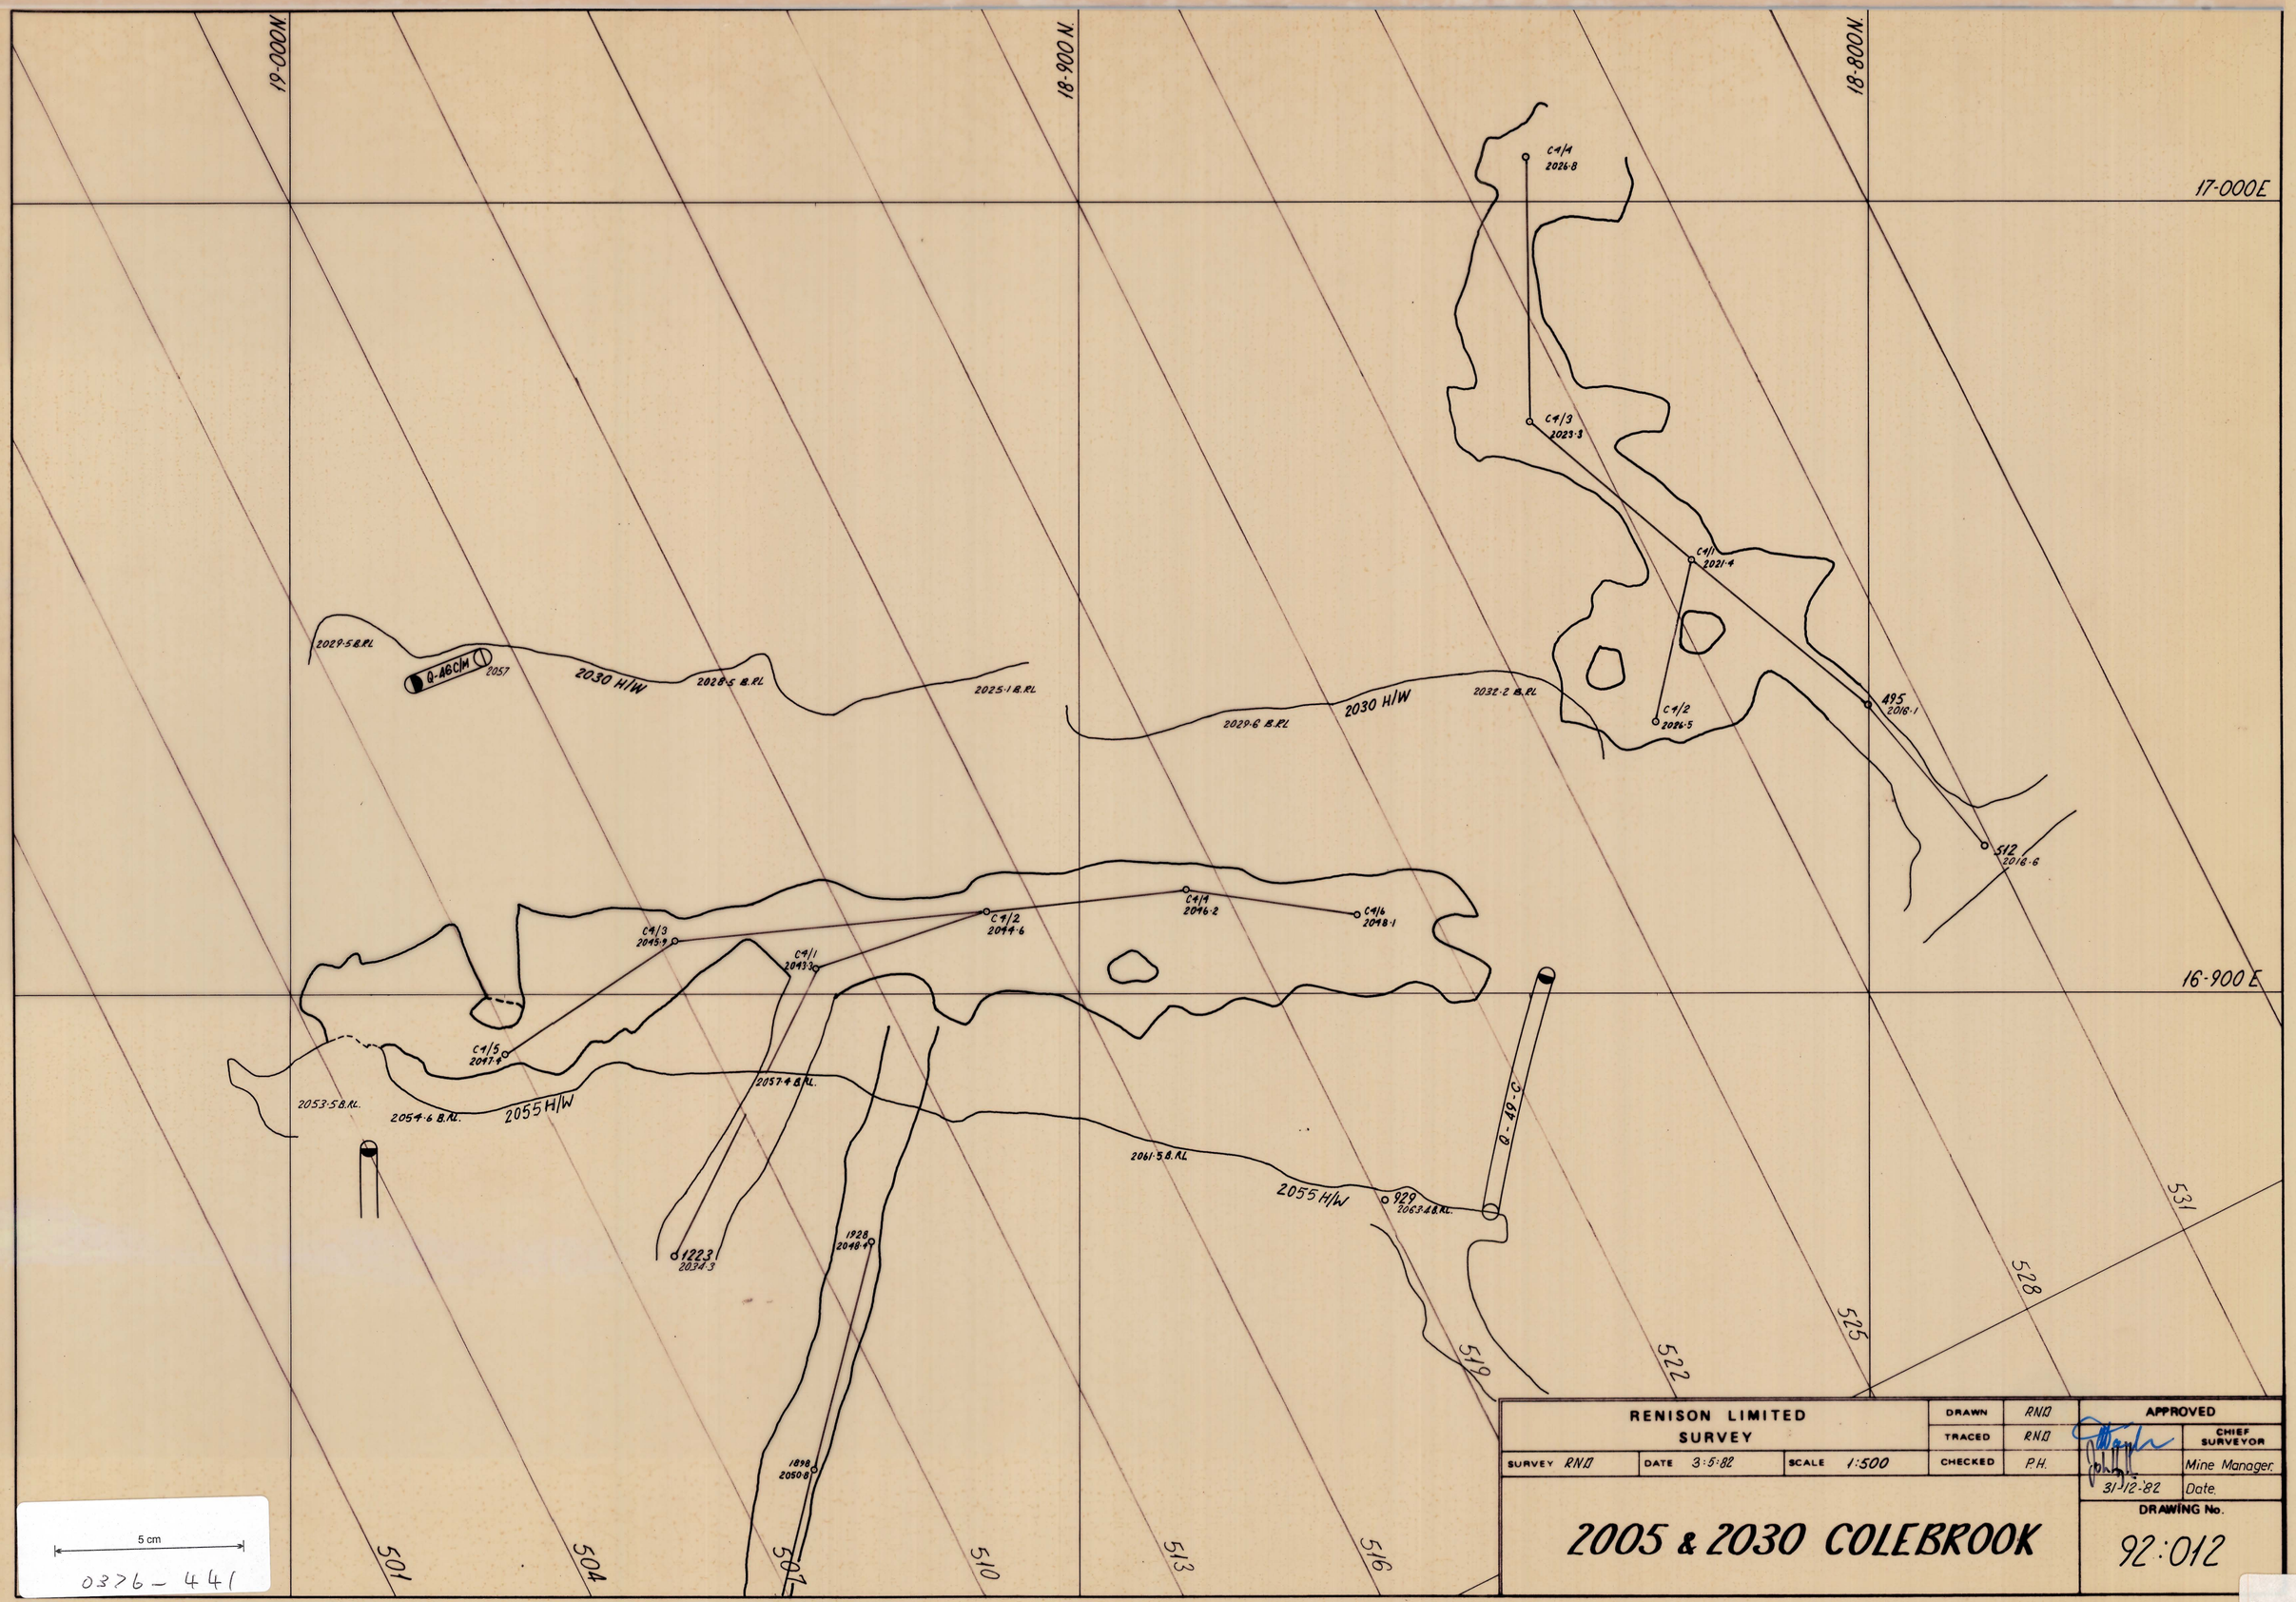

RENISON LIMITED SURVEY			DRAWN	RNO	APPROVED
			TRACED	RNO	CHIEF SURVEYOR
SURVEY RNO	DATE 3·5·82	SCALE 1:500	CHECKED	P.H.	Mine Manager.
					31·12·82 Date.

2005 & 2030 COLEBROOK

DRAWING No. 92:012

83225