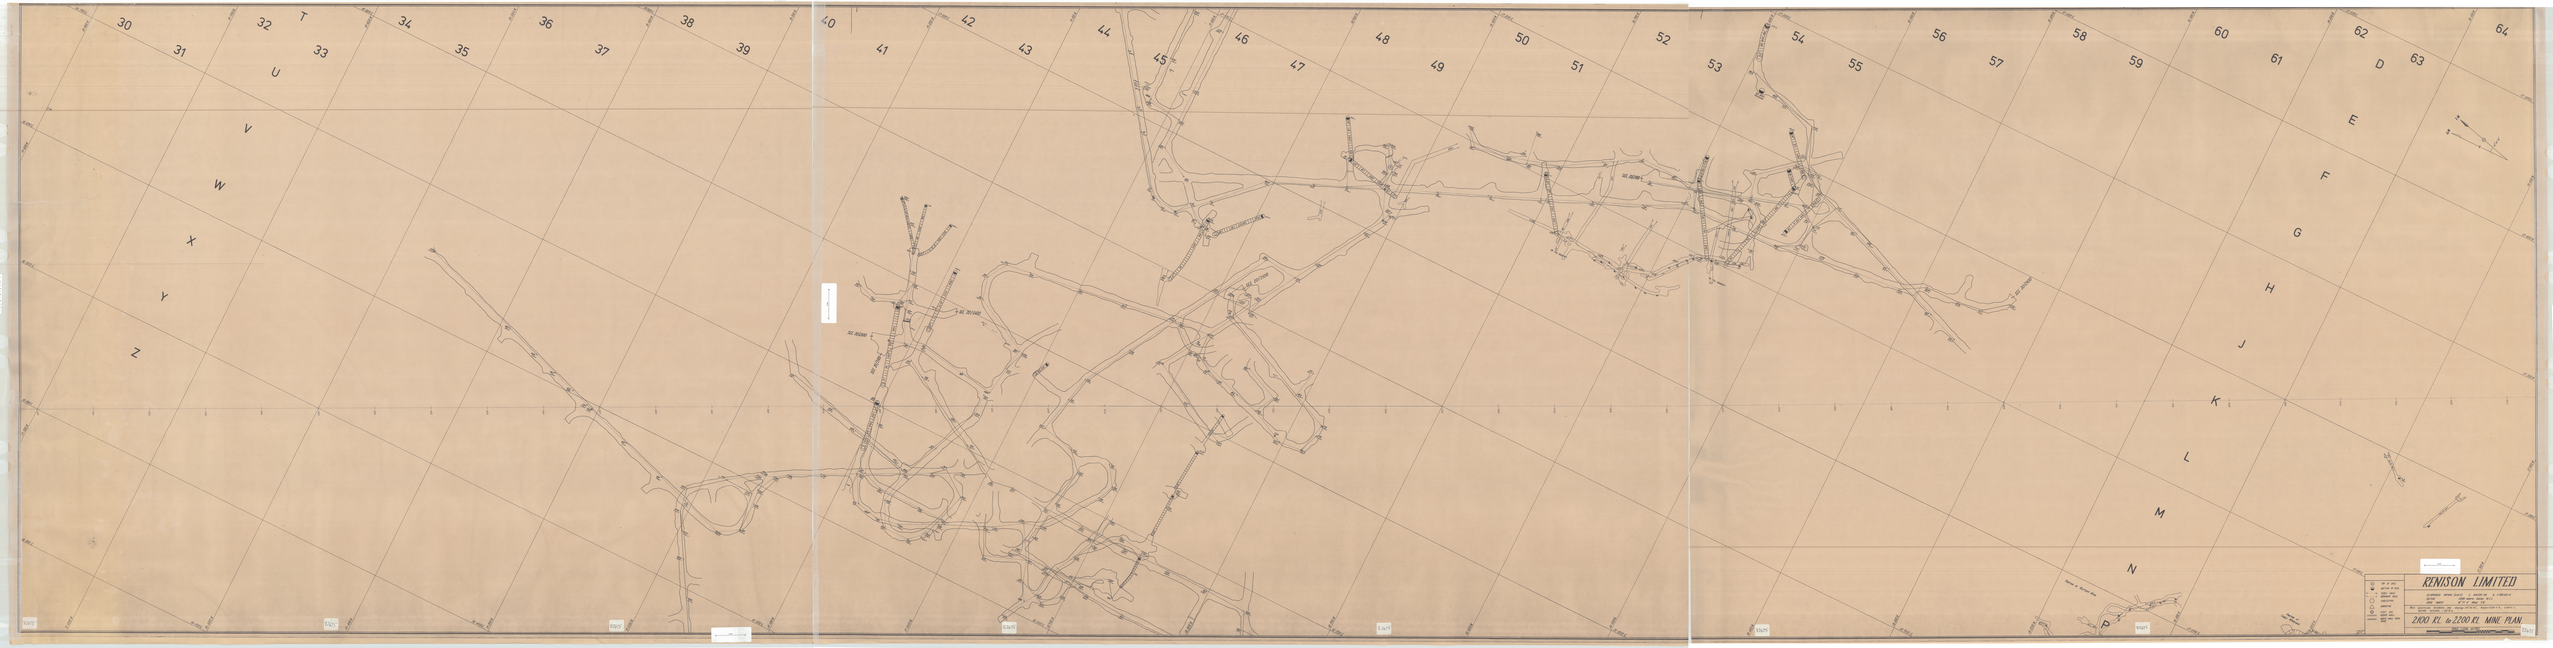
RINSON LIMITED
2100 EL. to 2200 EL. MINE PLAN