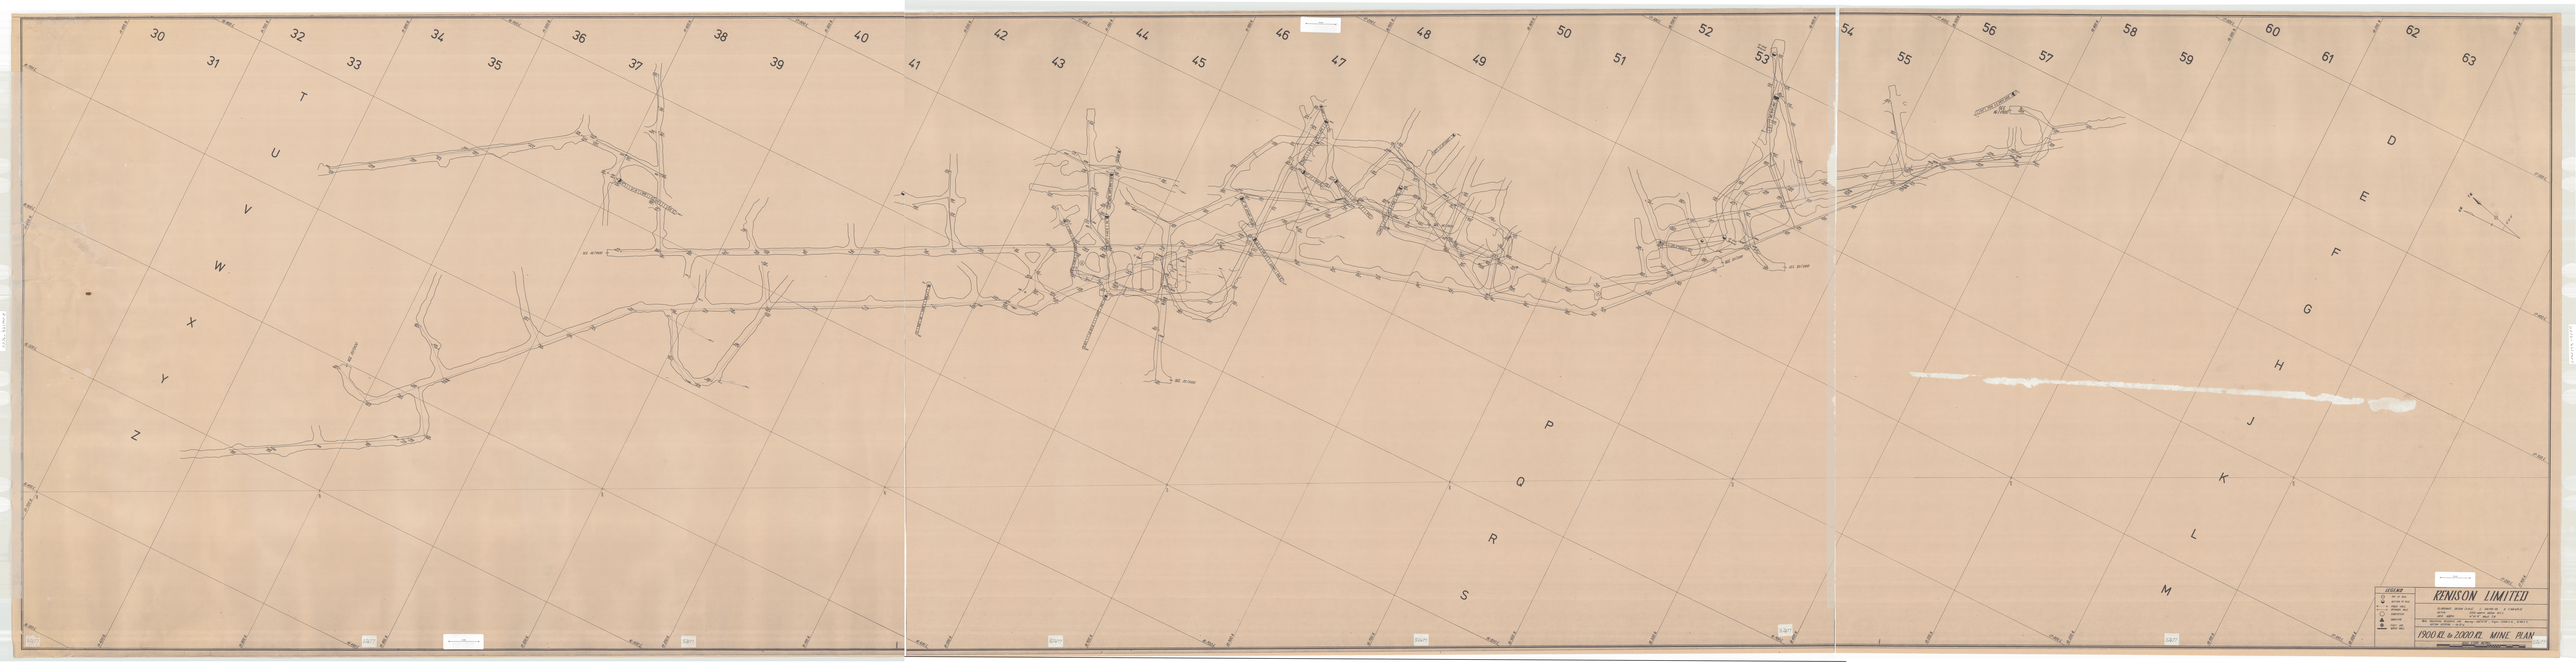
RENISON LIMITED
1900 RL to 2000 RL MINE PLAN