


0376-472

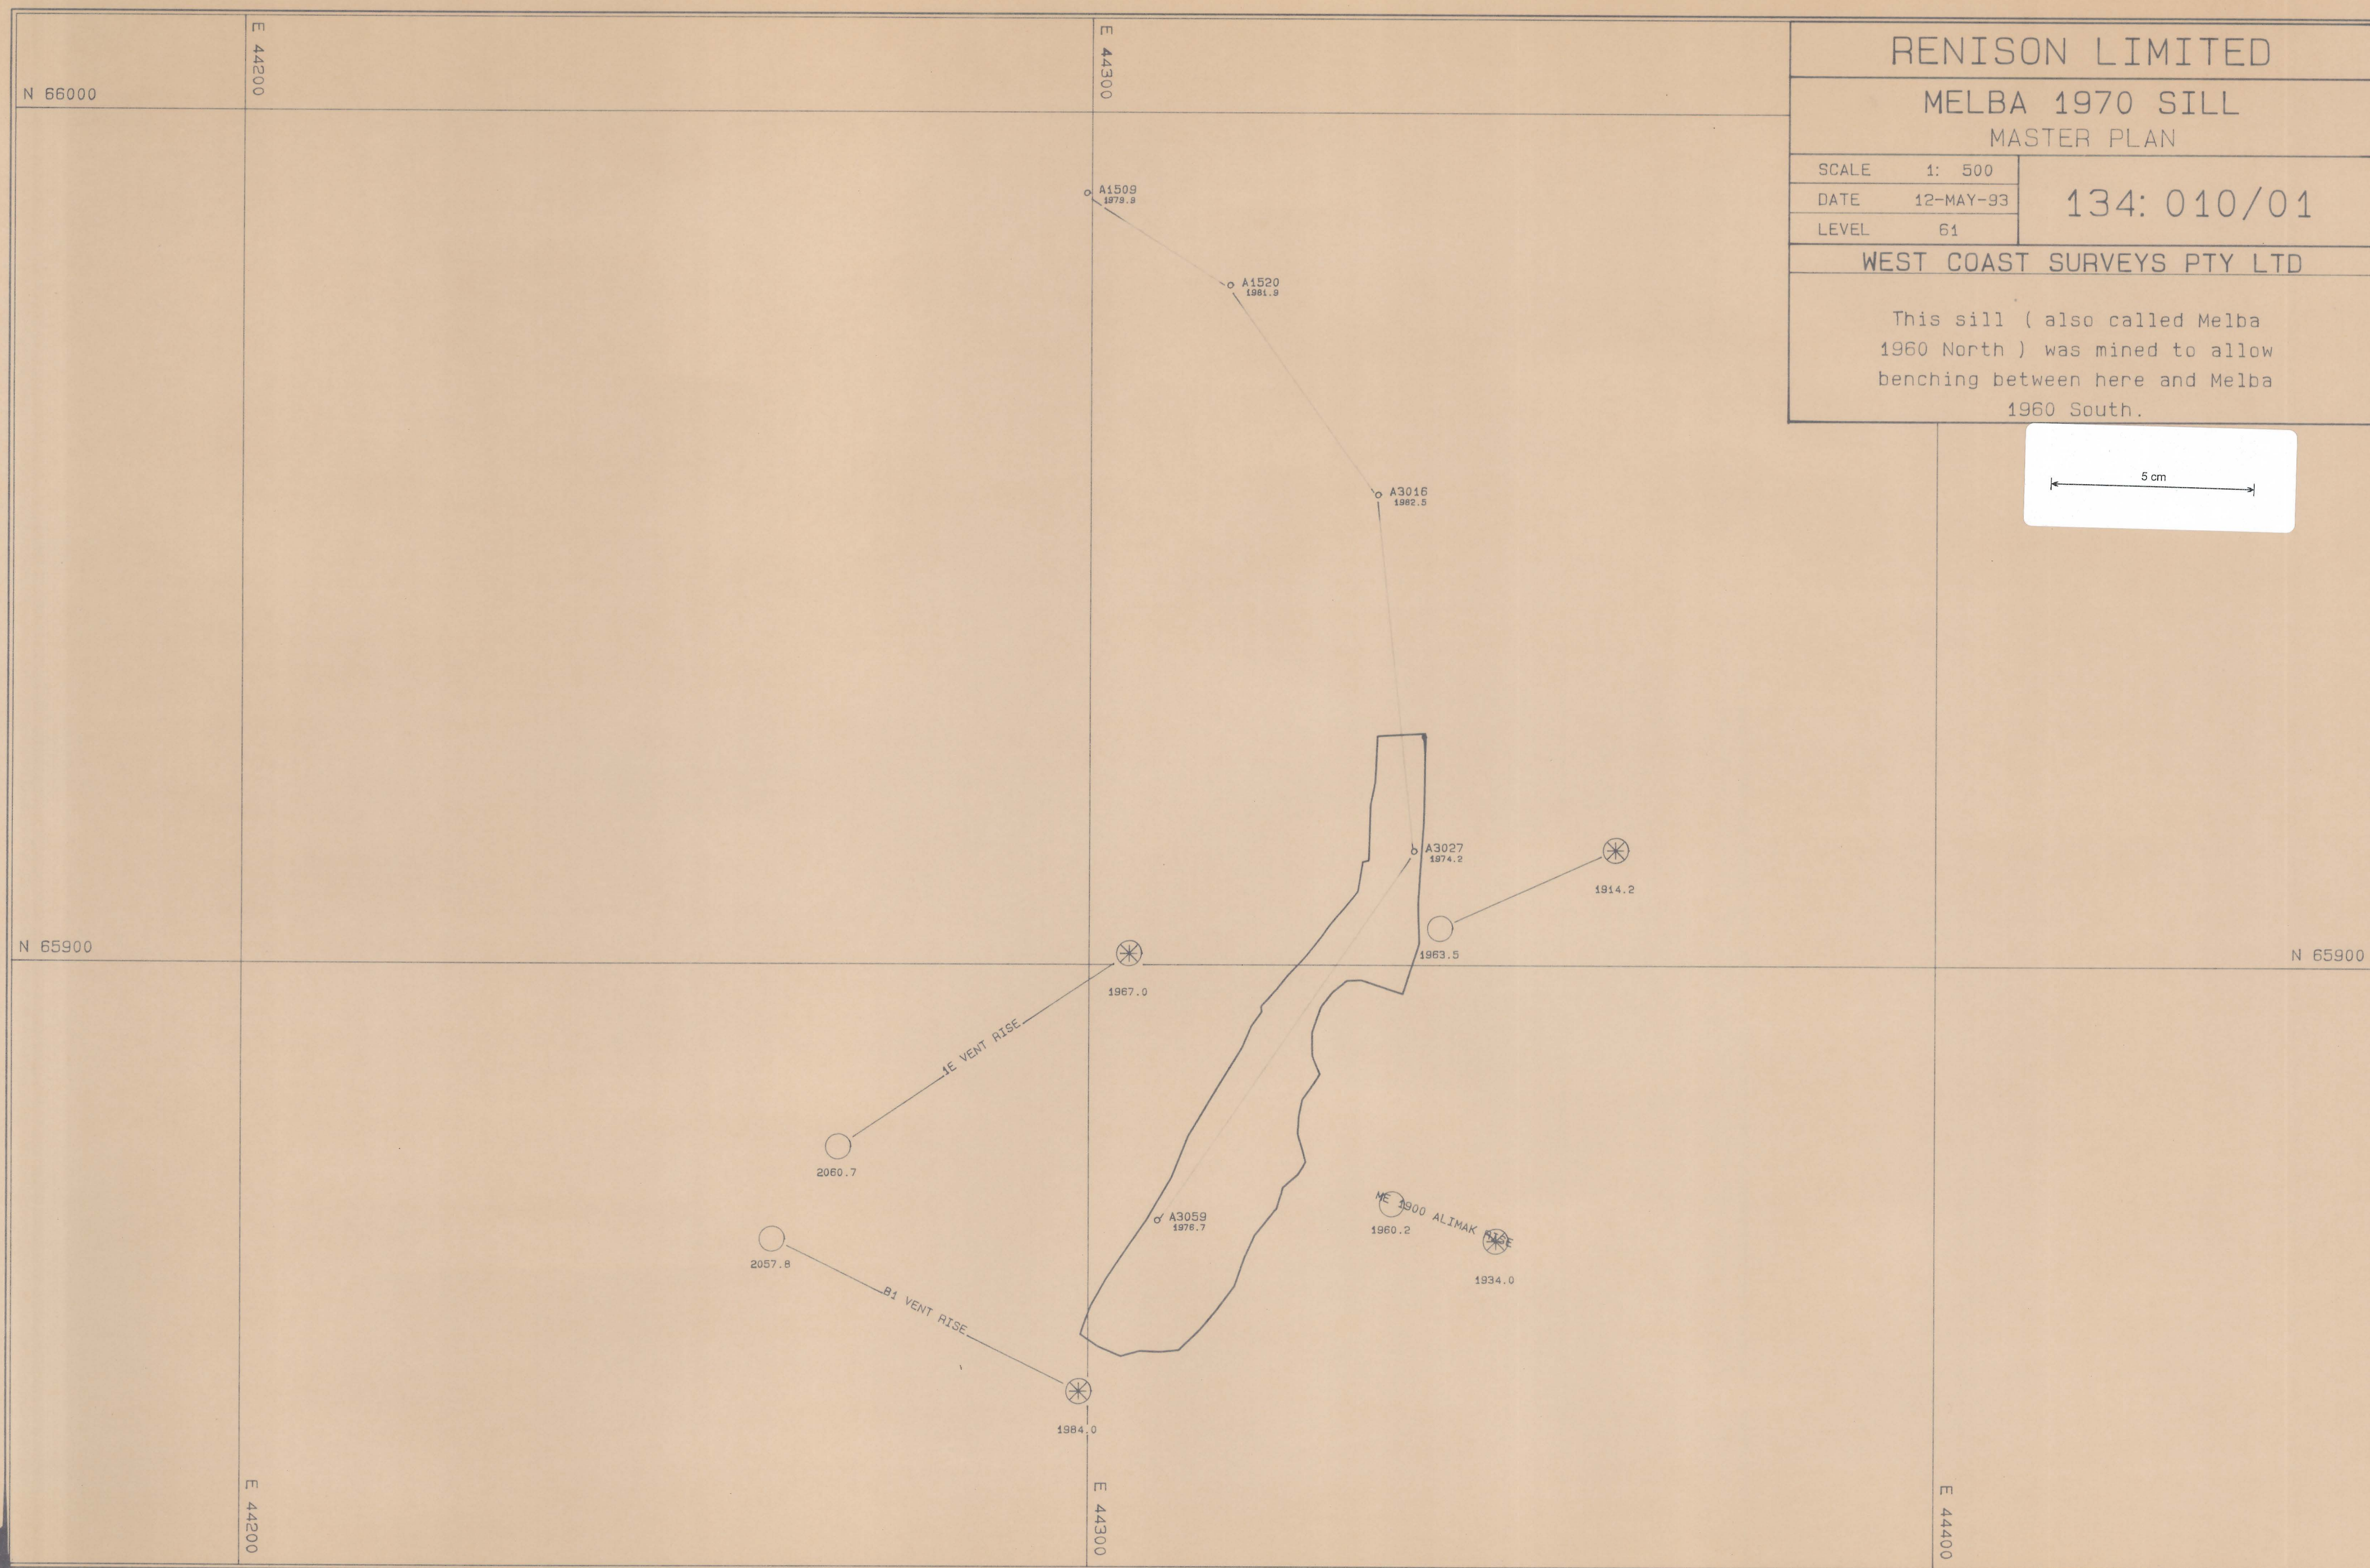

STEAL.PF