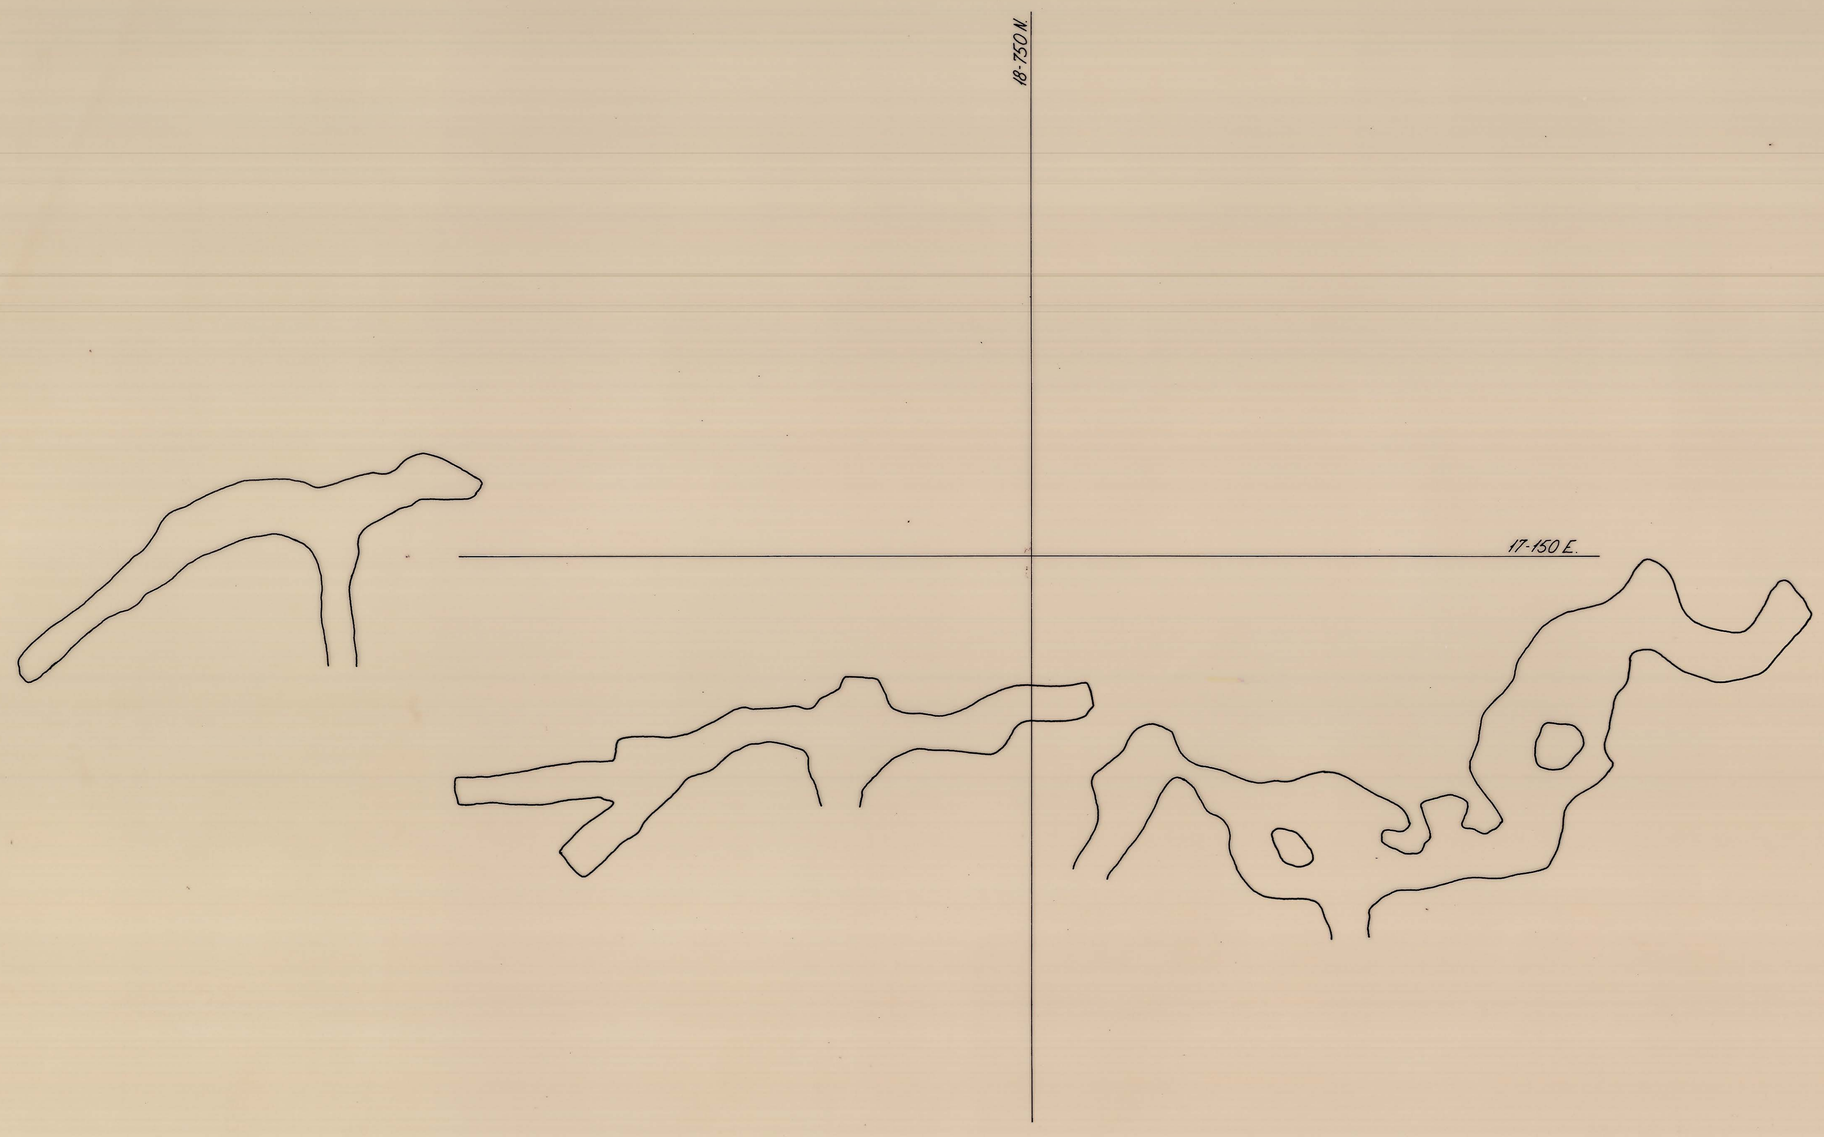

5 cm

DATE	MANAGER	SURVEYOR	RENISON LIMITED SURVEY			DRAWING No.
31-12-'79			DRAWN. F.M.H.	DATE. 21-3-'80	SCALE. 1:500	73:001
			1900 NORTH STEBBINS			
			NTH. LEVEL: 1920. STH. LEVEL: 1943			

0376_531
80051