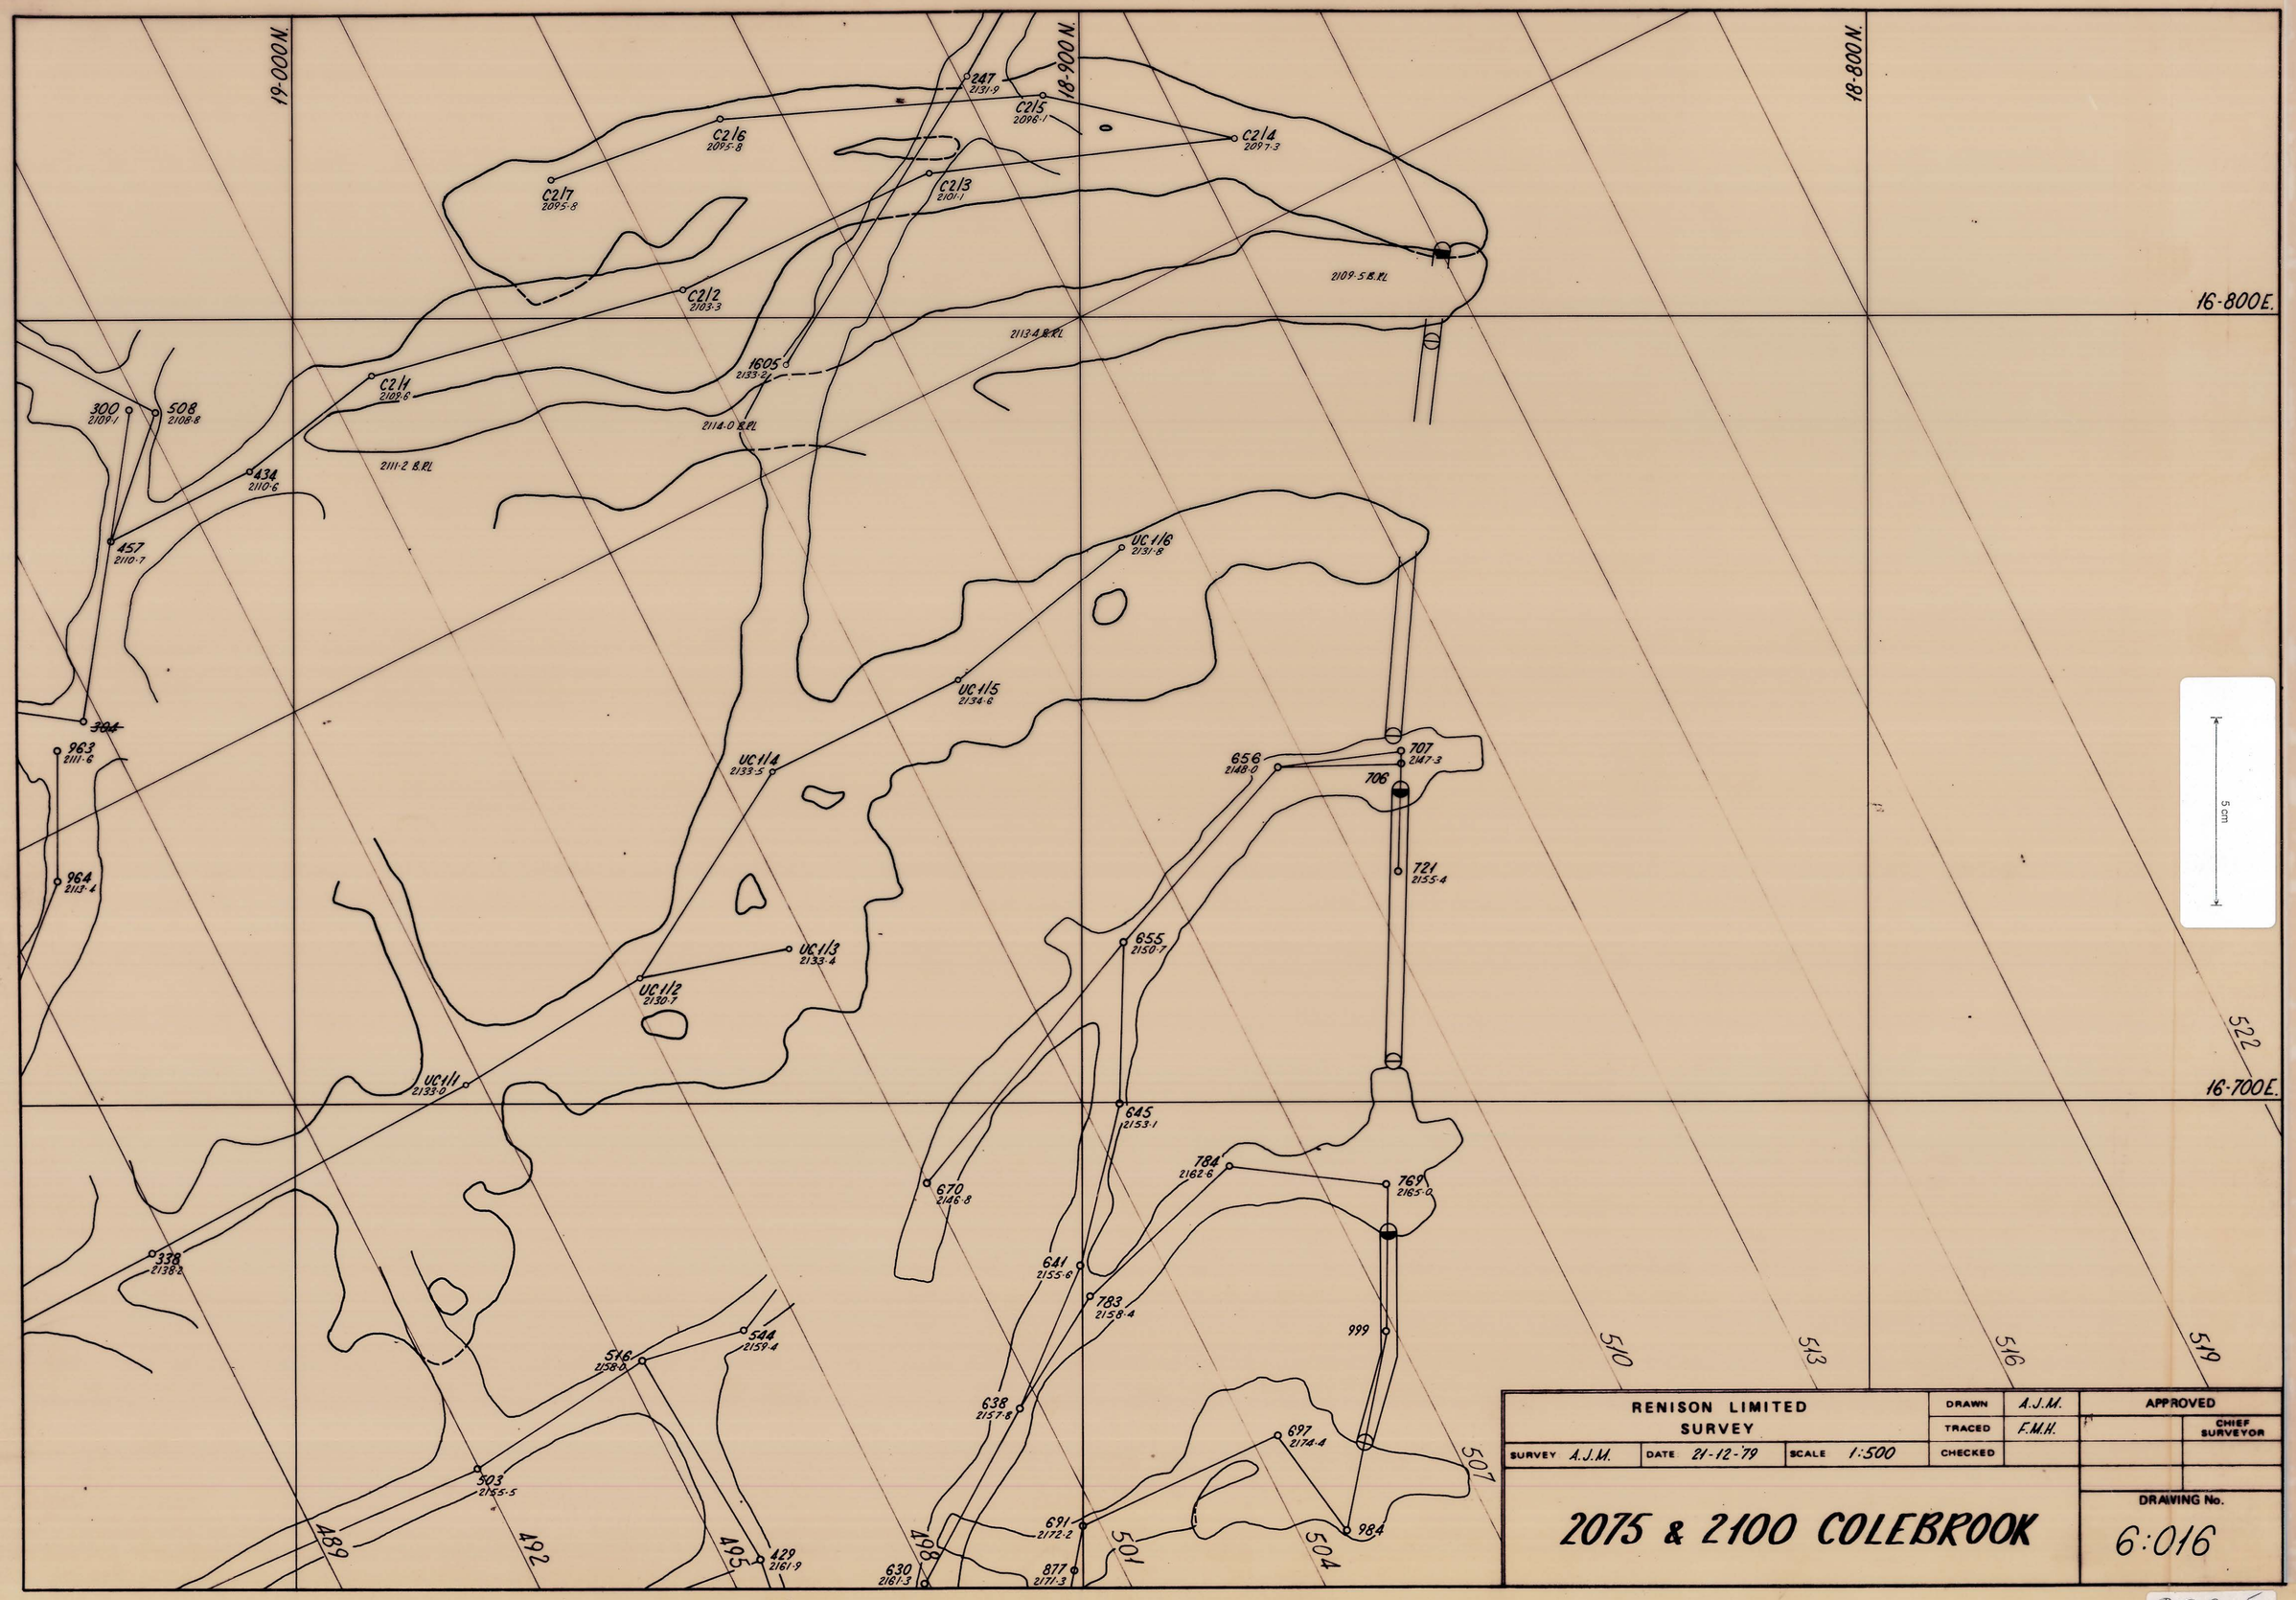

RENISON LIMITED SURVEY			DRAWN	A.J.M.	APPROVED	
			TRACED	F.M.H.		CHIEF SURVEYOR
SURVEY A.J.M.	DATE 21-12-79	SCALE 1:500	CHECKED			

2075 & 2100 COLEBROOK

DRAWING No. 6:016

0376_537

80045