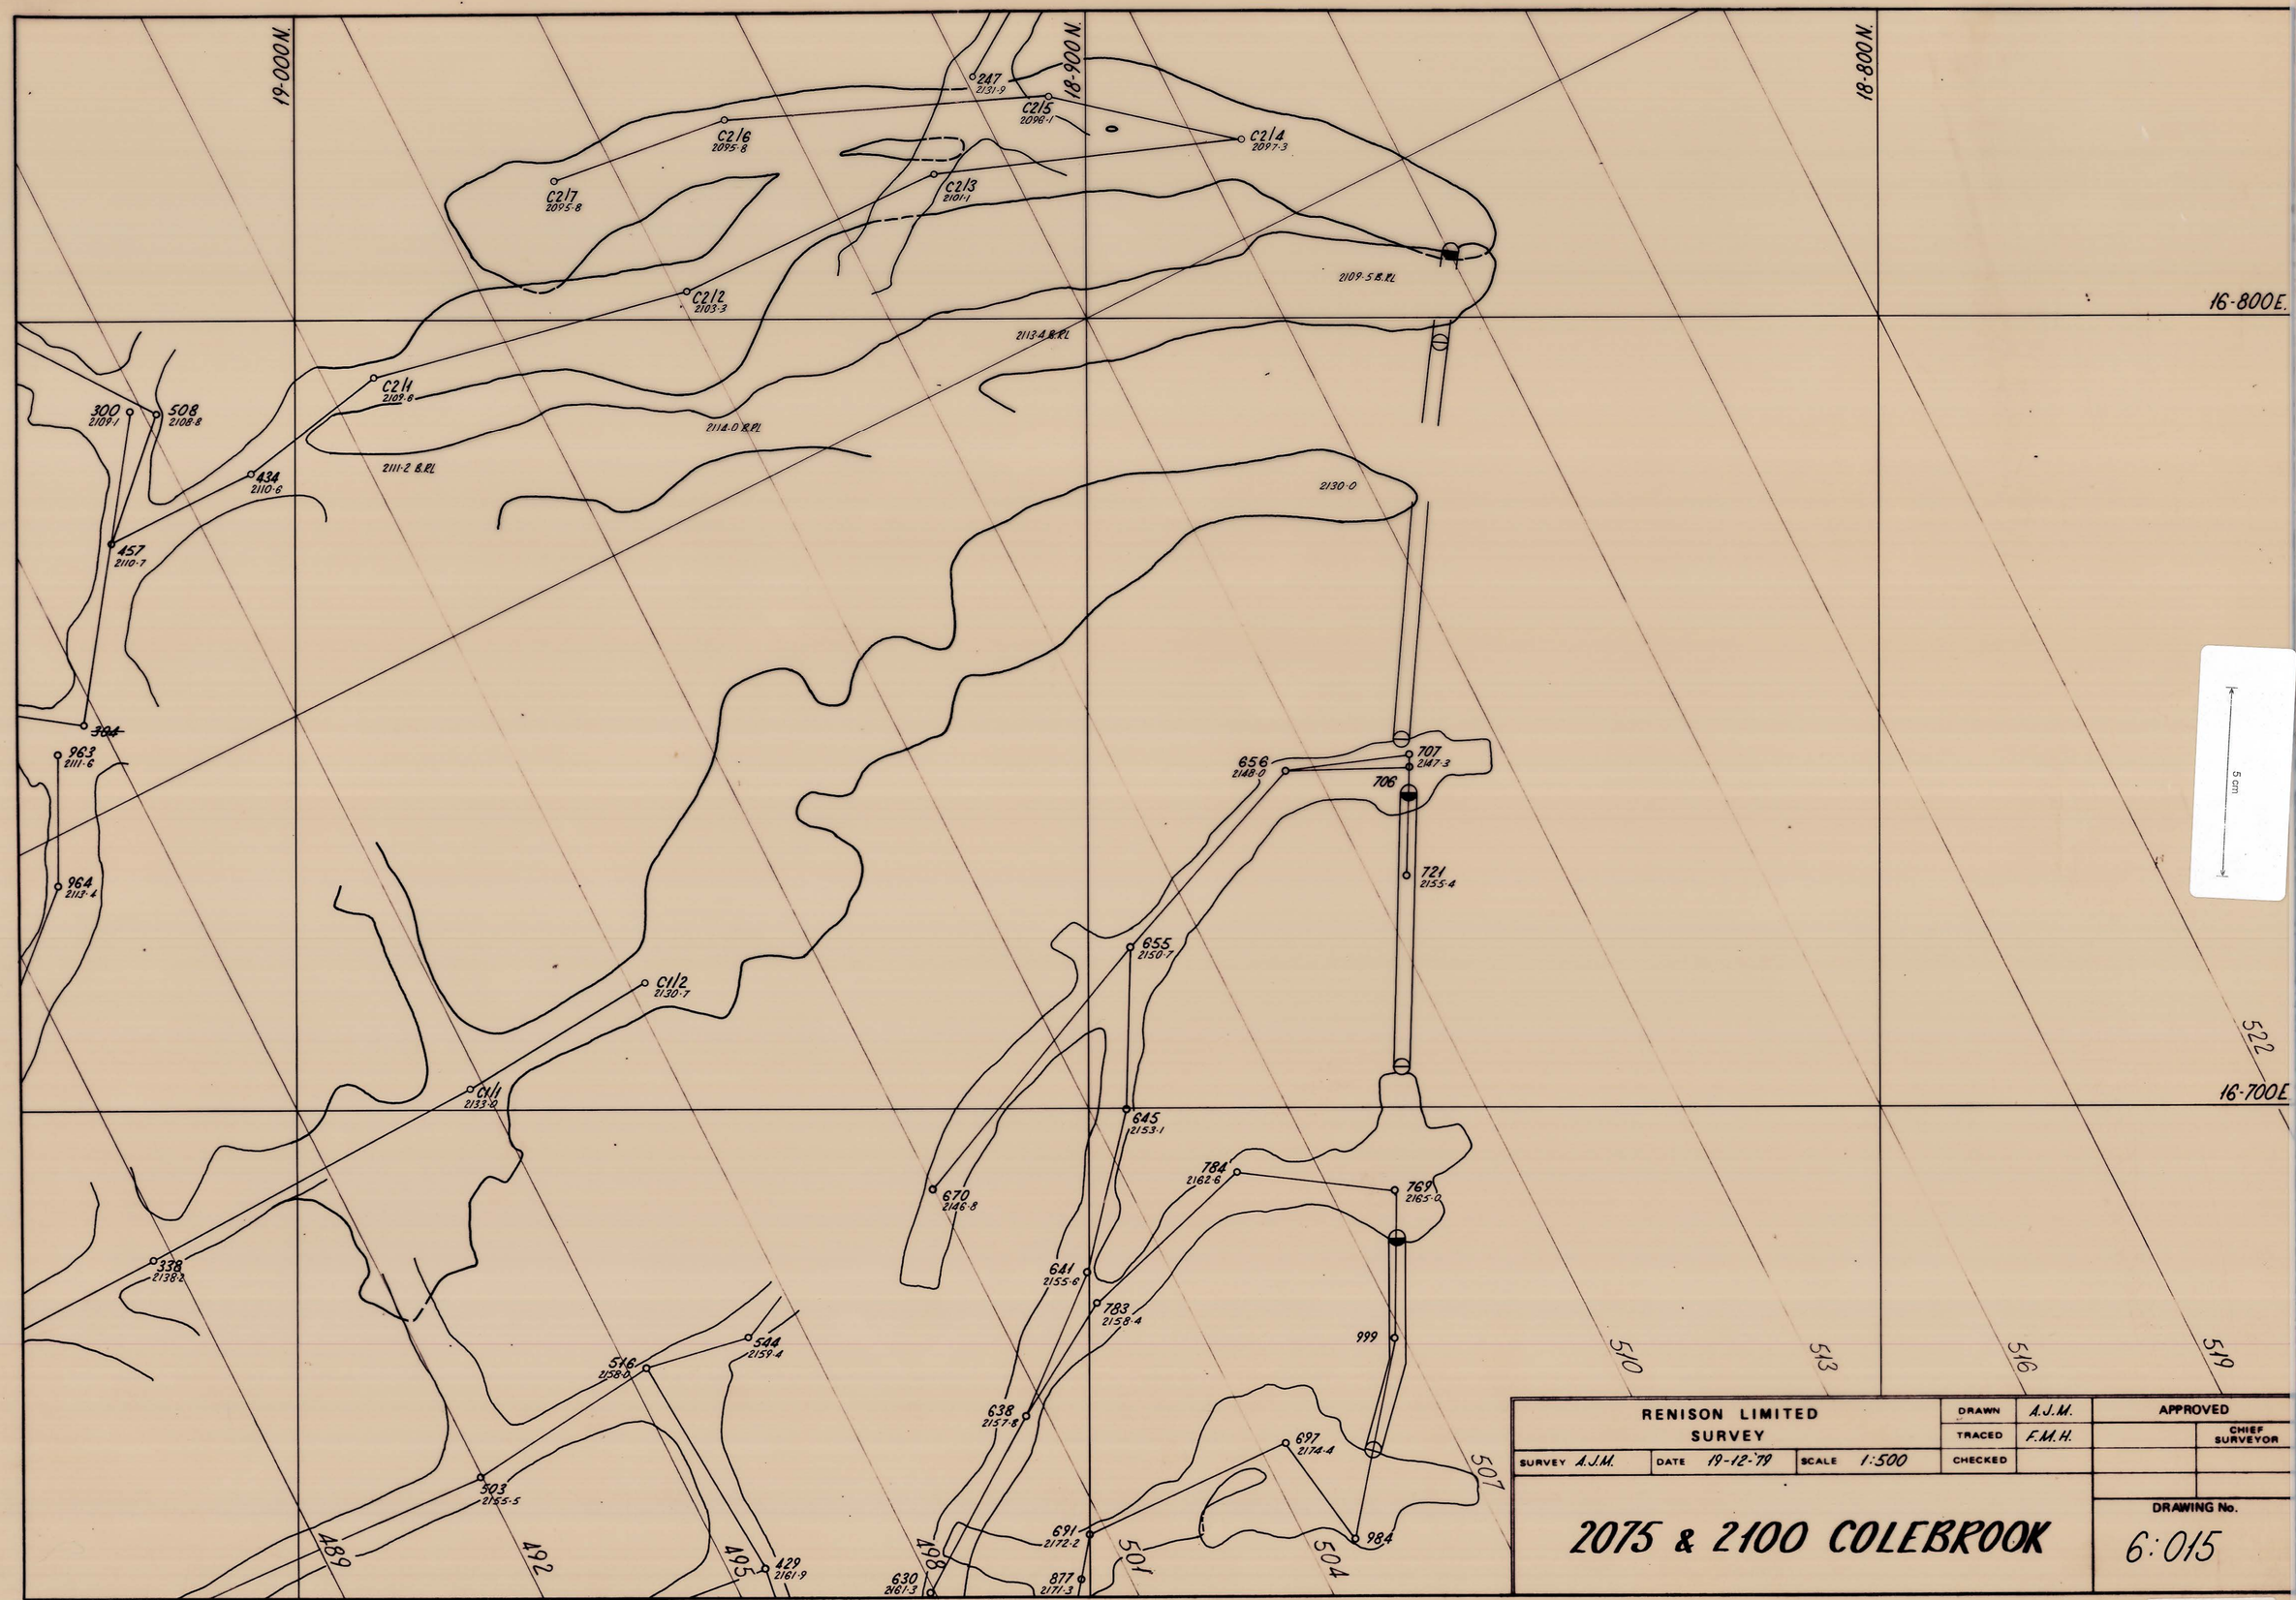

RENISON LIMITED SURVEY			DRAWN	A.J.M.	APPROVED	
			TRACED	F.M.H.		CHIEF SURVEYOR
SURVEY A.J.M.	DATE 19-12-79	SCALE 1:500	CHECKED			
2075 & 2100 COLEBROOK					DRAWING No. 6:015	

0376_538
80044