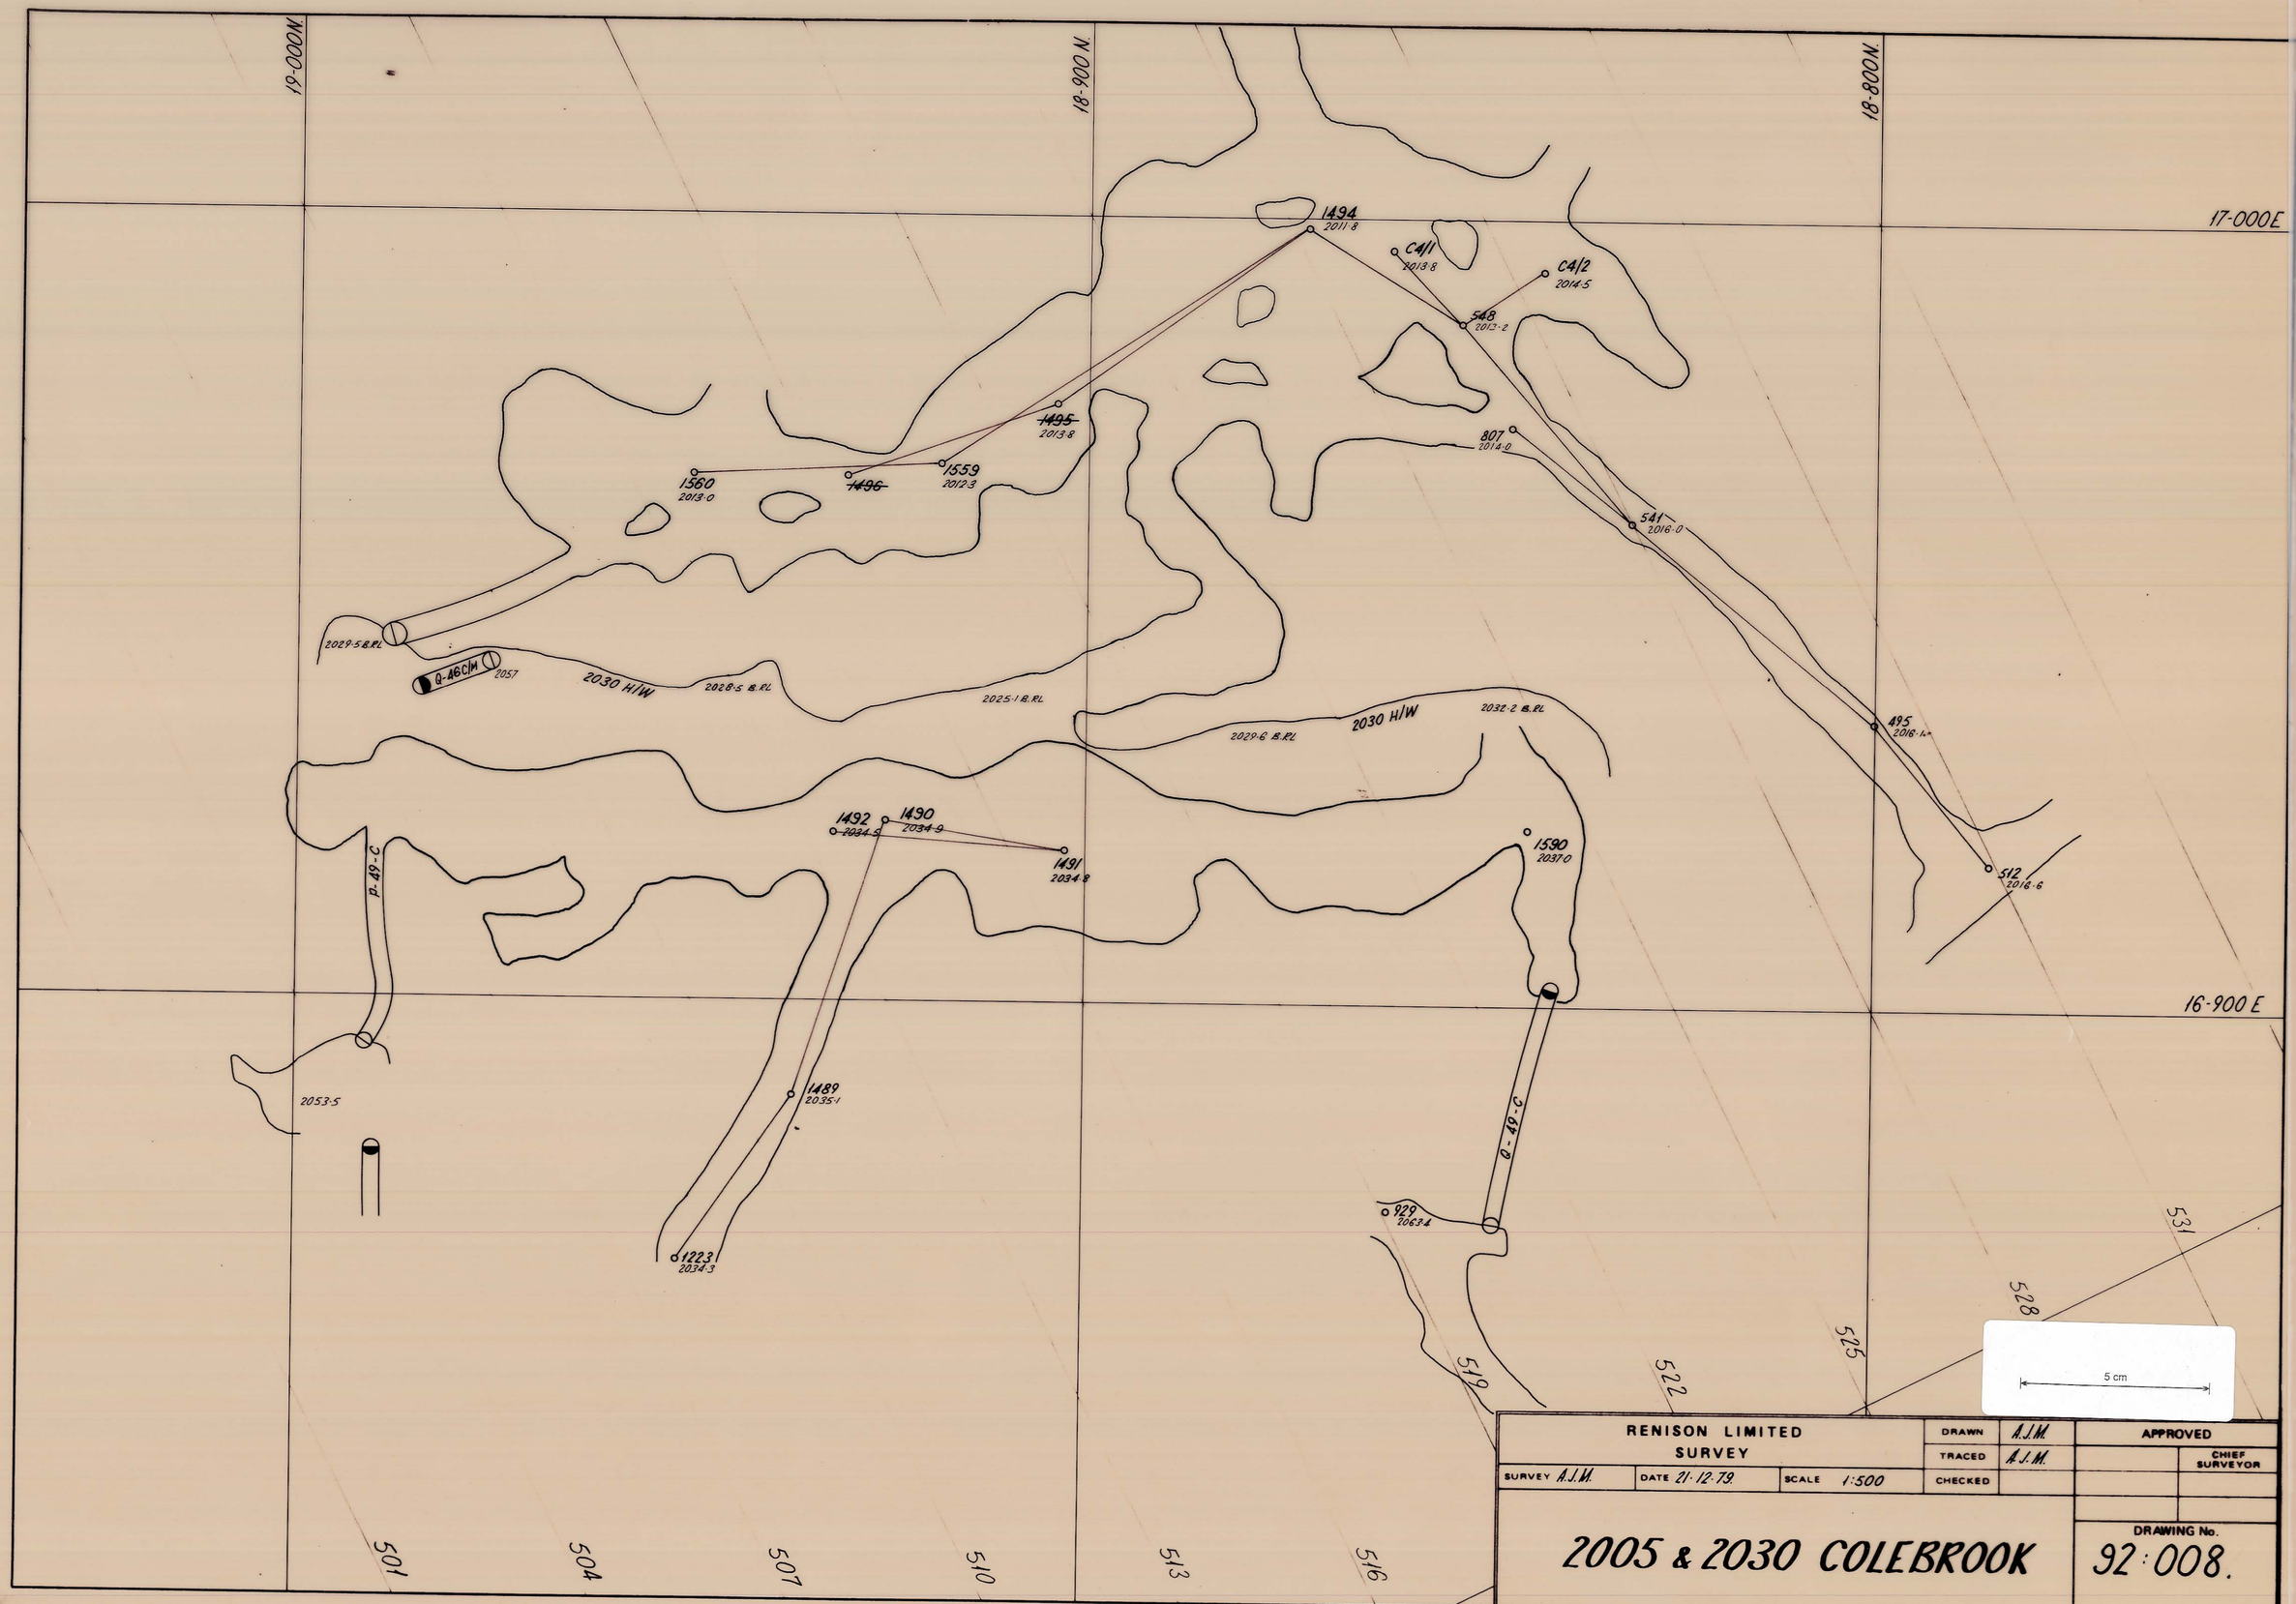

0326 - 634

80058