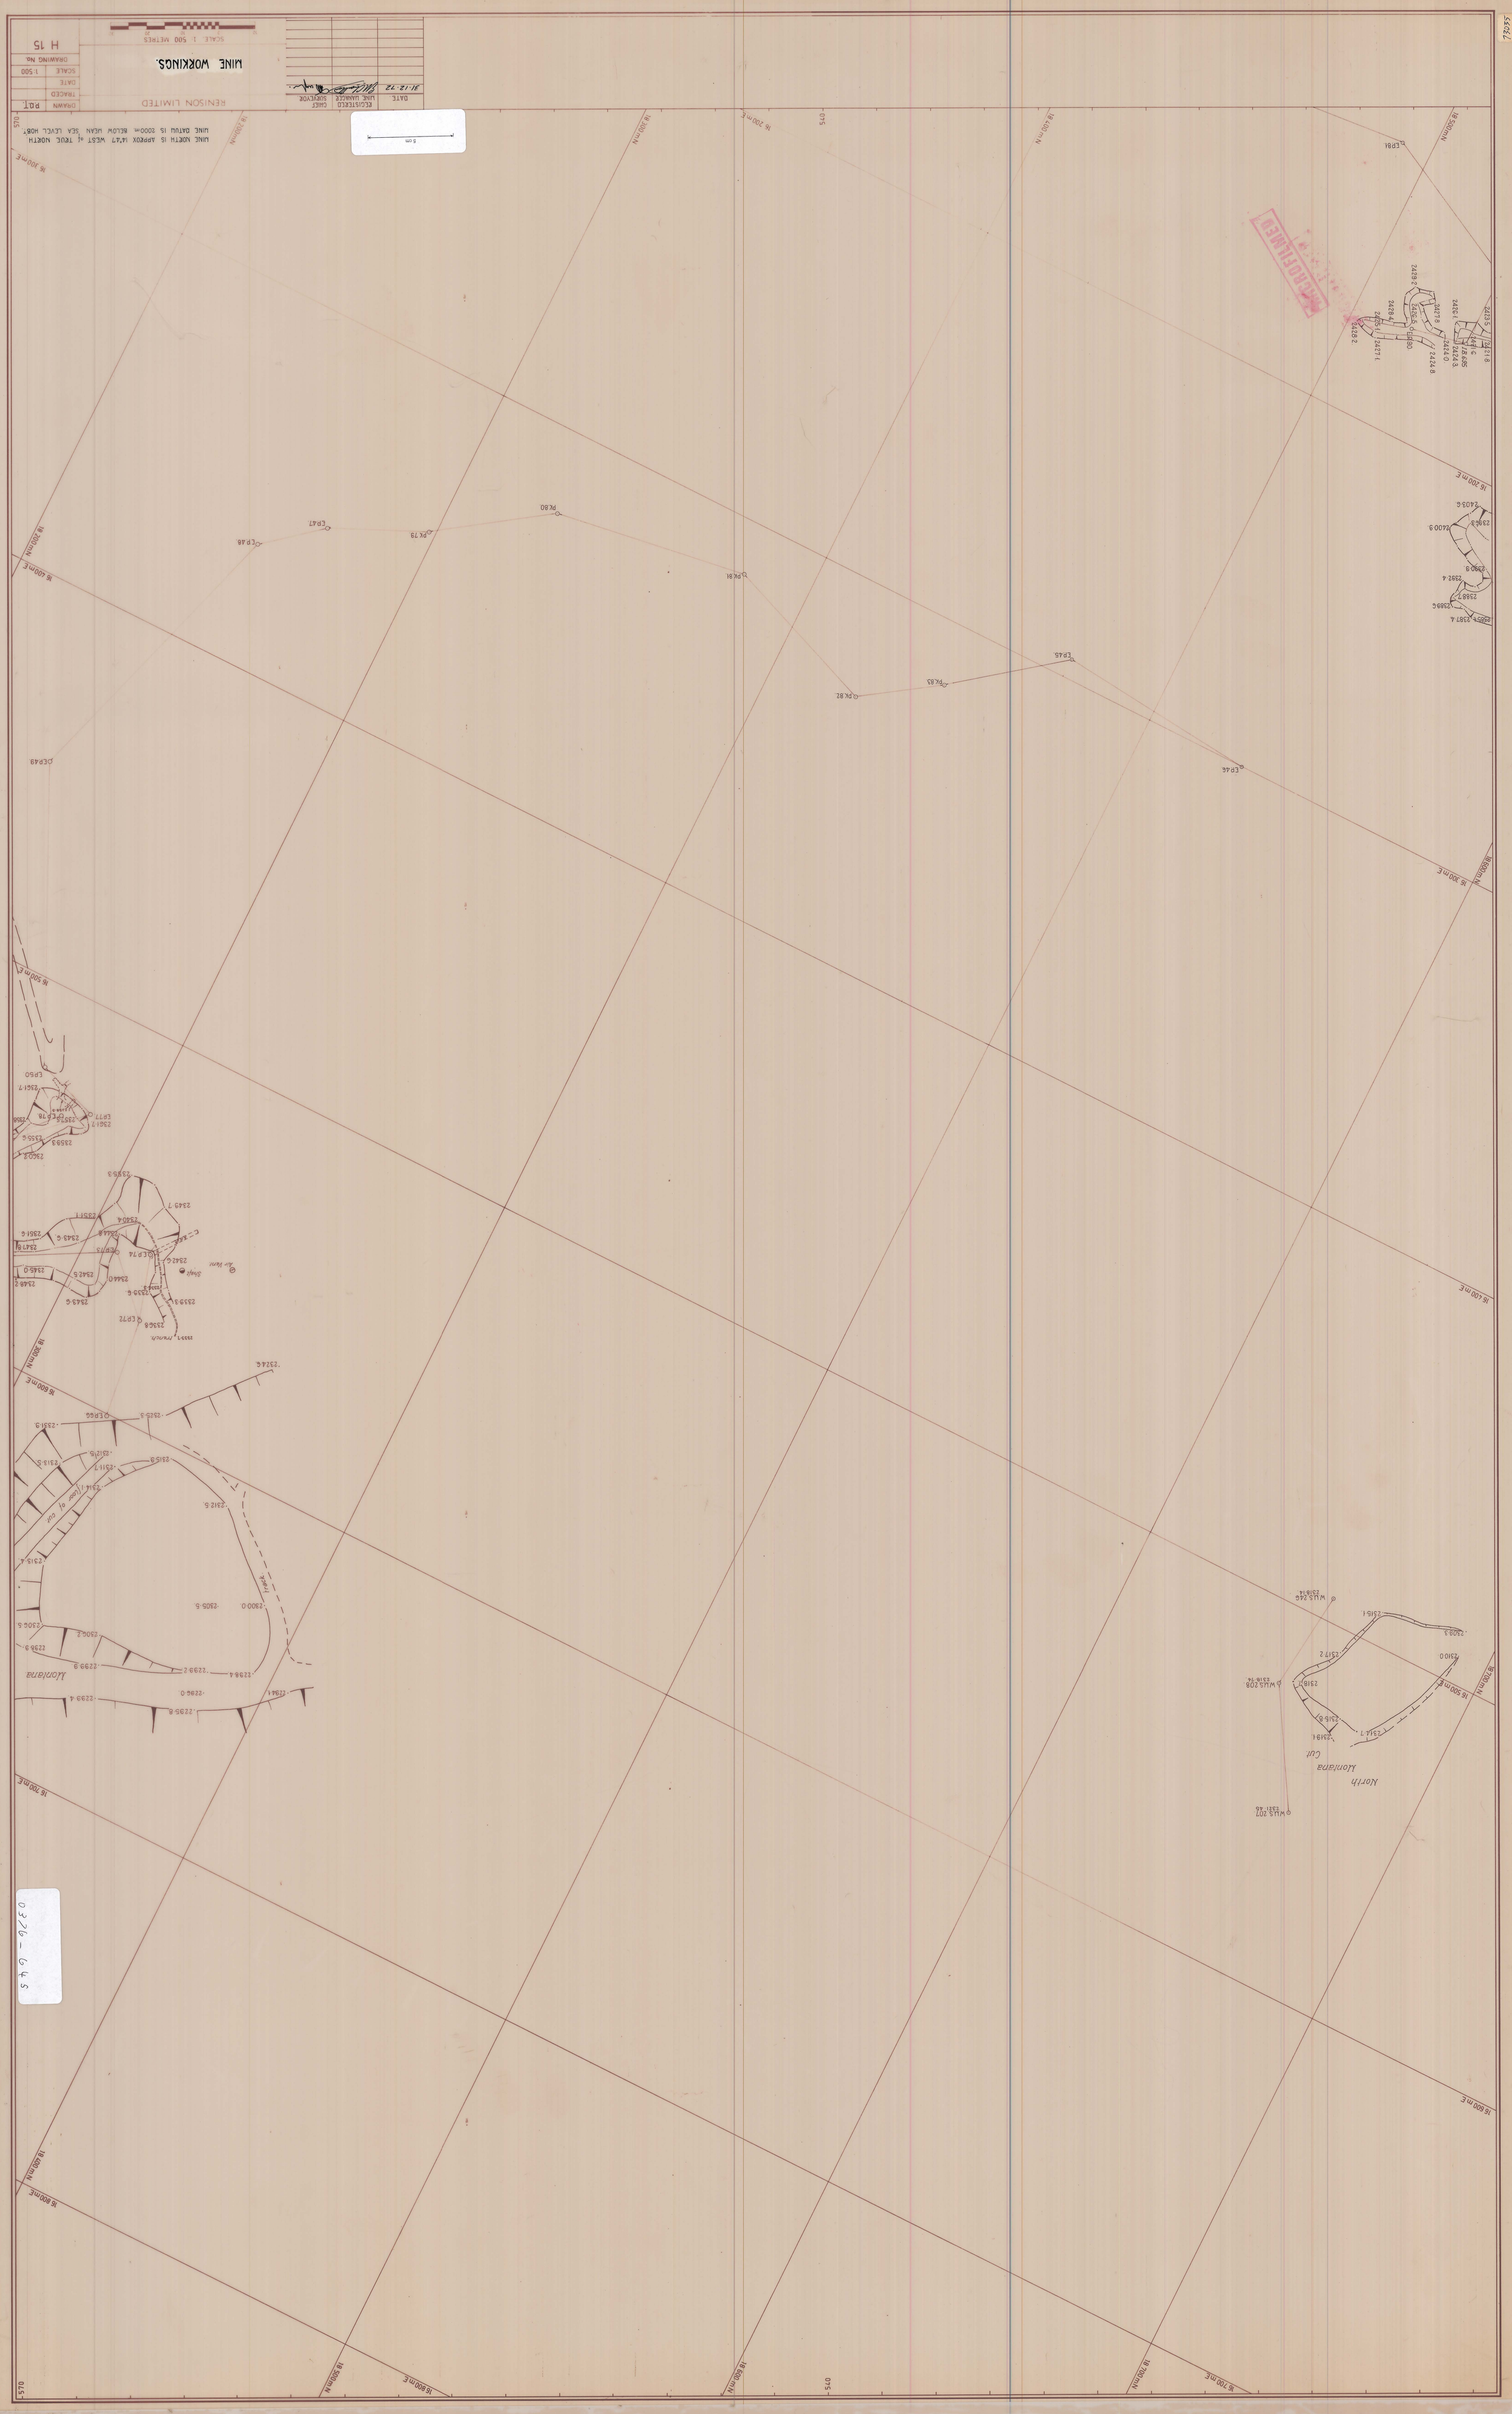
MICROFILMED
MINE WORKINGS.
RENISON LIMITED
DRAWN P.D.T.
TRACED
DATE
SCALE 1:500
DRAWING No. H 15
DATE 31.12.72
REGISTERED MINE MANAGER
CHIEF SURVEYOR
SCALE 1: 500 METERS
MINE NORTH IS APPROX 14°47' WEST of TRUE NORTH.
MINE DATUM IS 2000m BELOW MEAN SEA LEVEL HOBI.
5 cm
Shaft
Air Vent
Floor of cut
Trench
16 700 m E
16 800 m E
16 900 m E
16 500 m E
16 600 m E
18 500 m N
18 600 m N
18 700 m N
18 800 m N
18 900 m N
540
570
0376-645