

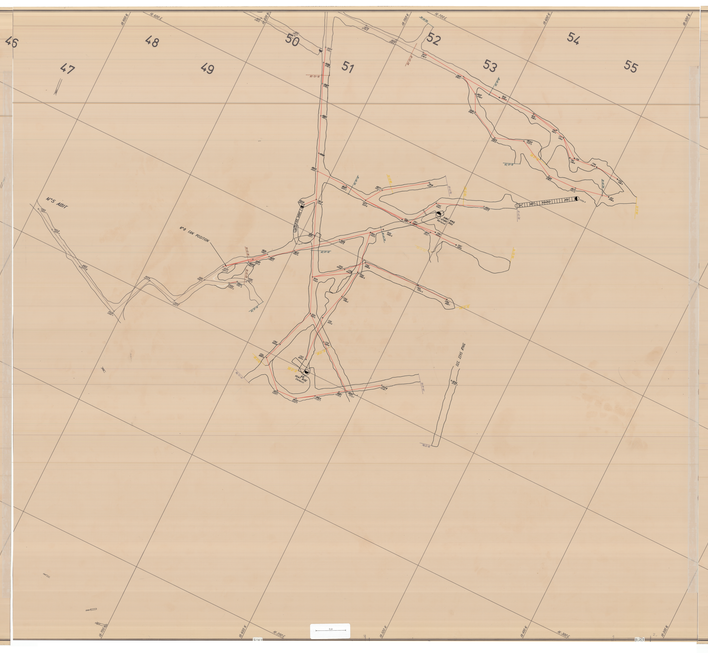

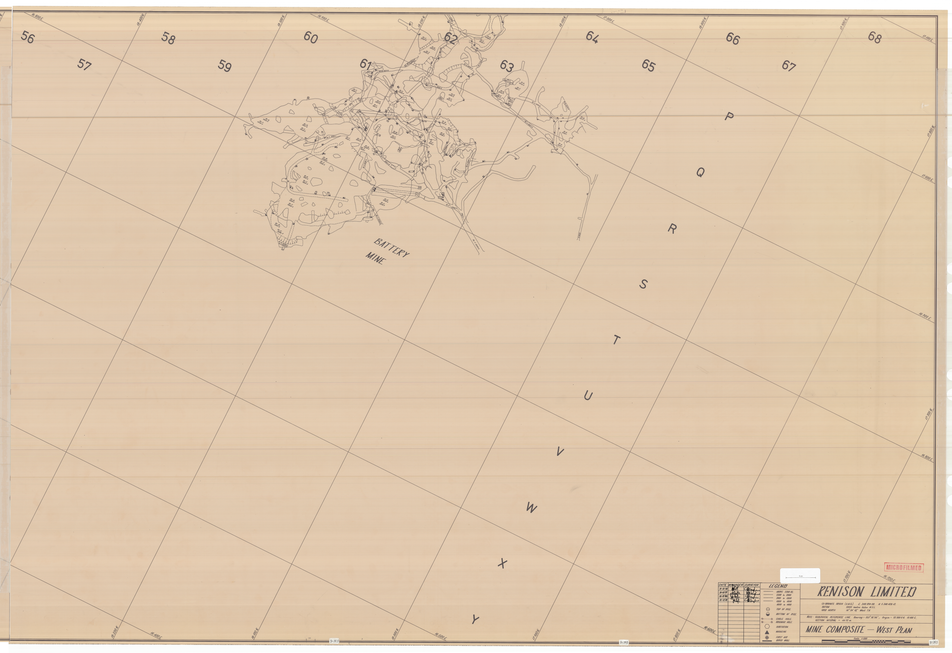

MICROFILMED

RENISON LIMITED

MINE COMPOSITE — WEST PLAN