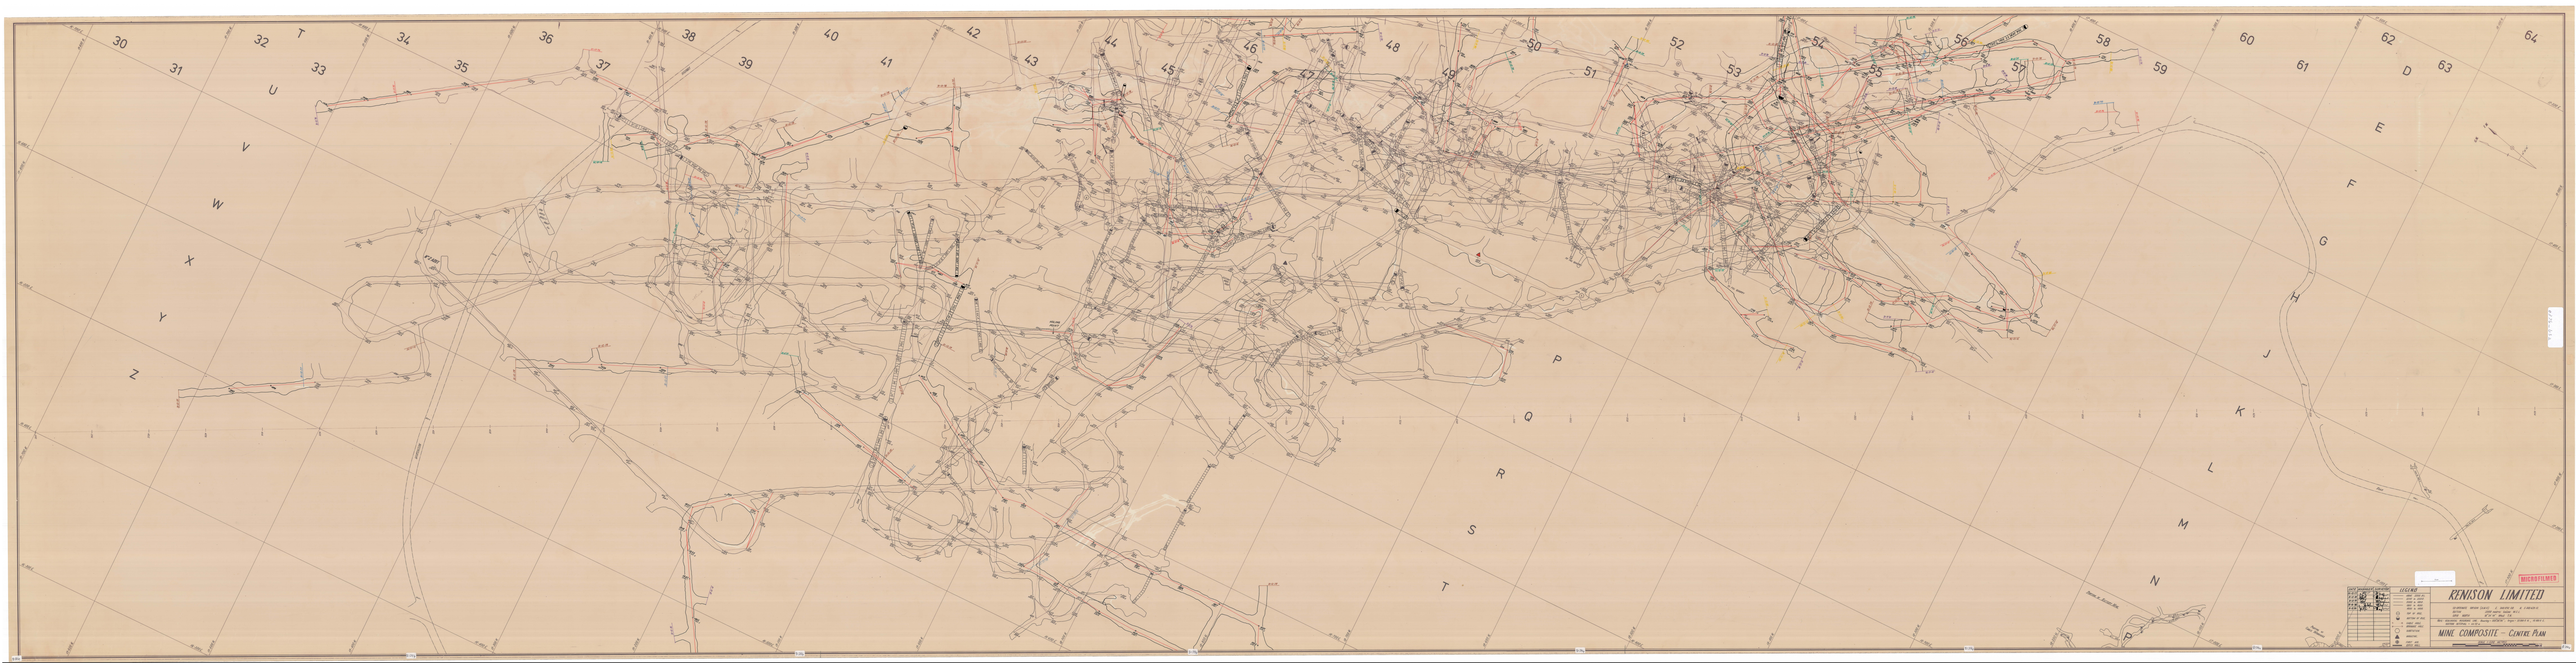
RENISON LIMITED
MINE COMPOSITE — CENTRAL PLAN
MICROFILMED