


0376_718

0376_718

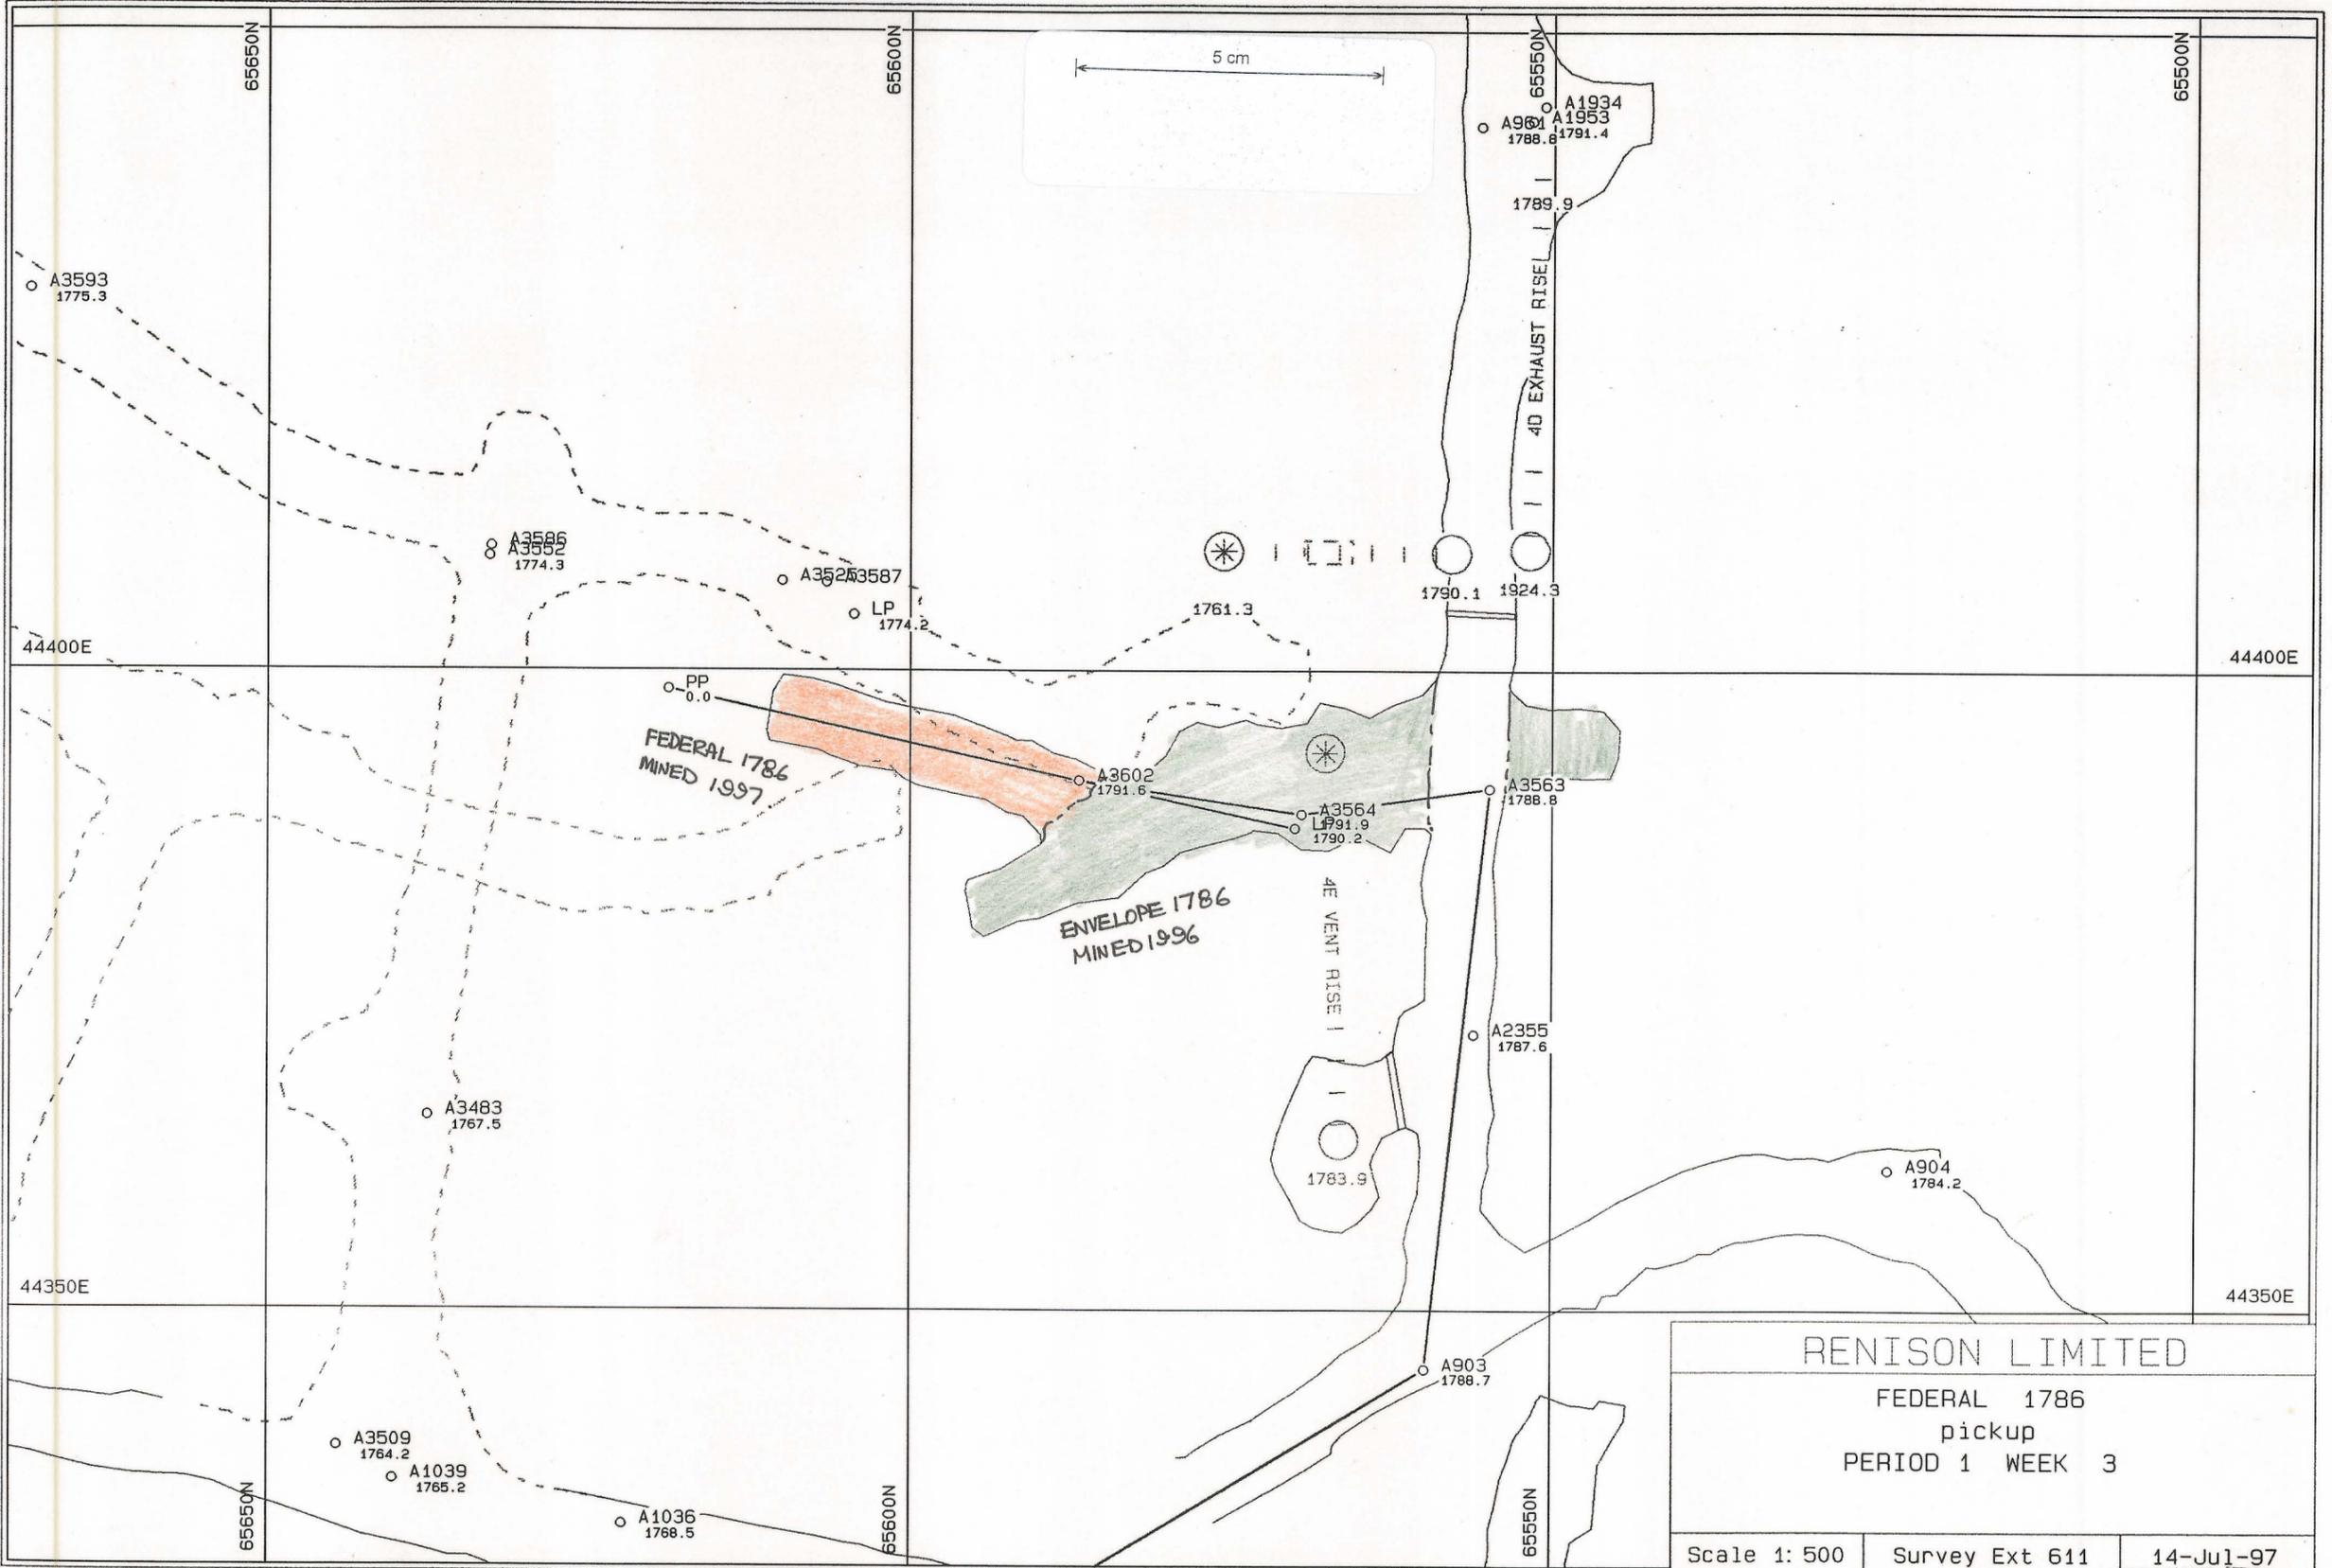

federalia.pt