0376_765

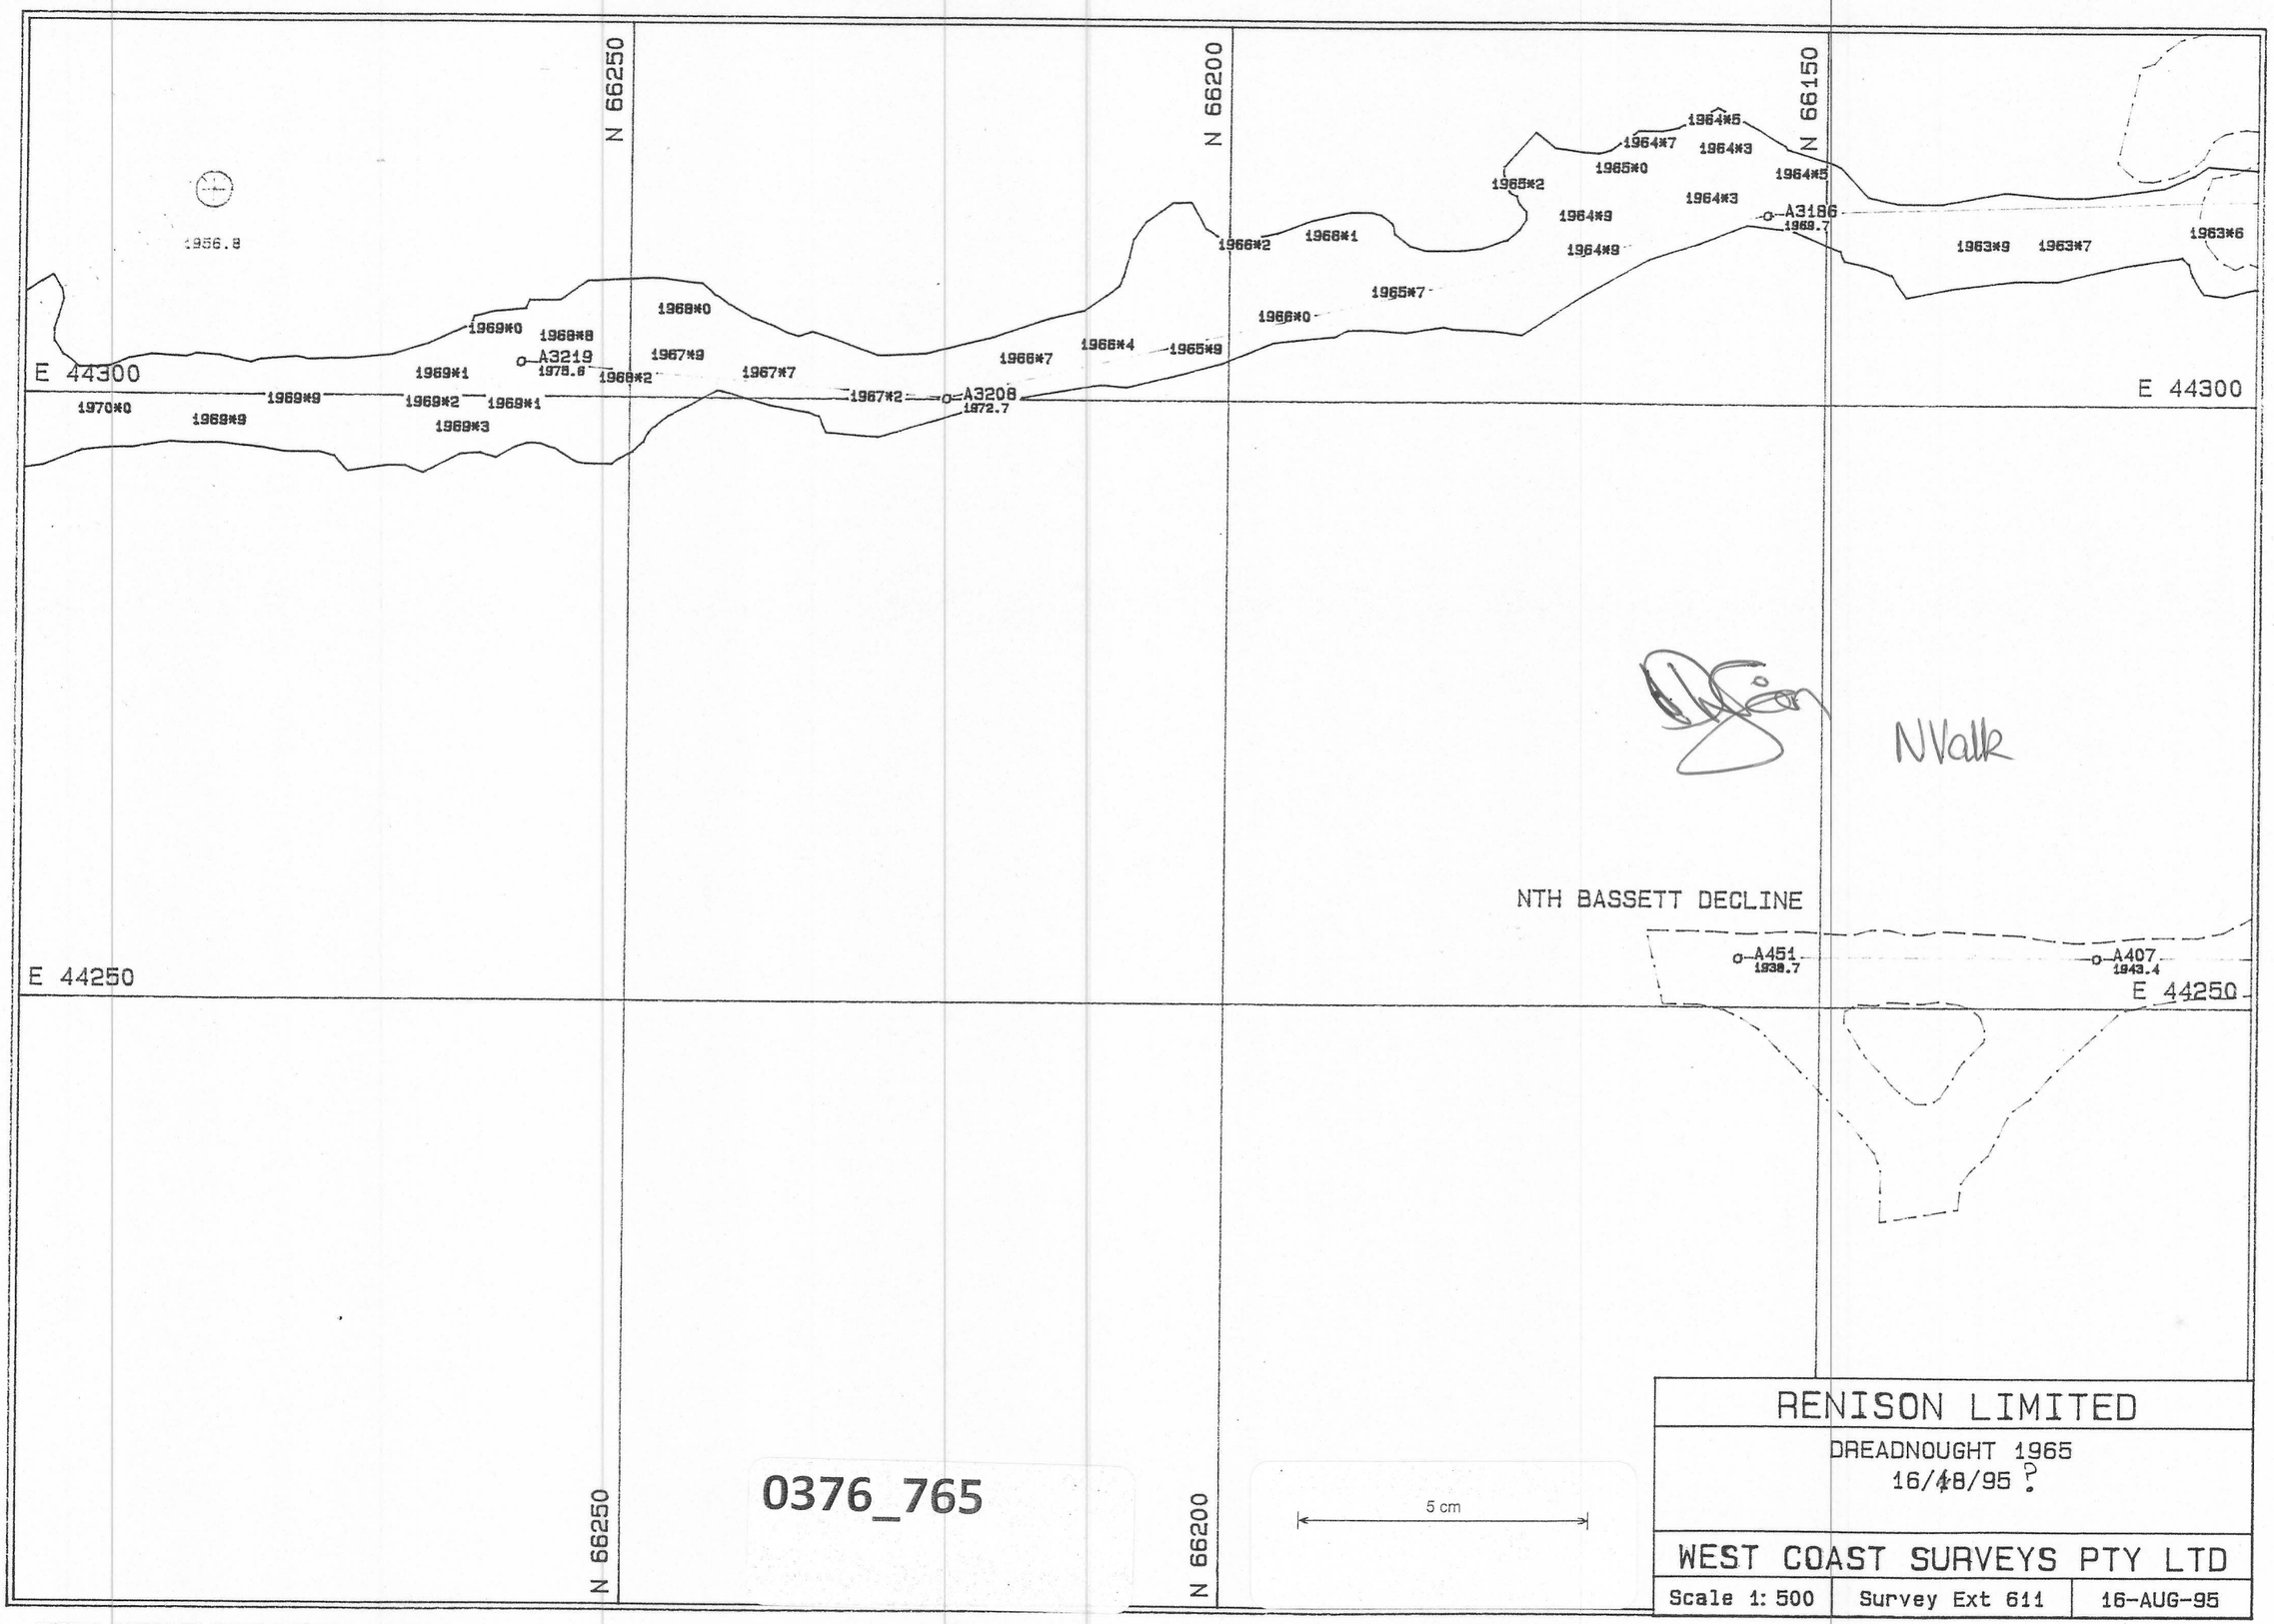

0376_765