0376_766

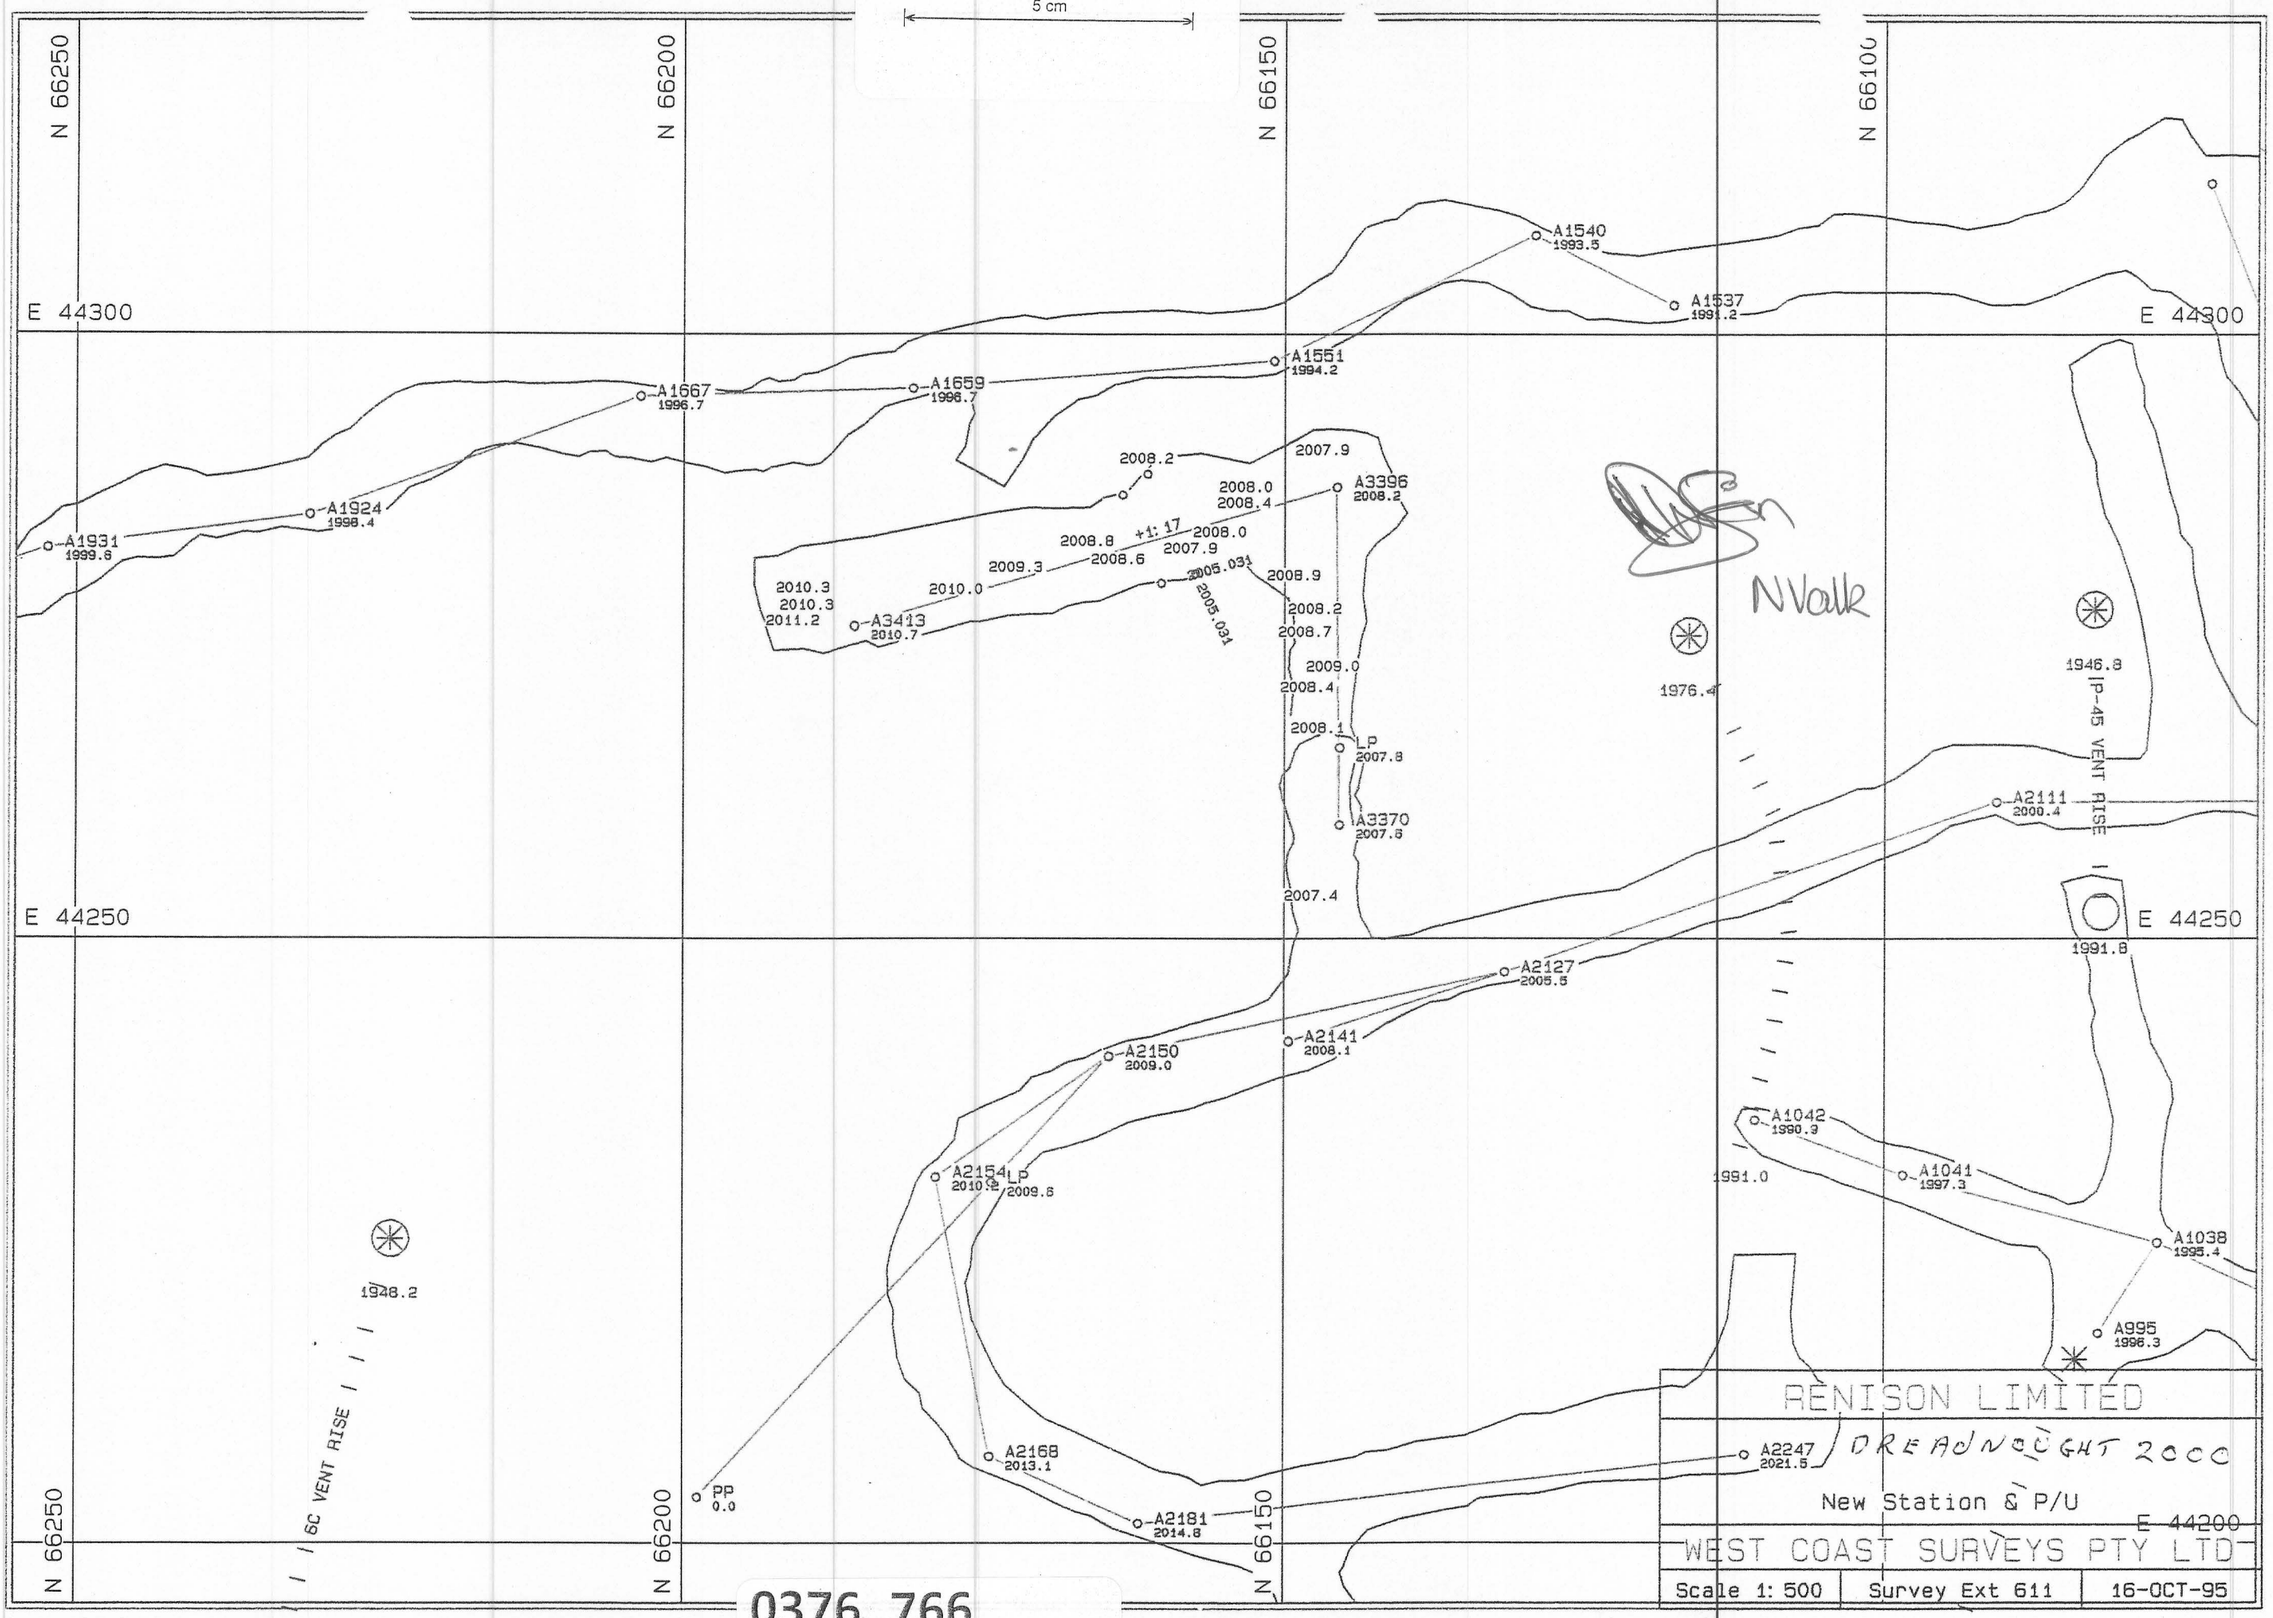

0376_766