0376_817

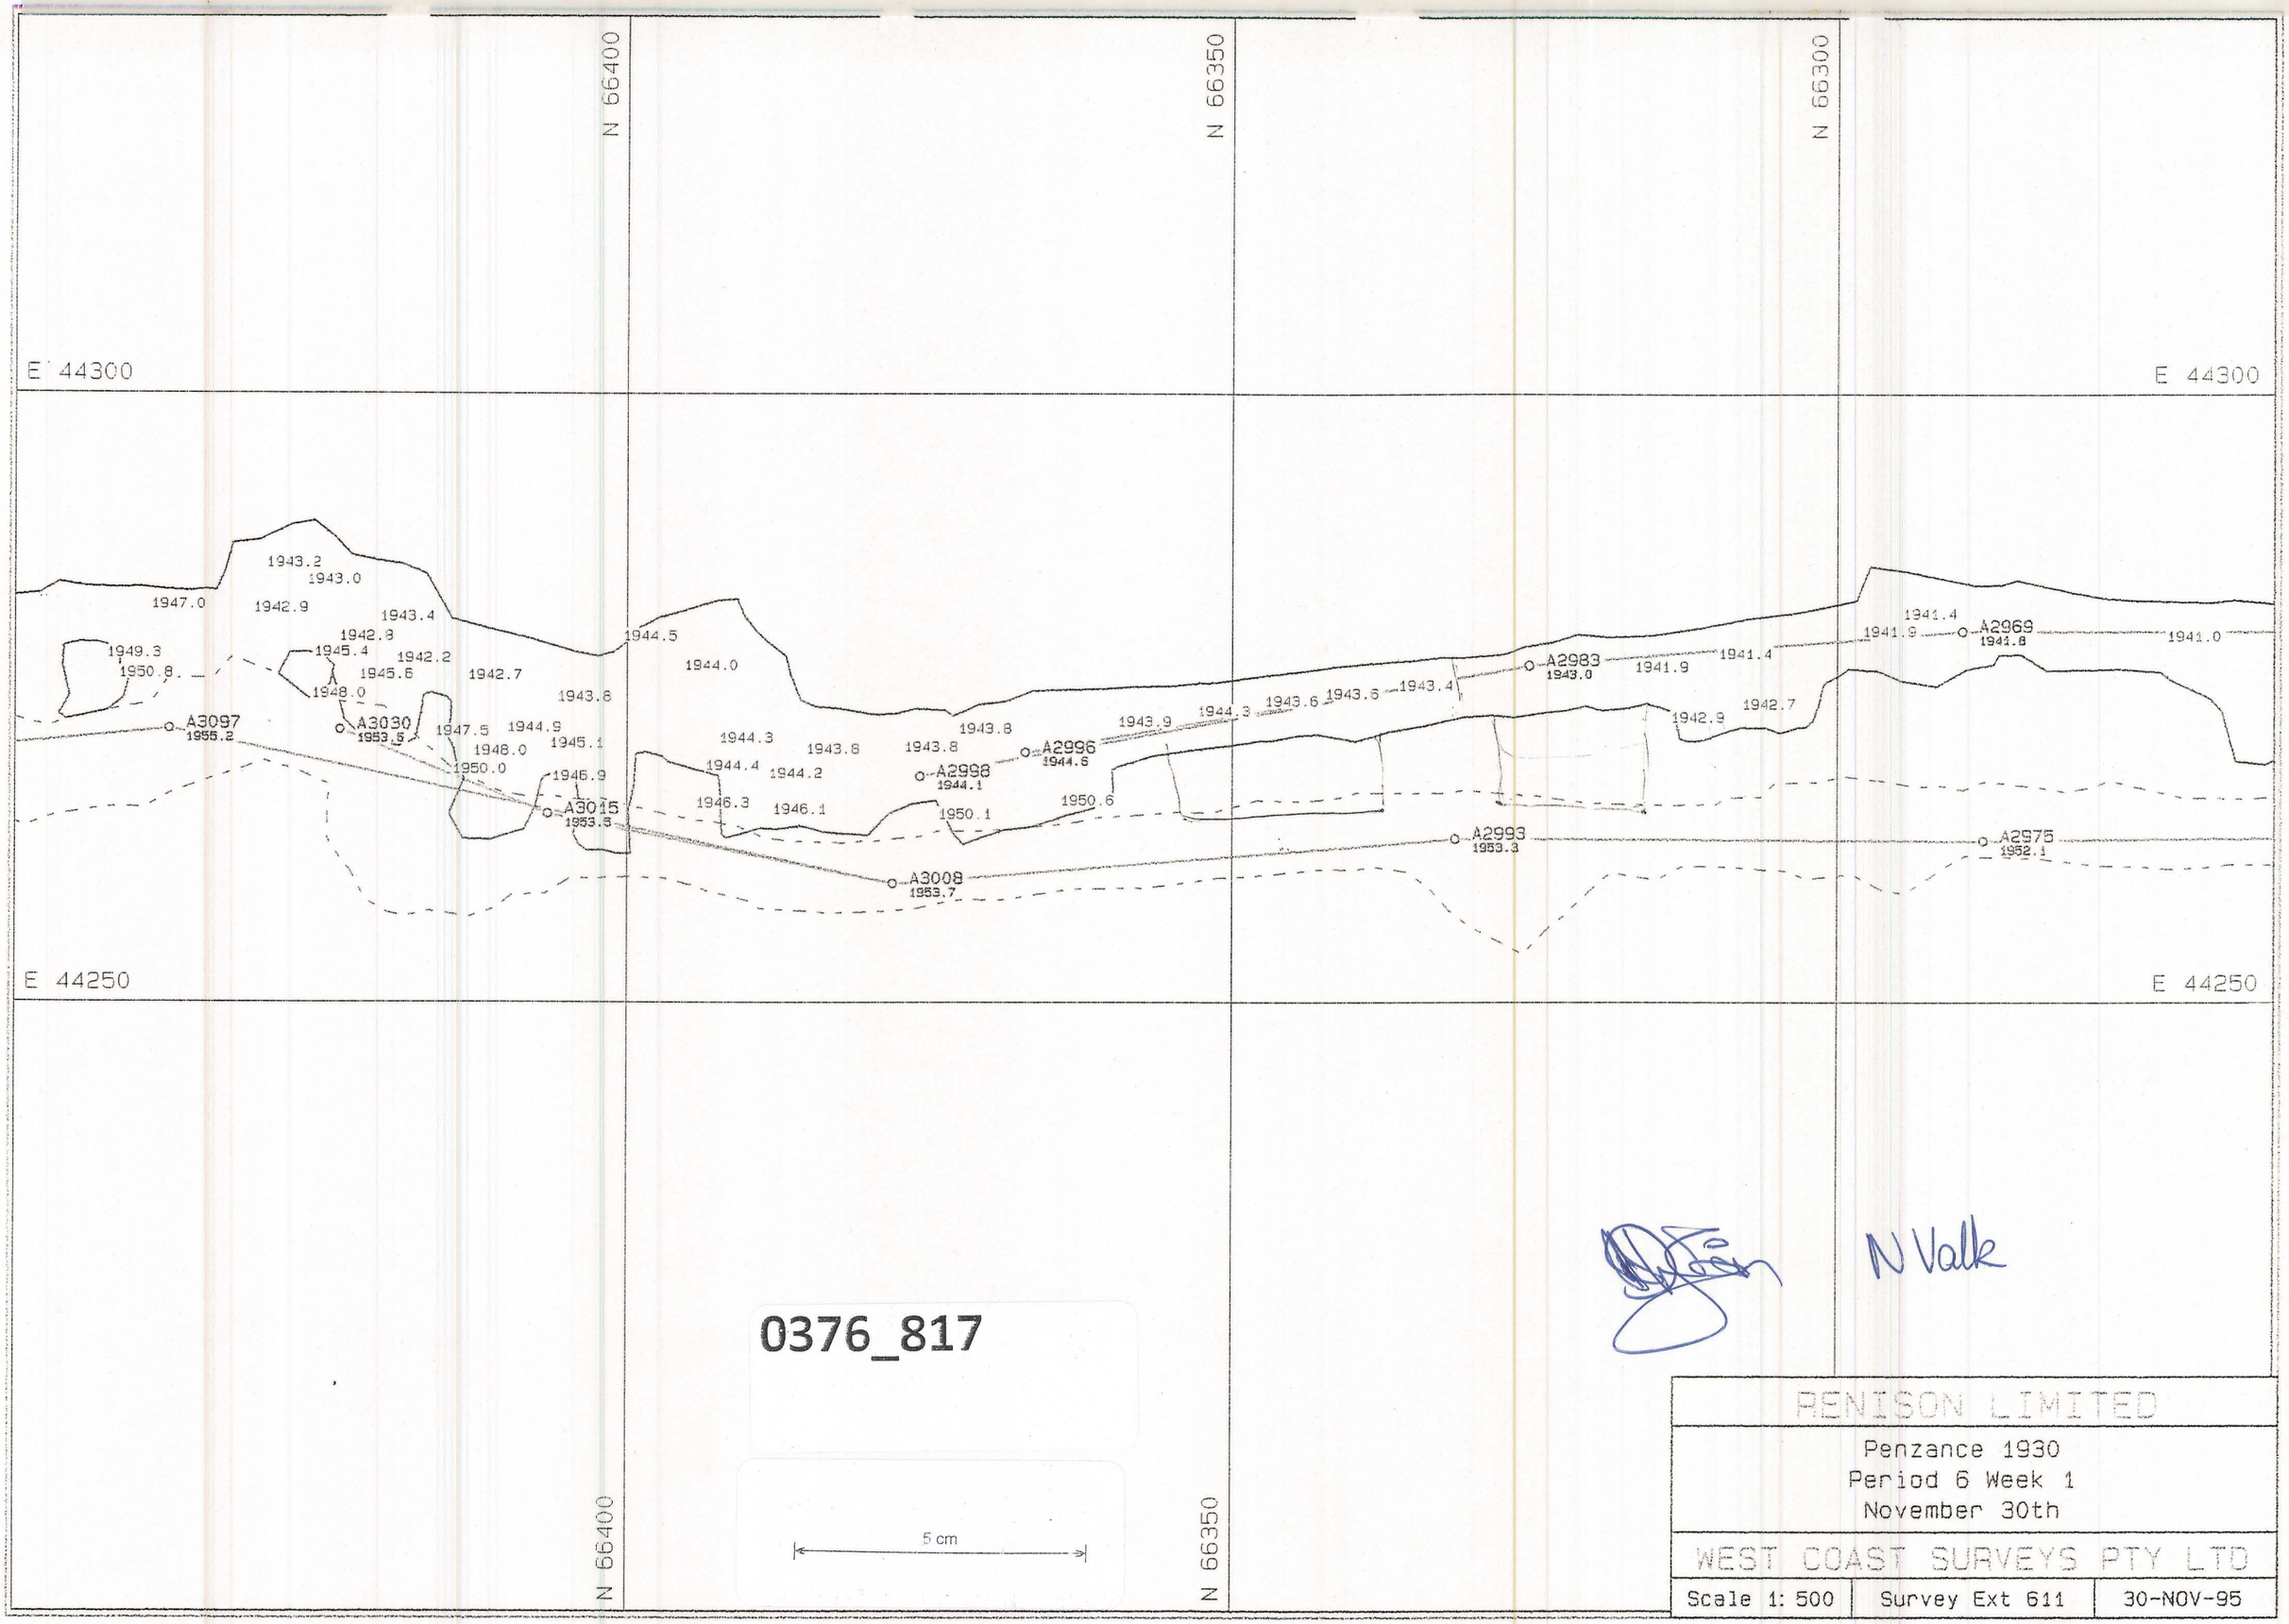

N Valk

PENISON LIMITED

Penzance 1930
Period 6 Week 1
November 30th

WEST COAST SURVEYS PTY LTD

Scale 1: 500	Survey Ext 611	30-NOV-95

PENZAB.PT

SURPAC SOFTWARE INTERNATIONAL, AUSTRALIA