


317
-01

317
-01

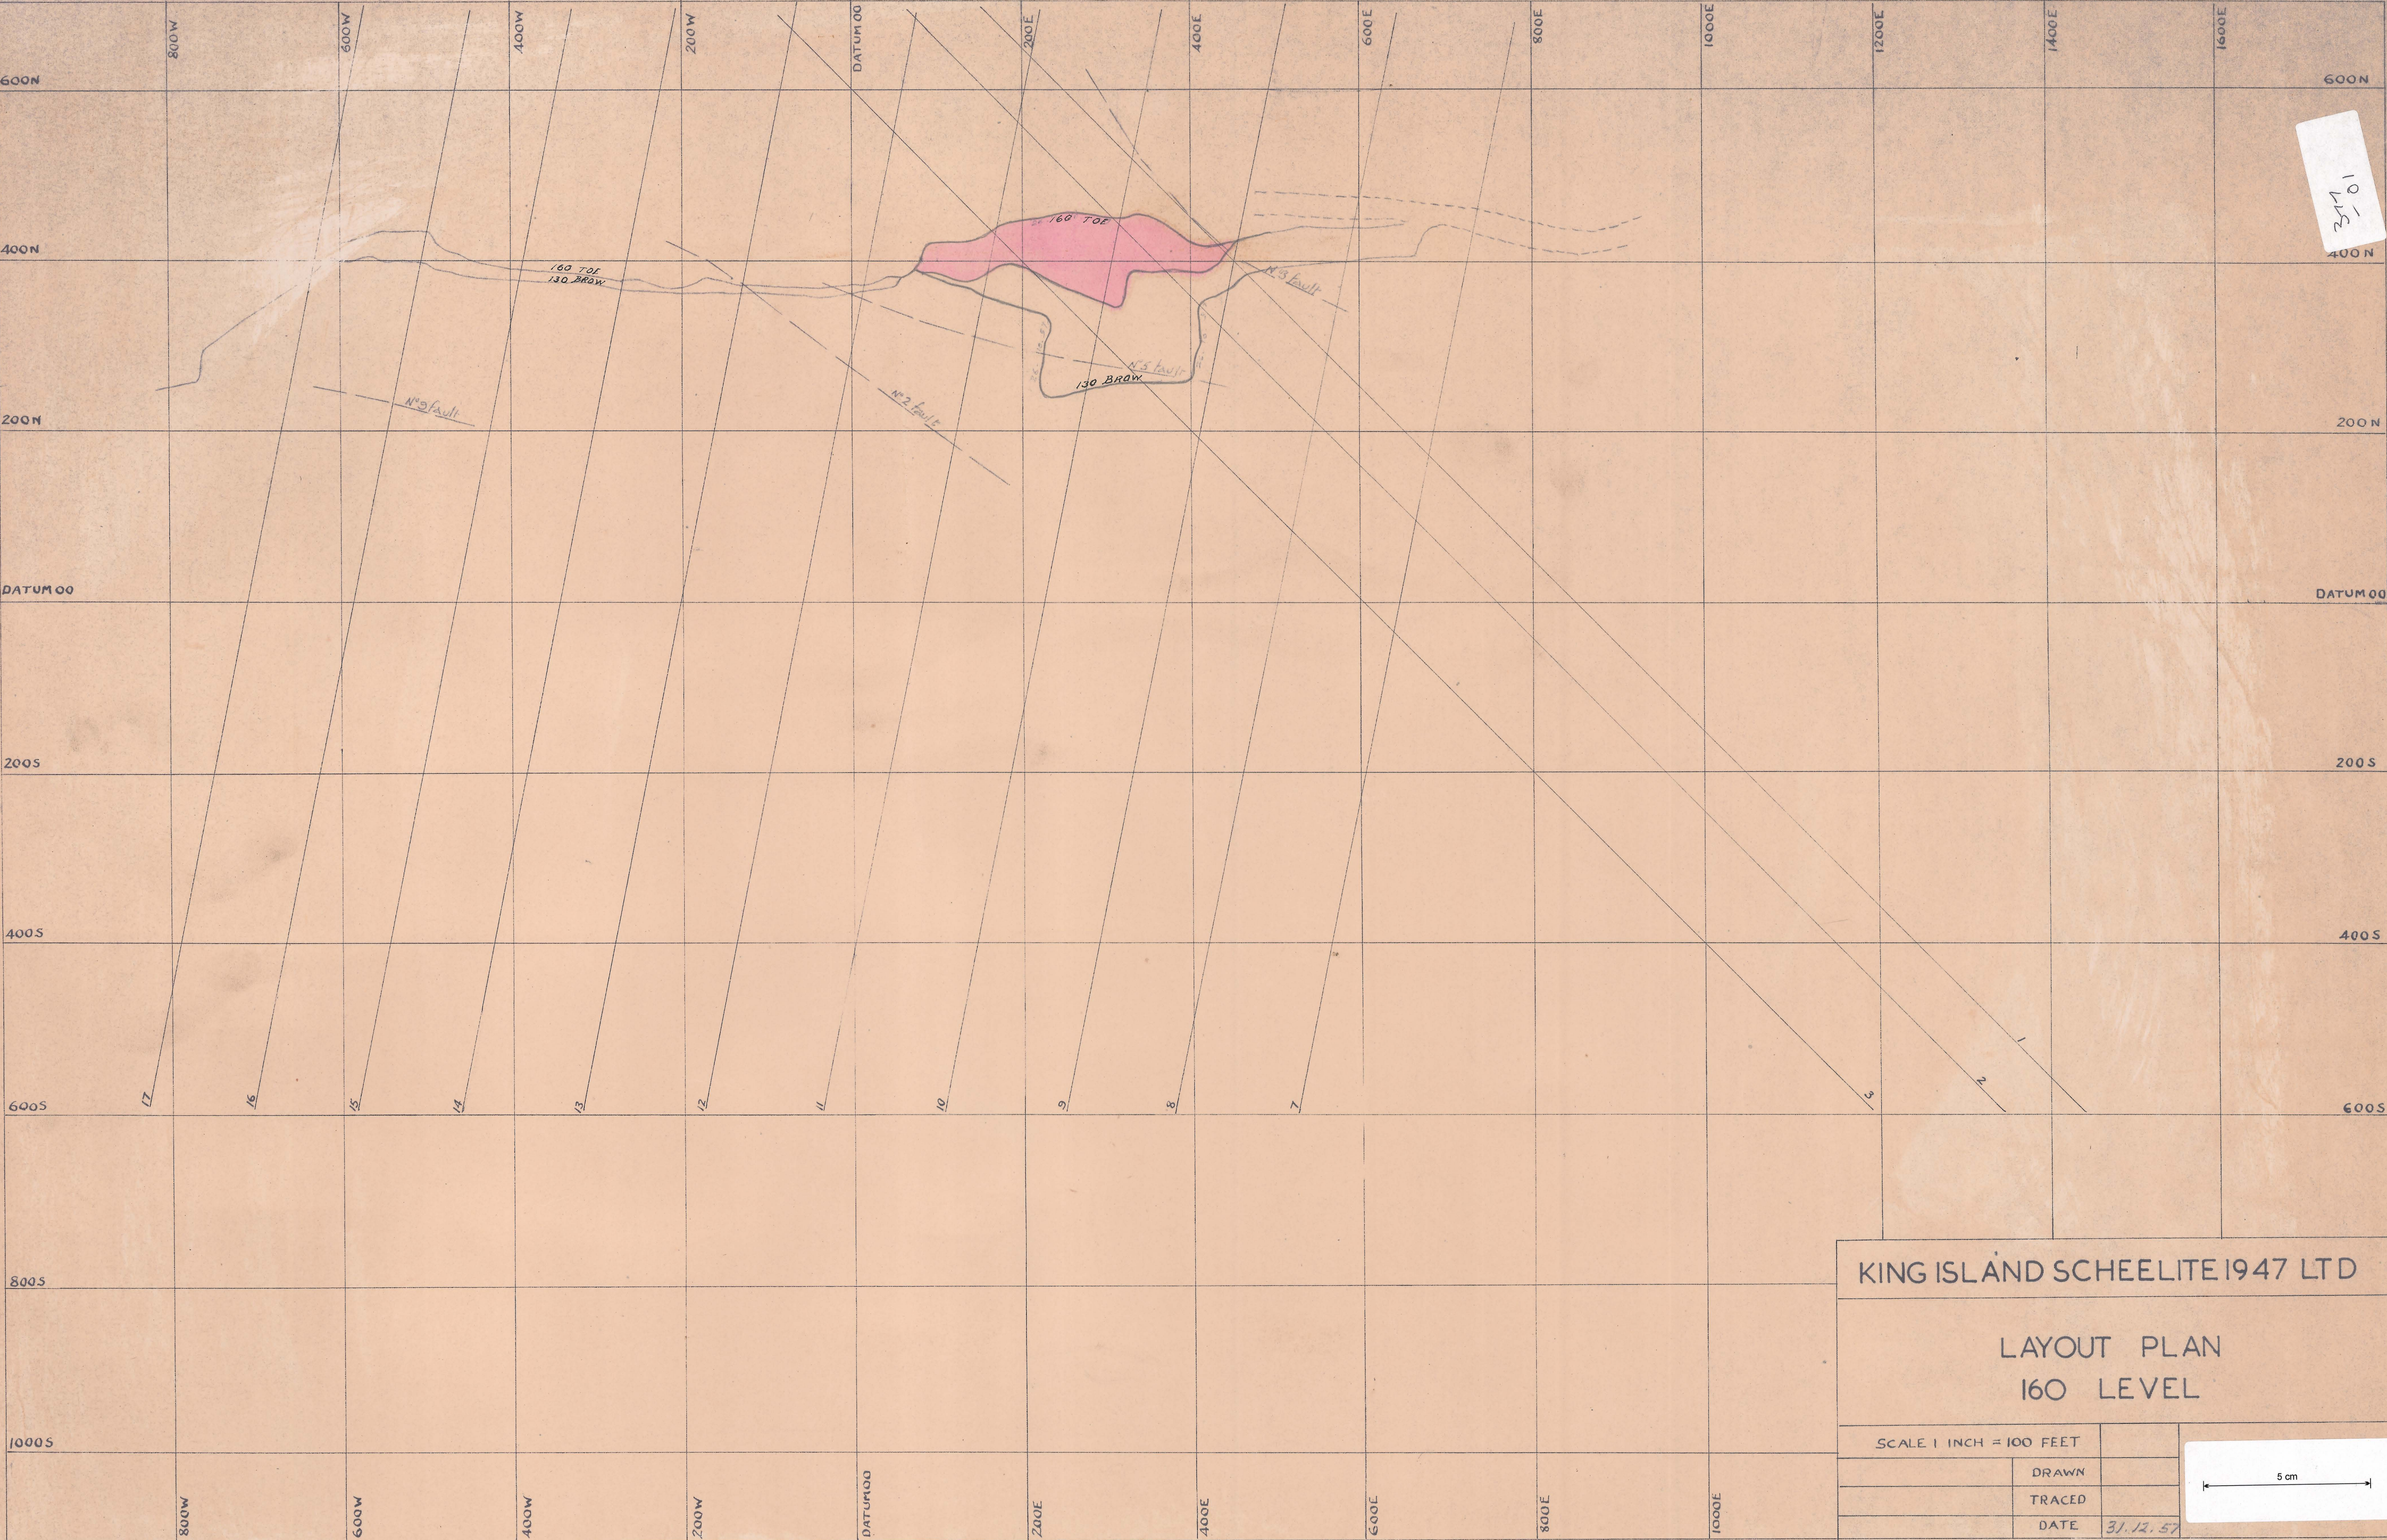

KING ISLAND SCHEELITE 1947 LTD		
LAYOUT PLAN 160 LEVEL		
SCALE 1 INCH = 100 FEET		
	DRAWN	
	TRACED	
	DATE	31.12.57

5 cm