
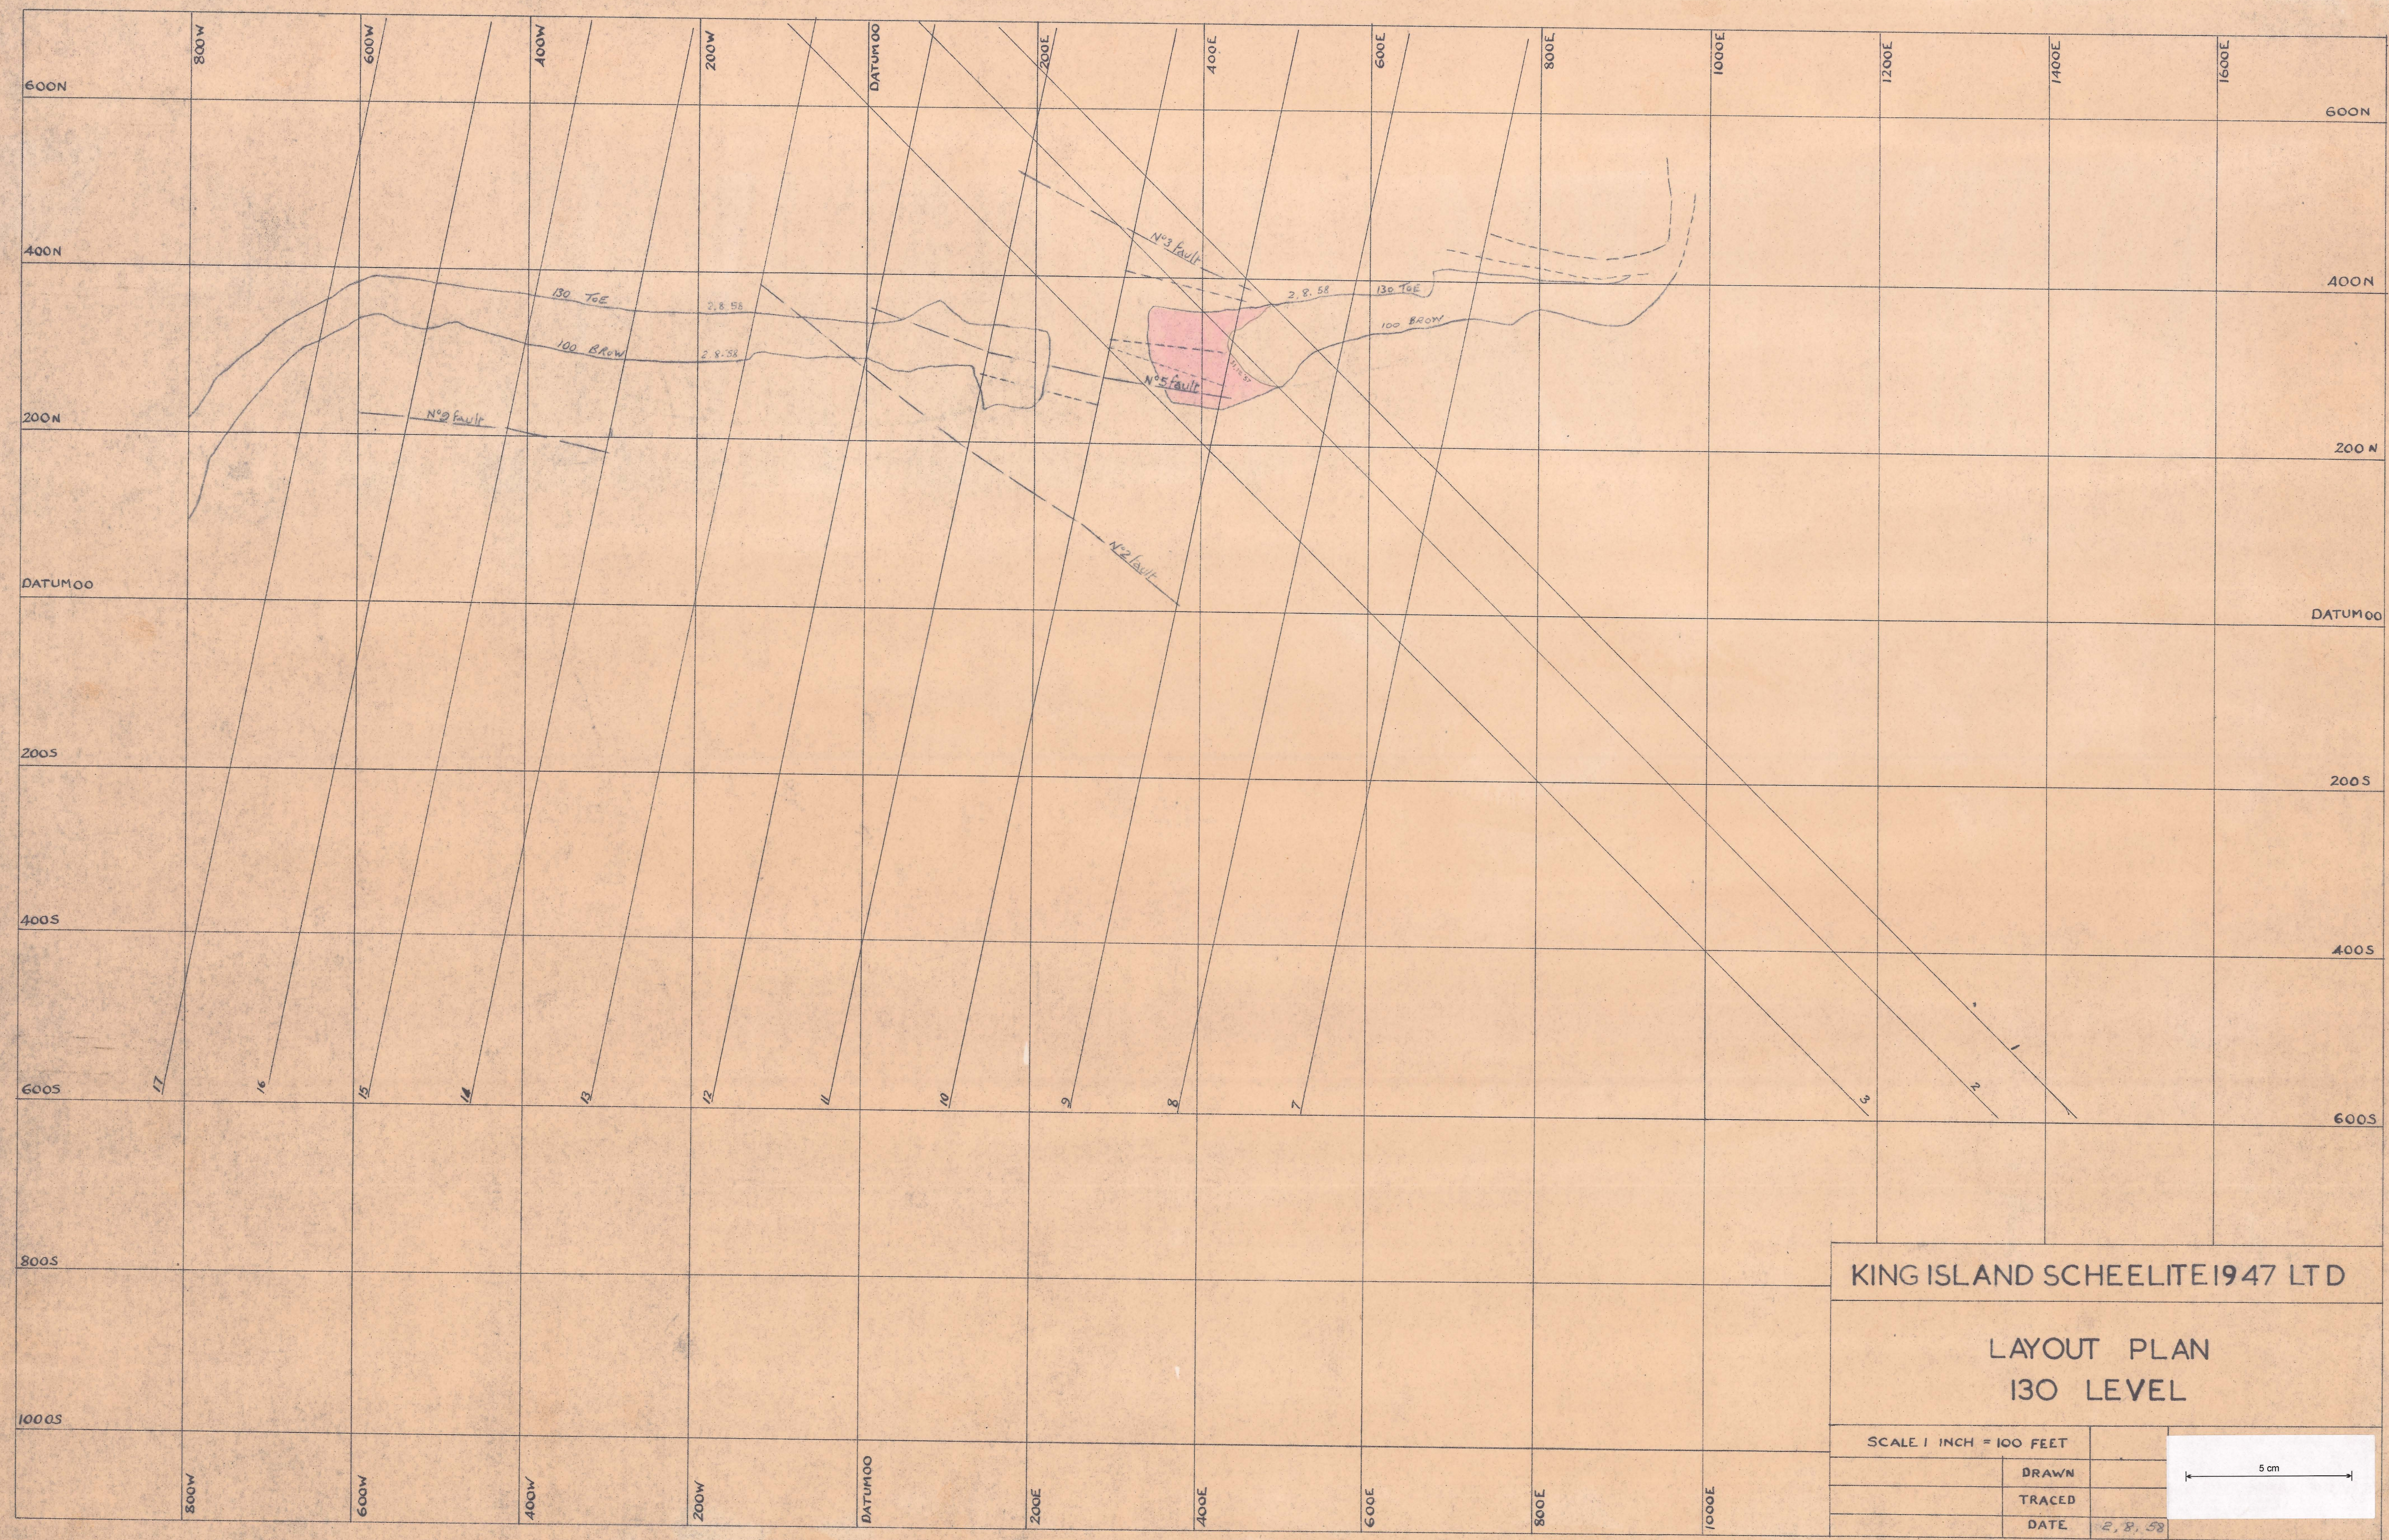


347
-15

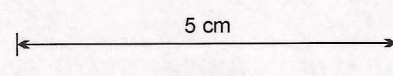

KING ISLAND SCHEELITE 1947 LTD		
LAYOUT PLAN 130 LEVEL		
SCALE 1 INCH = 100 FEET		
	DRAWN	
	TRACED	
	DATE	E. B. 58