


3-17
-16

3-17
-16

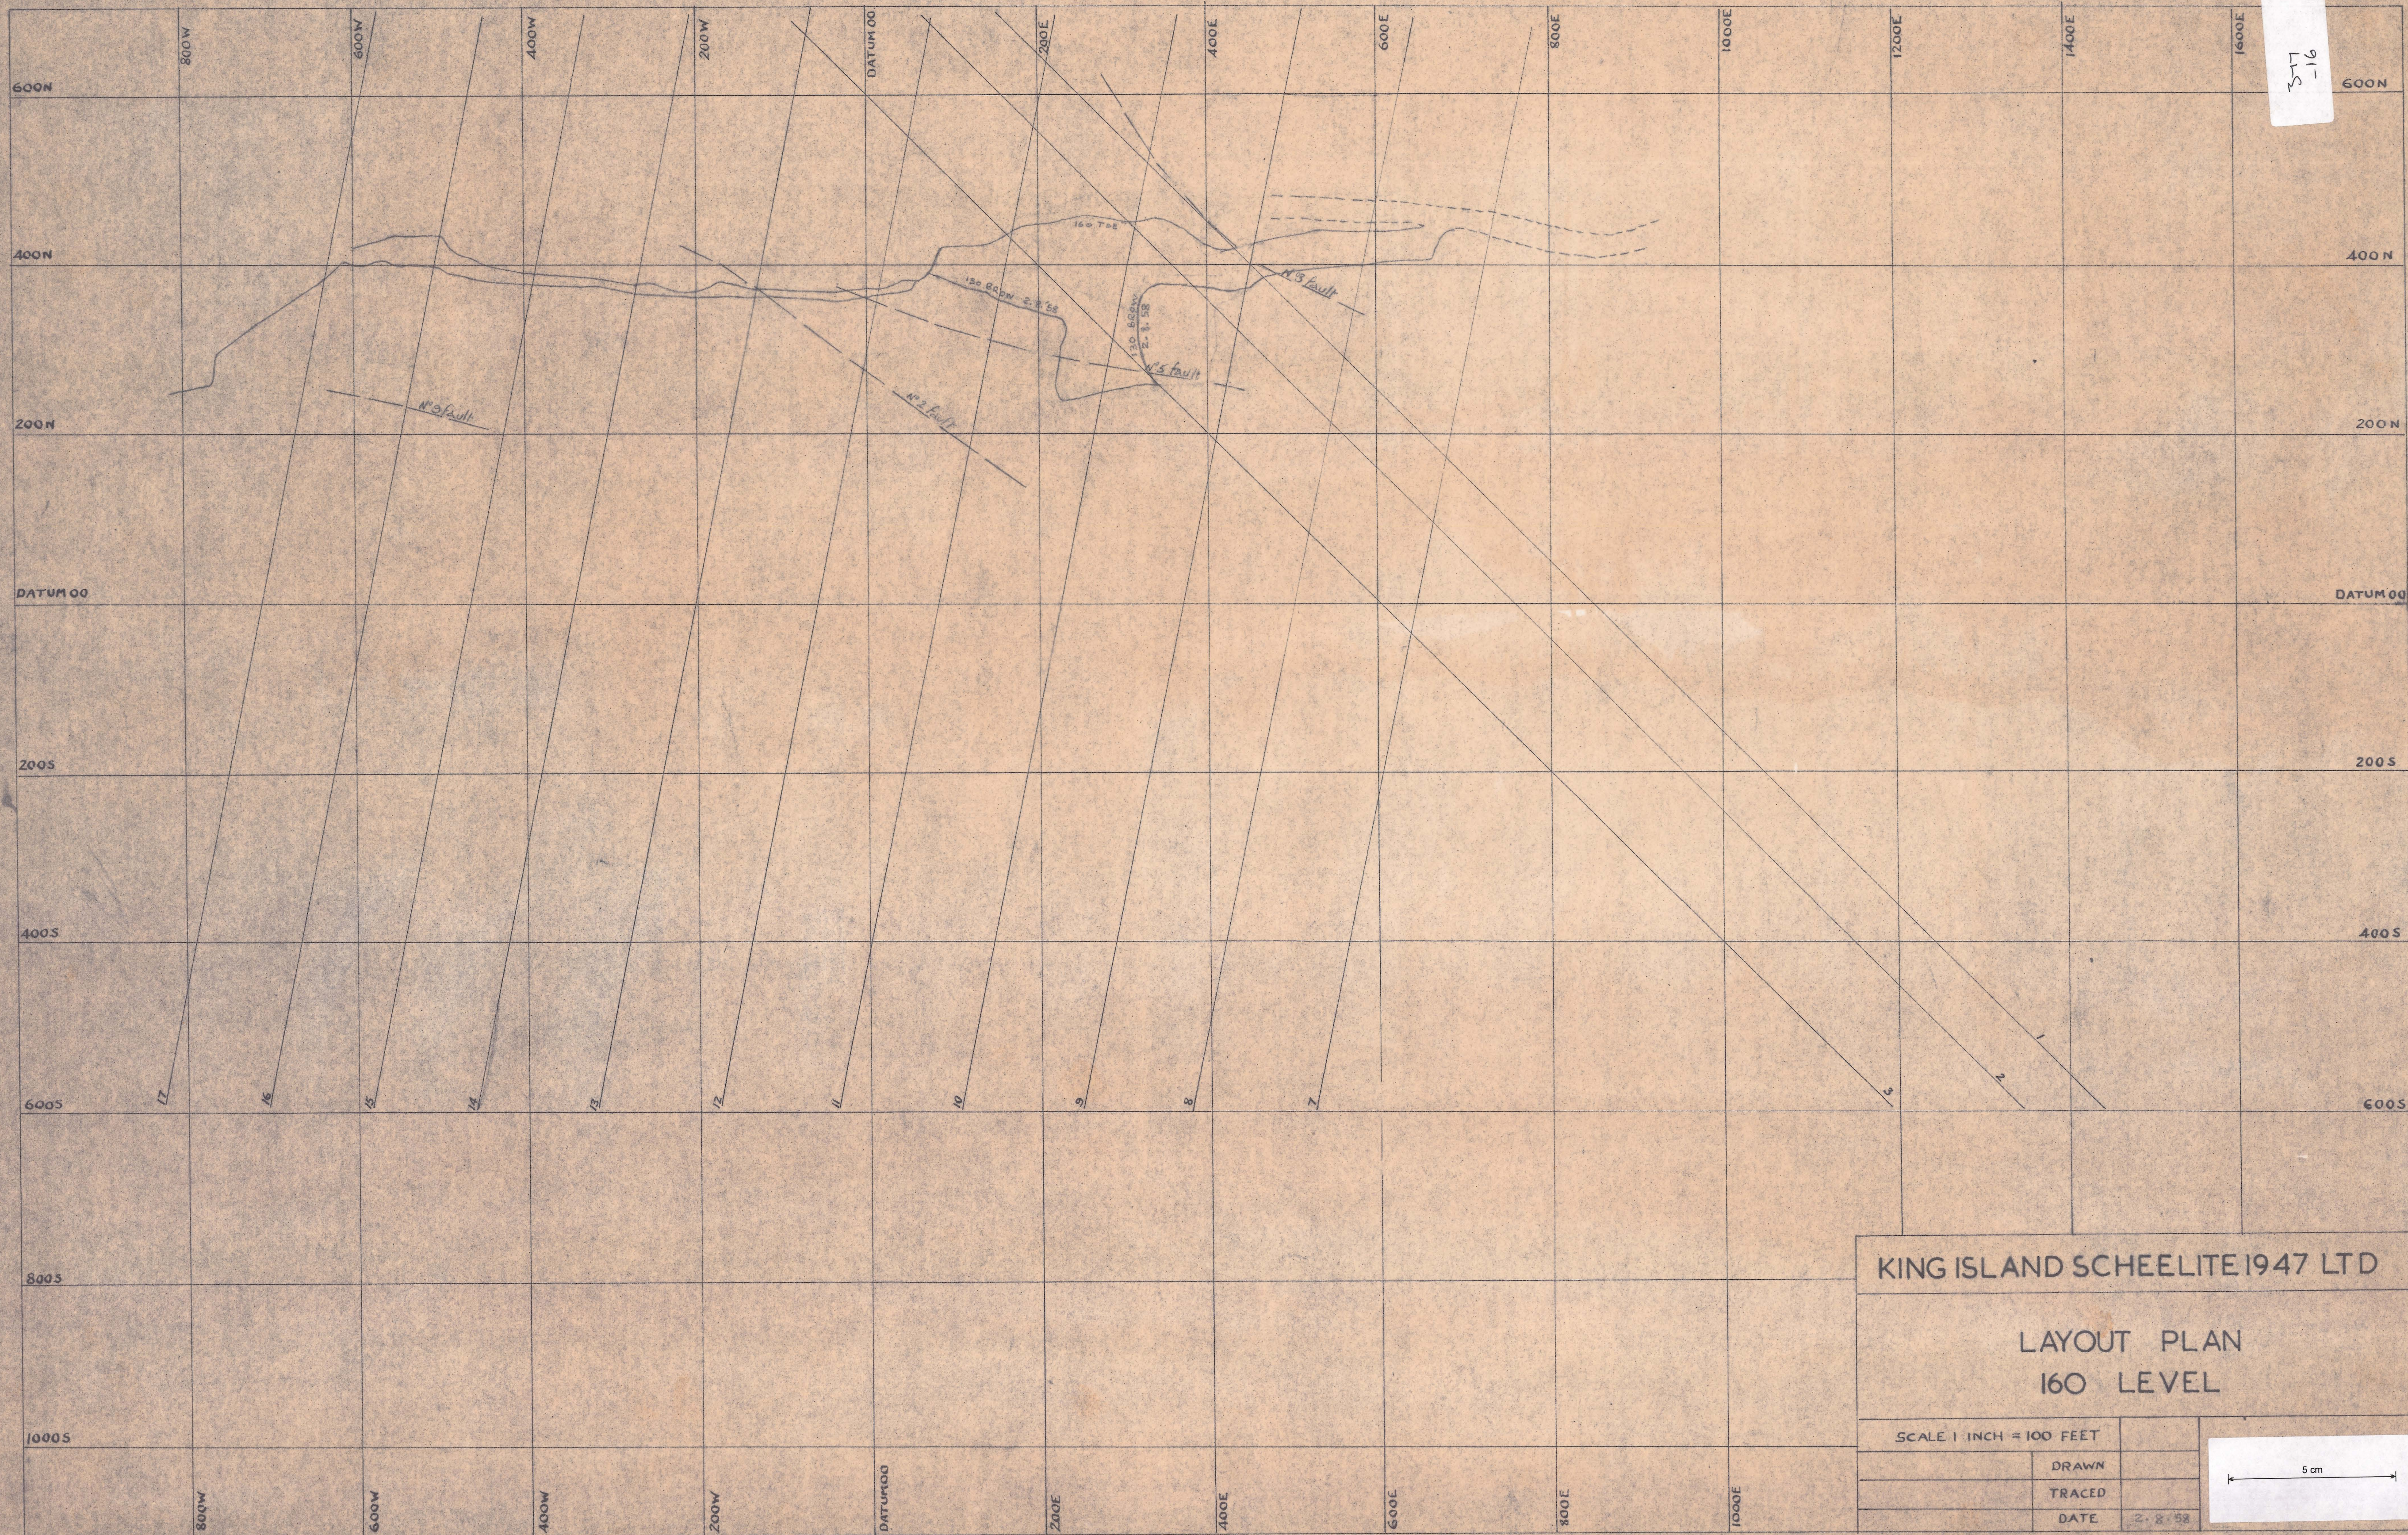

KING ISLAND SCHEELITE 1947 LTD

LAYOUT PLAN
160 LEVEL

SCALE 1 INCH = 100 FEET

DRAWN

TRACED

DATE

2-8-58

5 cm