


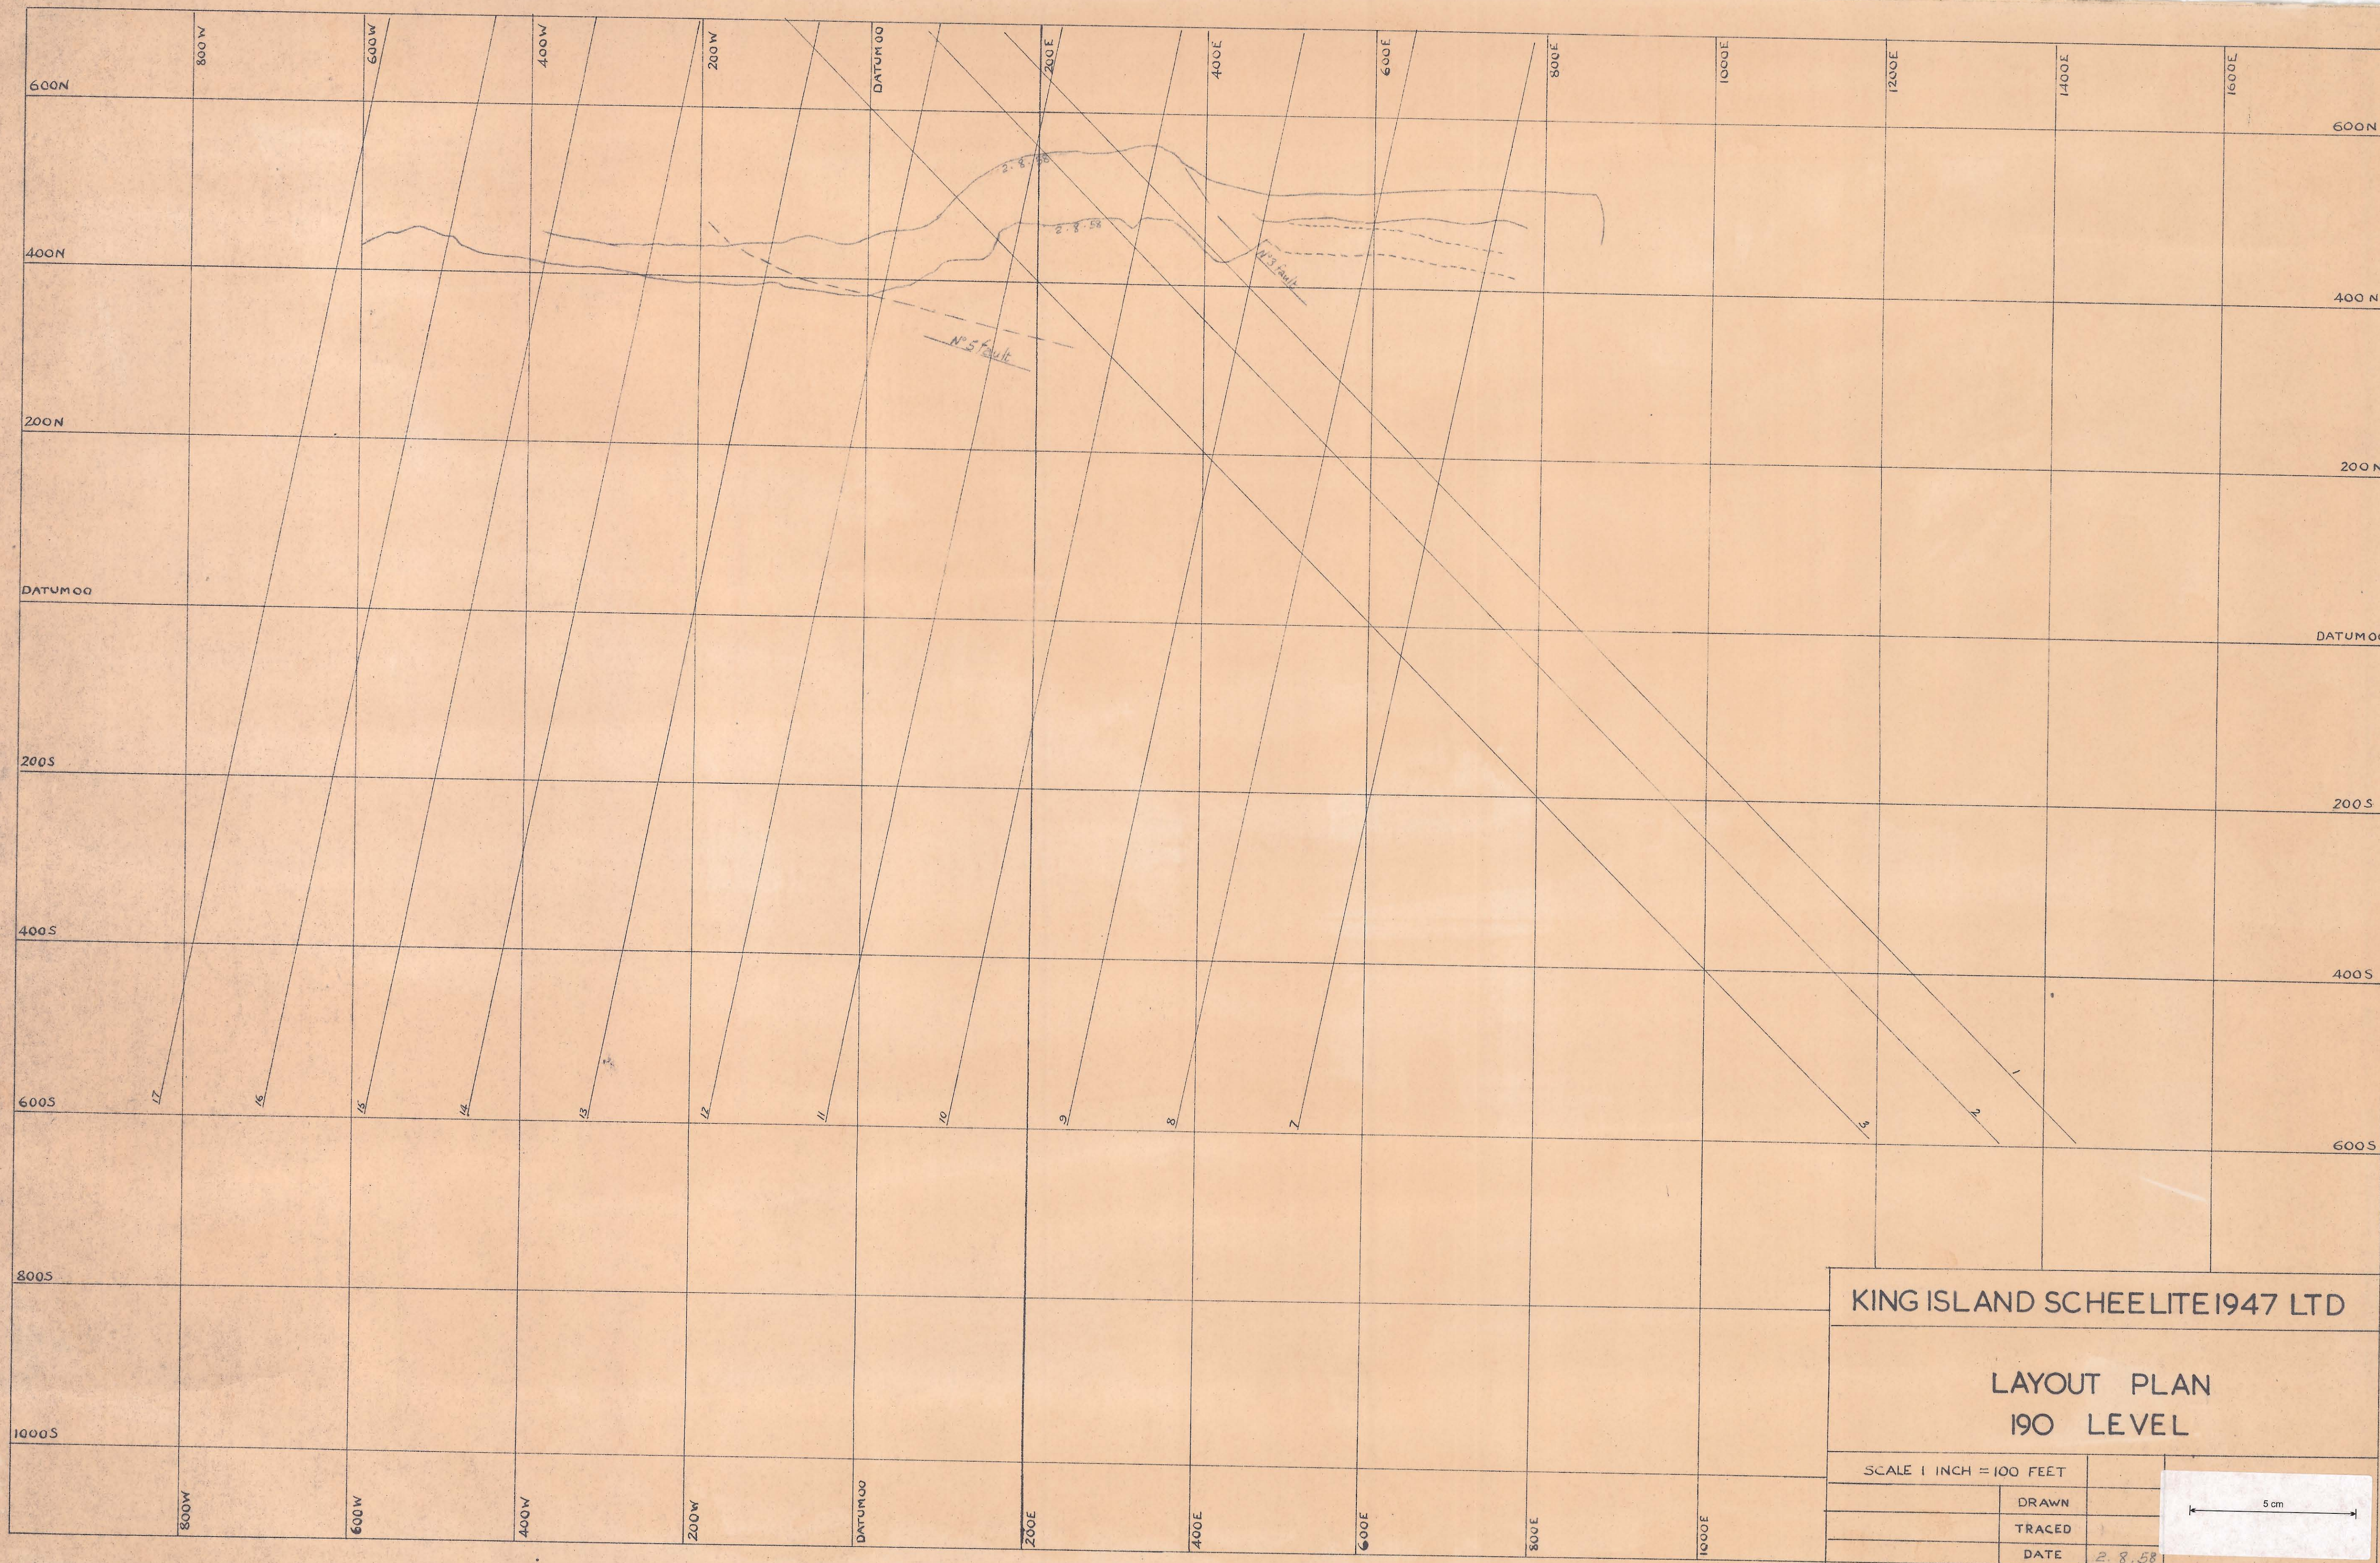

377-30