


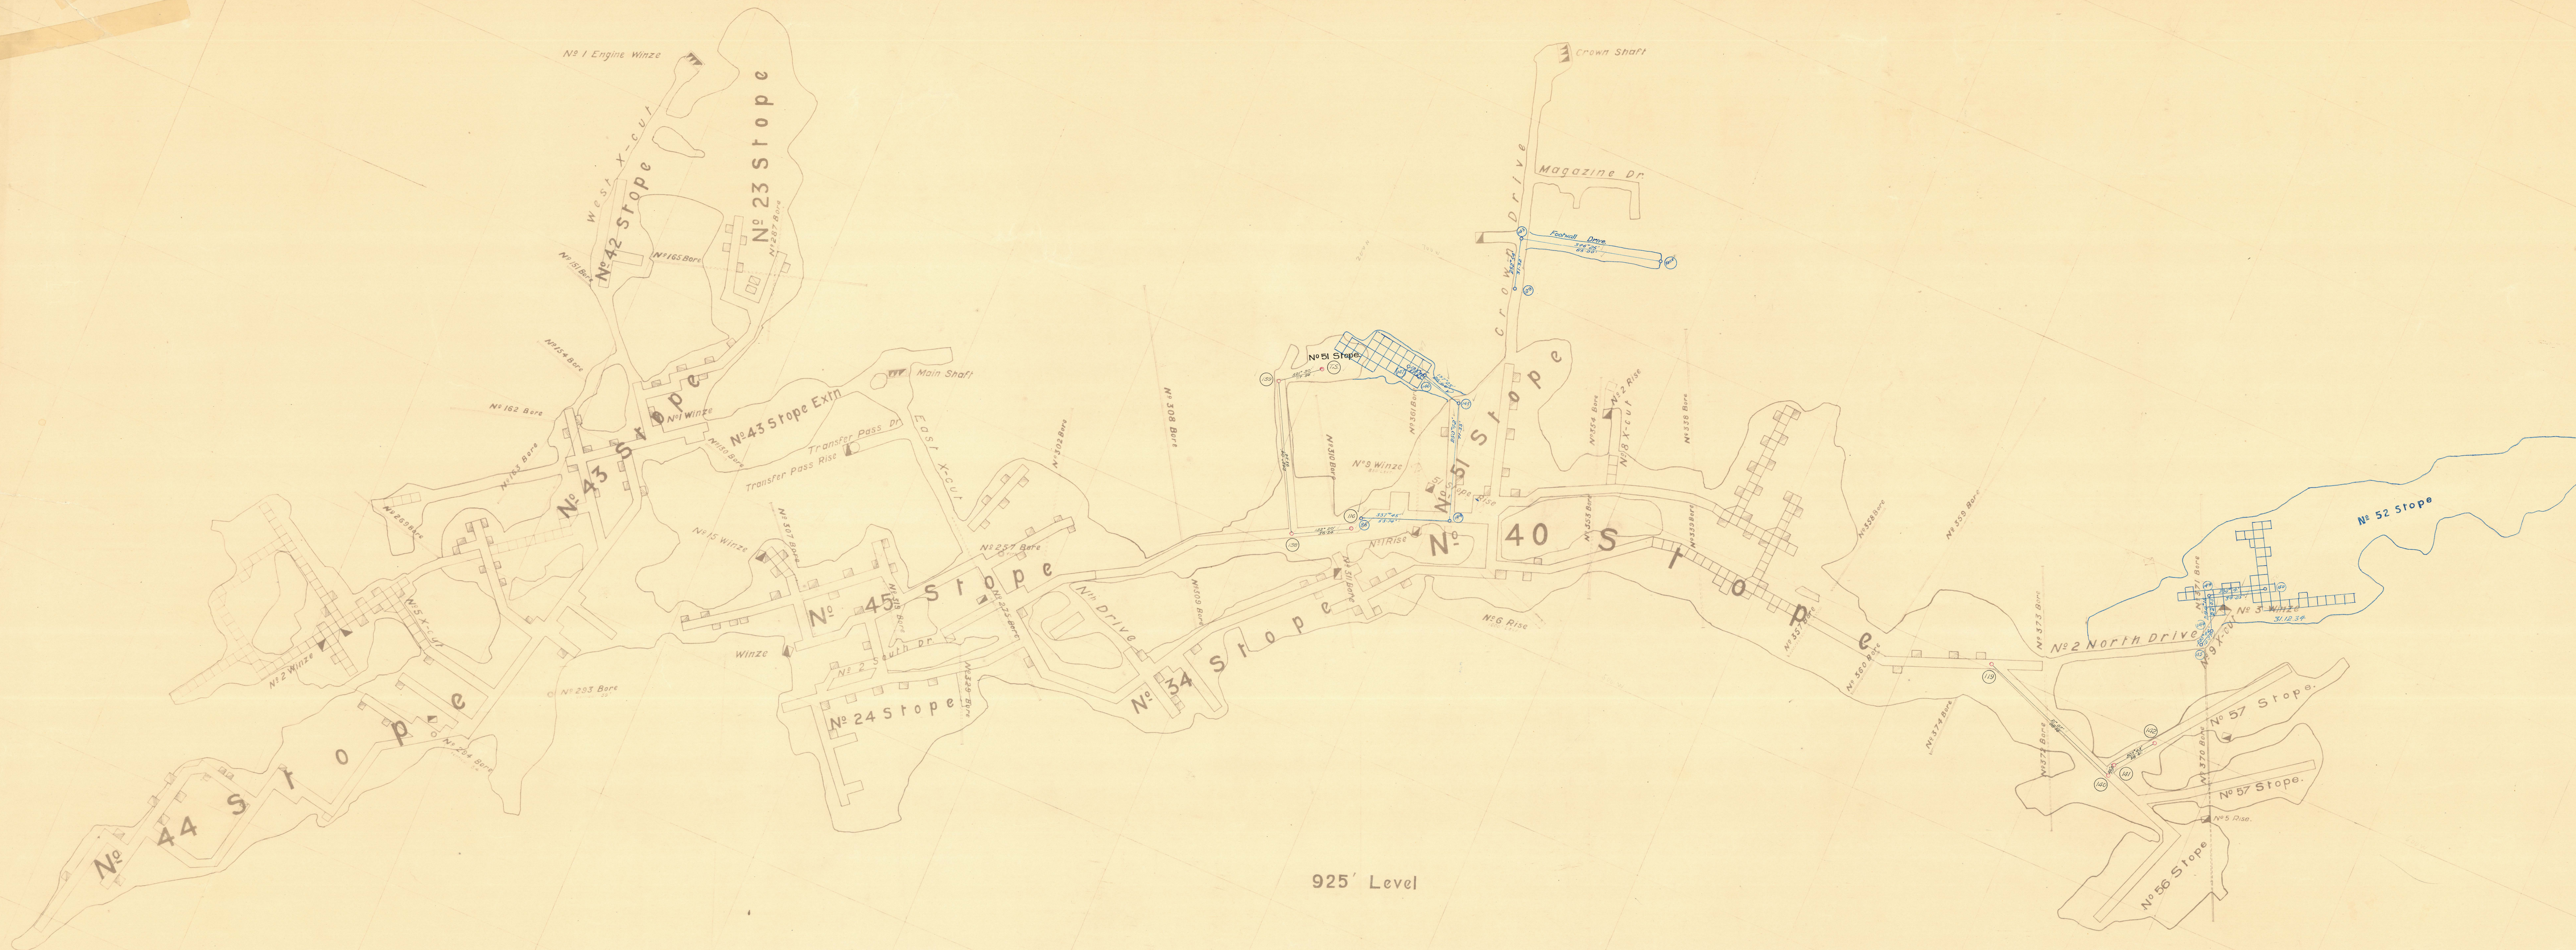

The Mount Lyell Mining & Railway Co., Ltd.

Mine Department.

DETAIL PLAN - UNDERGROUND WORKINGS.

NORTH LYELL MINE.

SCALE 1 INCH = 30 FEET

R. H. Murray GENERAL MANAGER
S. H. J. Jones MINE SUPERINTENDENT

