


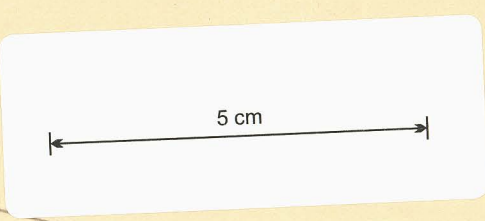

700' LEVEL



The Mount Lyell Mining & Railway Co., Ltd.

Mine Department.

DETAIL PLAN - UNDERGROUND WORKINGS.

NORTH LYELL MINE.

SCALE 1 INCH = 30 FEET

[Signature] GENERAL MANAGER.
[Signature] MINE SUPERINTENDENT.

