


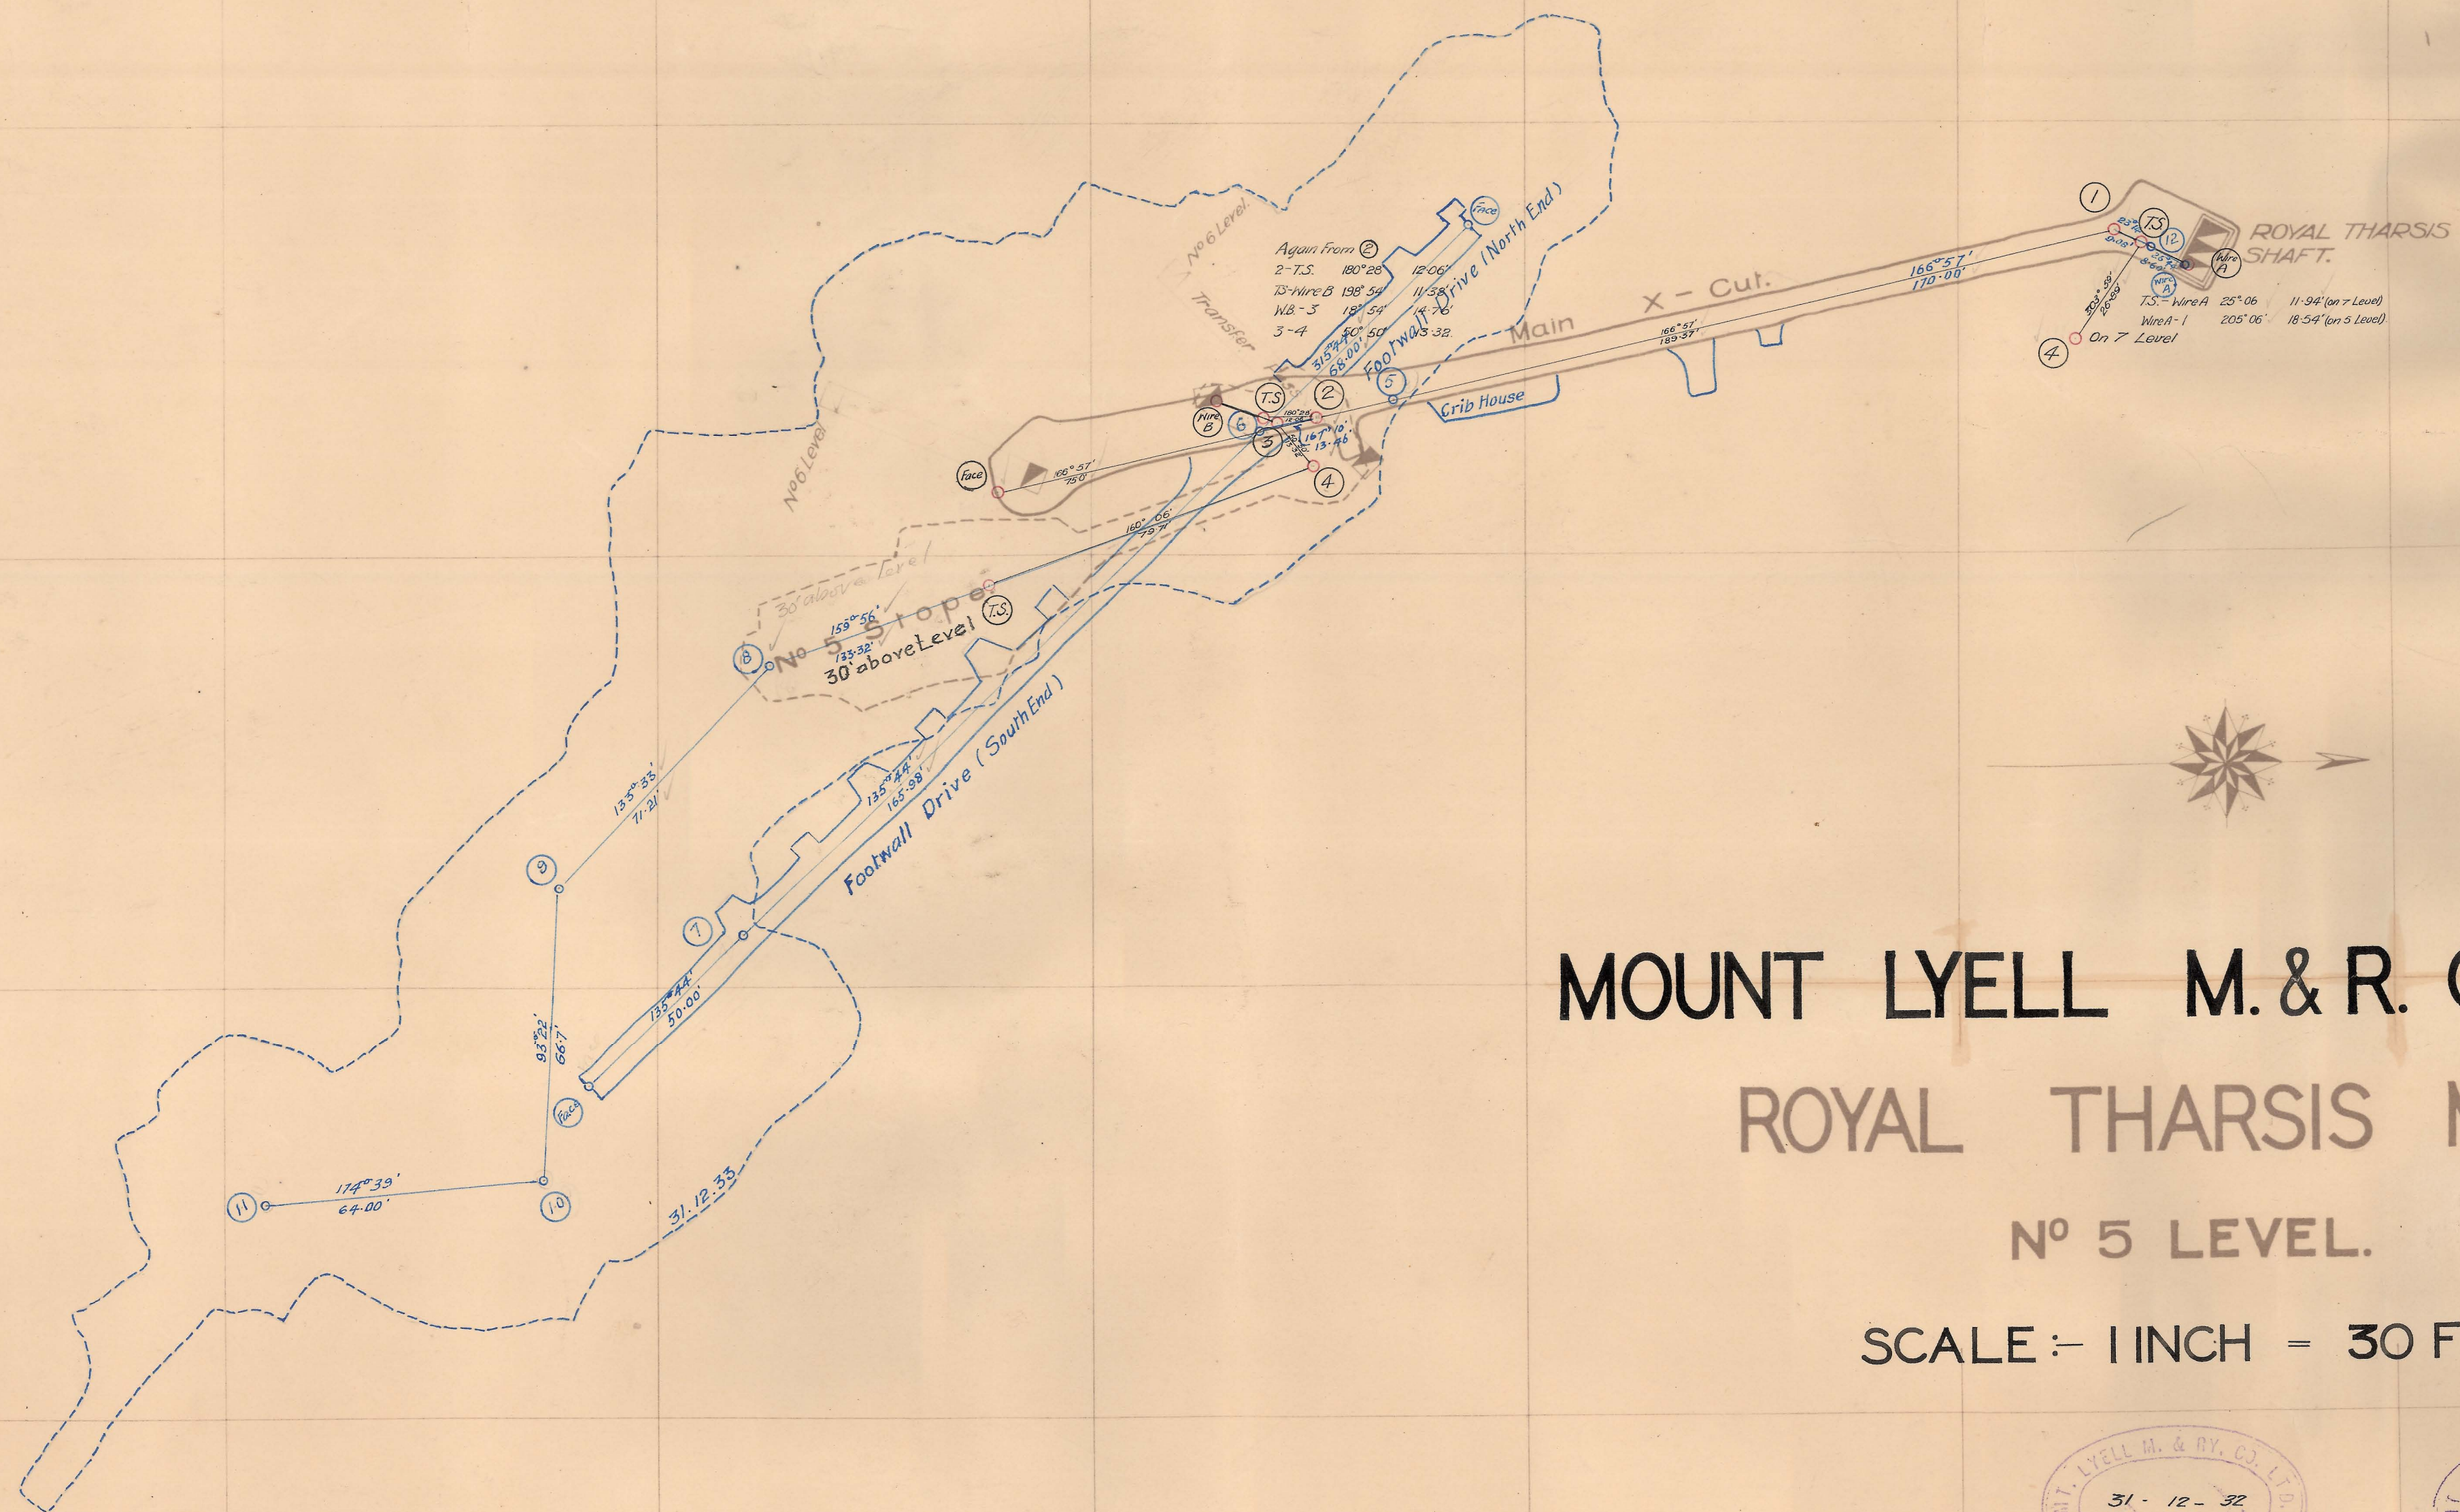

MOUNT LYELL M. & R. CO. LTD.

ROYAL THARSIS MINE.

No 5 LEVEL.

SCALE :- 1 INCH = 30 FEET.



R. J. Murray GENERAL MANAGER.
S. Red. Jenkins MINE SUPERINTENDENT.