378 - 31

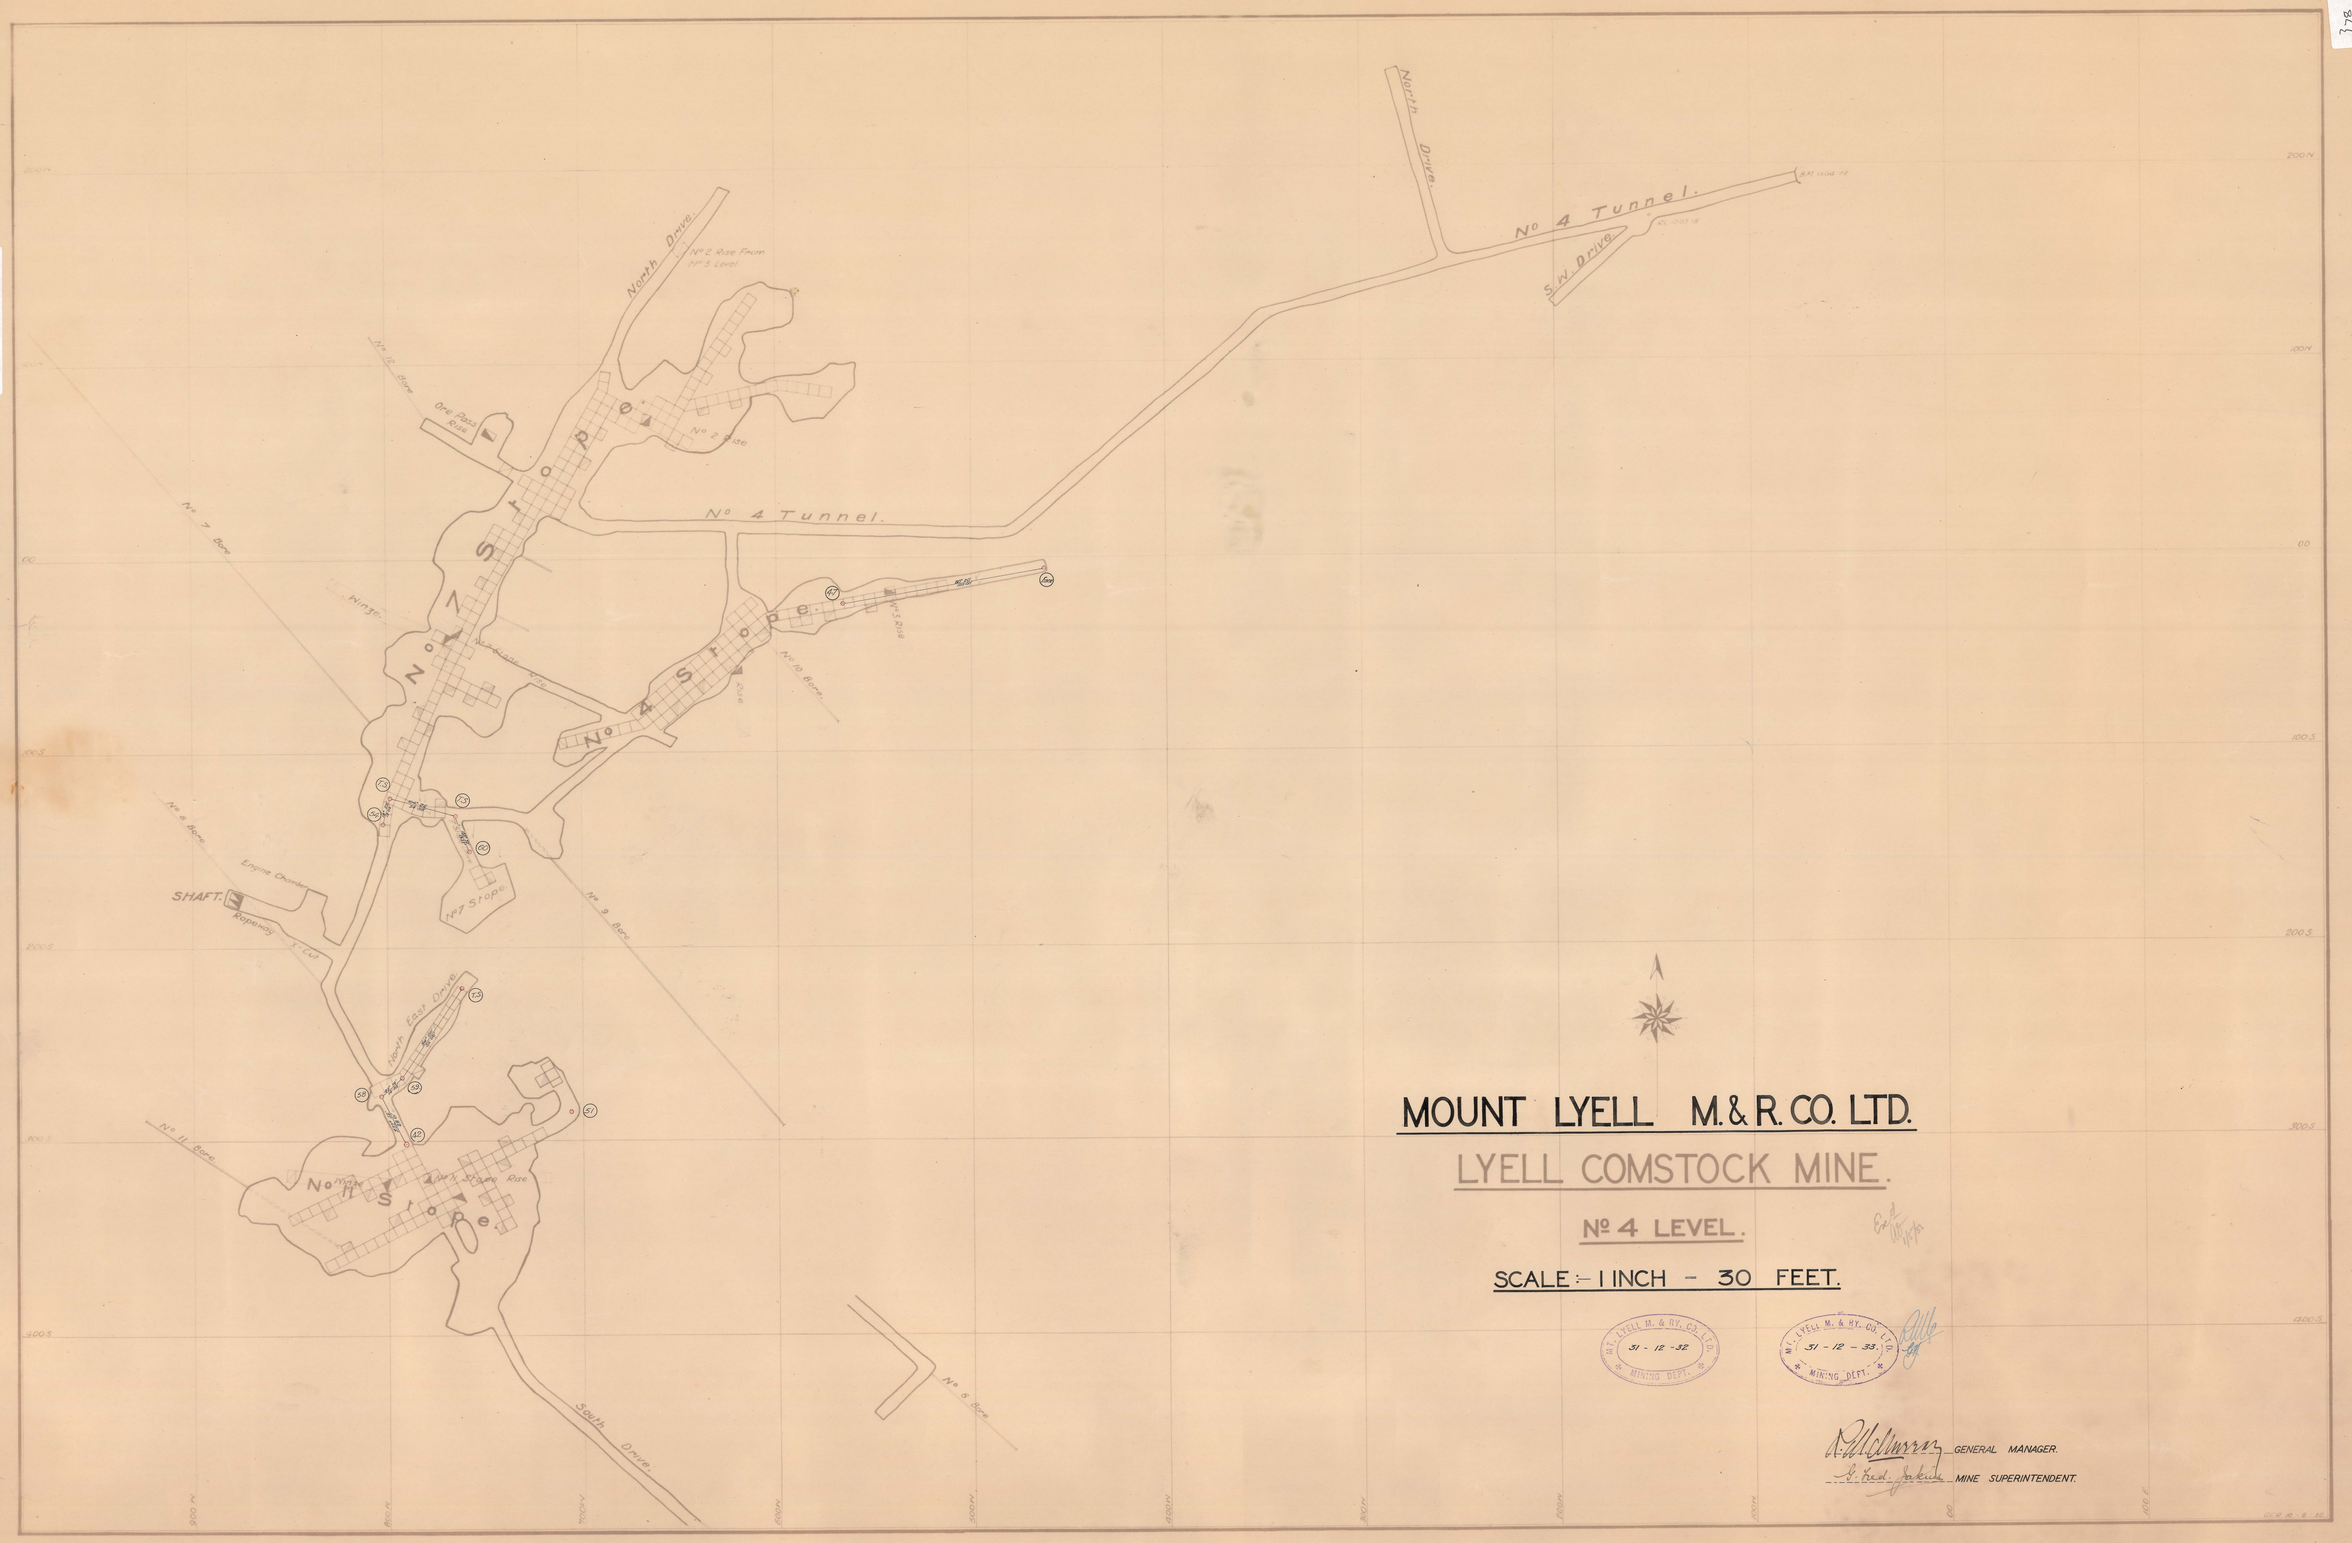

MOUNT LYELL M. & R. CO. LTD.

LYELL COMSTOCK MINE.

No 4 LEVEL.

SCALE :- 1 INCH - 30 FEET.

MT. LYELL M. & RY. CO. LTD. 31 - 12 - 32 MINING DEPT.

MT. LYELL M. & RY. CO. LTD. 31 - 12 - 33. MINING DEPT.

A. McCurry GENERAL MANAGER.

J. Red. Jackson MINE SUPERINTENDENT.

378 - 31