0381_010

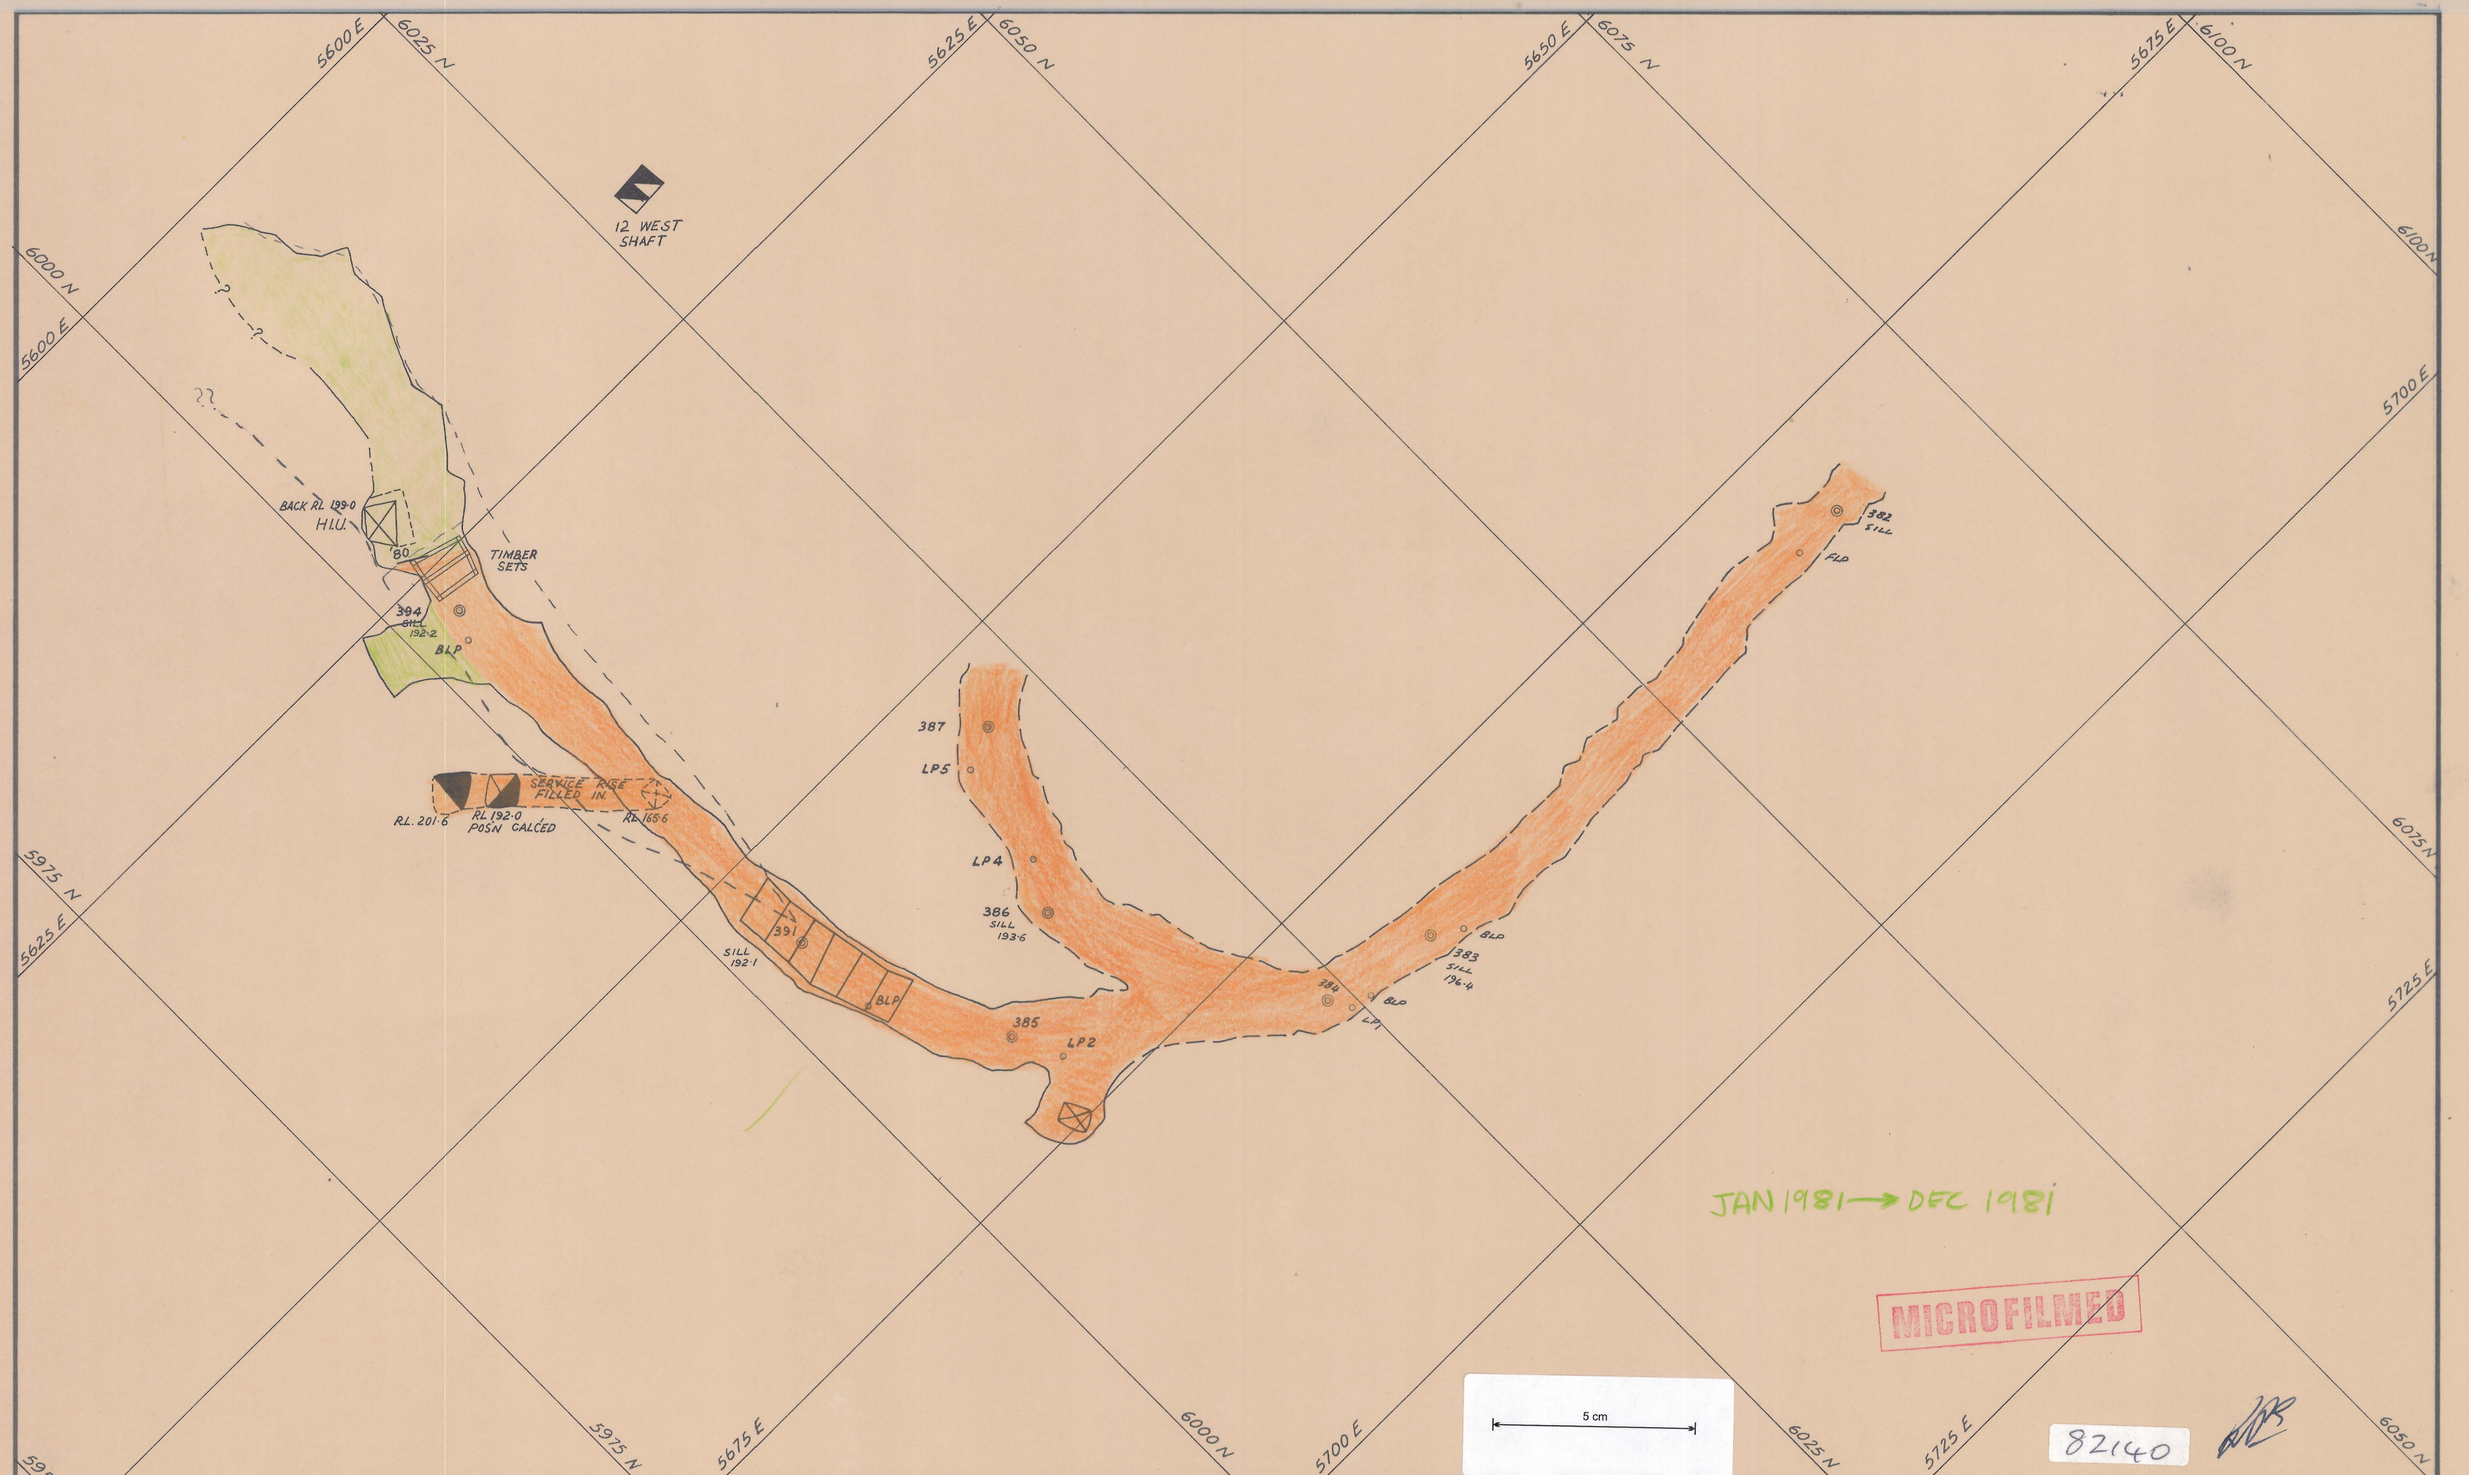

JAN 1981 → DEC 1981

MICROFILMED

82140

Nº	DATE	APPD	AMENDMENT

MOUNT LYELL M. & R. CO. LTD.
MINE DEPARTMENT

12 WEST MINE
192 m LEVEL
& DECLINE TO 182m LEVEL

Scale 1:250	Surveyed	APPROVED	DRAWING Nº
Date MAY 1980	Designed	U/G Mgr	A2-72
	Drawn KRB.	C/M Eng	
	Traced	C/Survr	
	Checked	C/Geol	SHEET Nº
	Checked	Mine Supt	Indexed KPS.
			Drawer Nº