0381 - 016

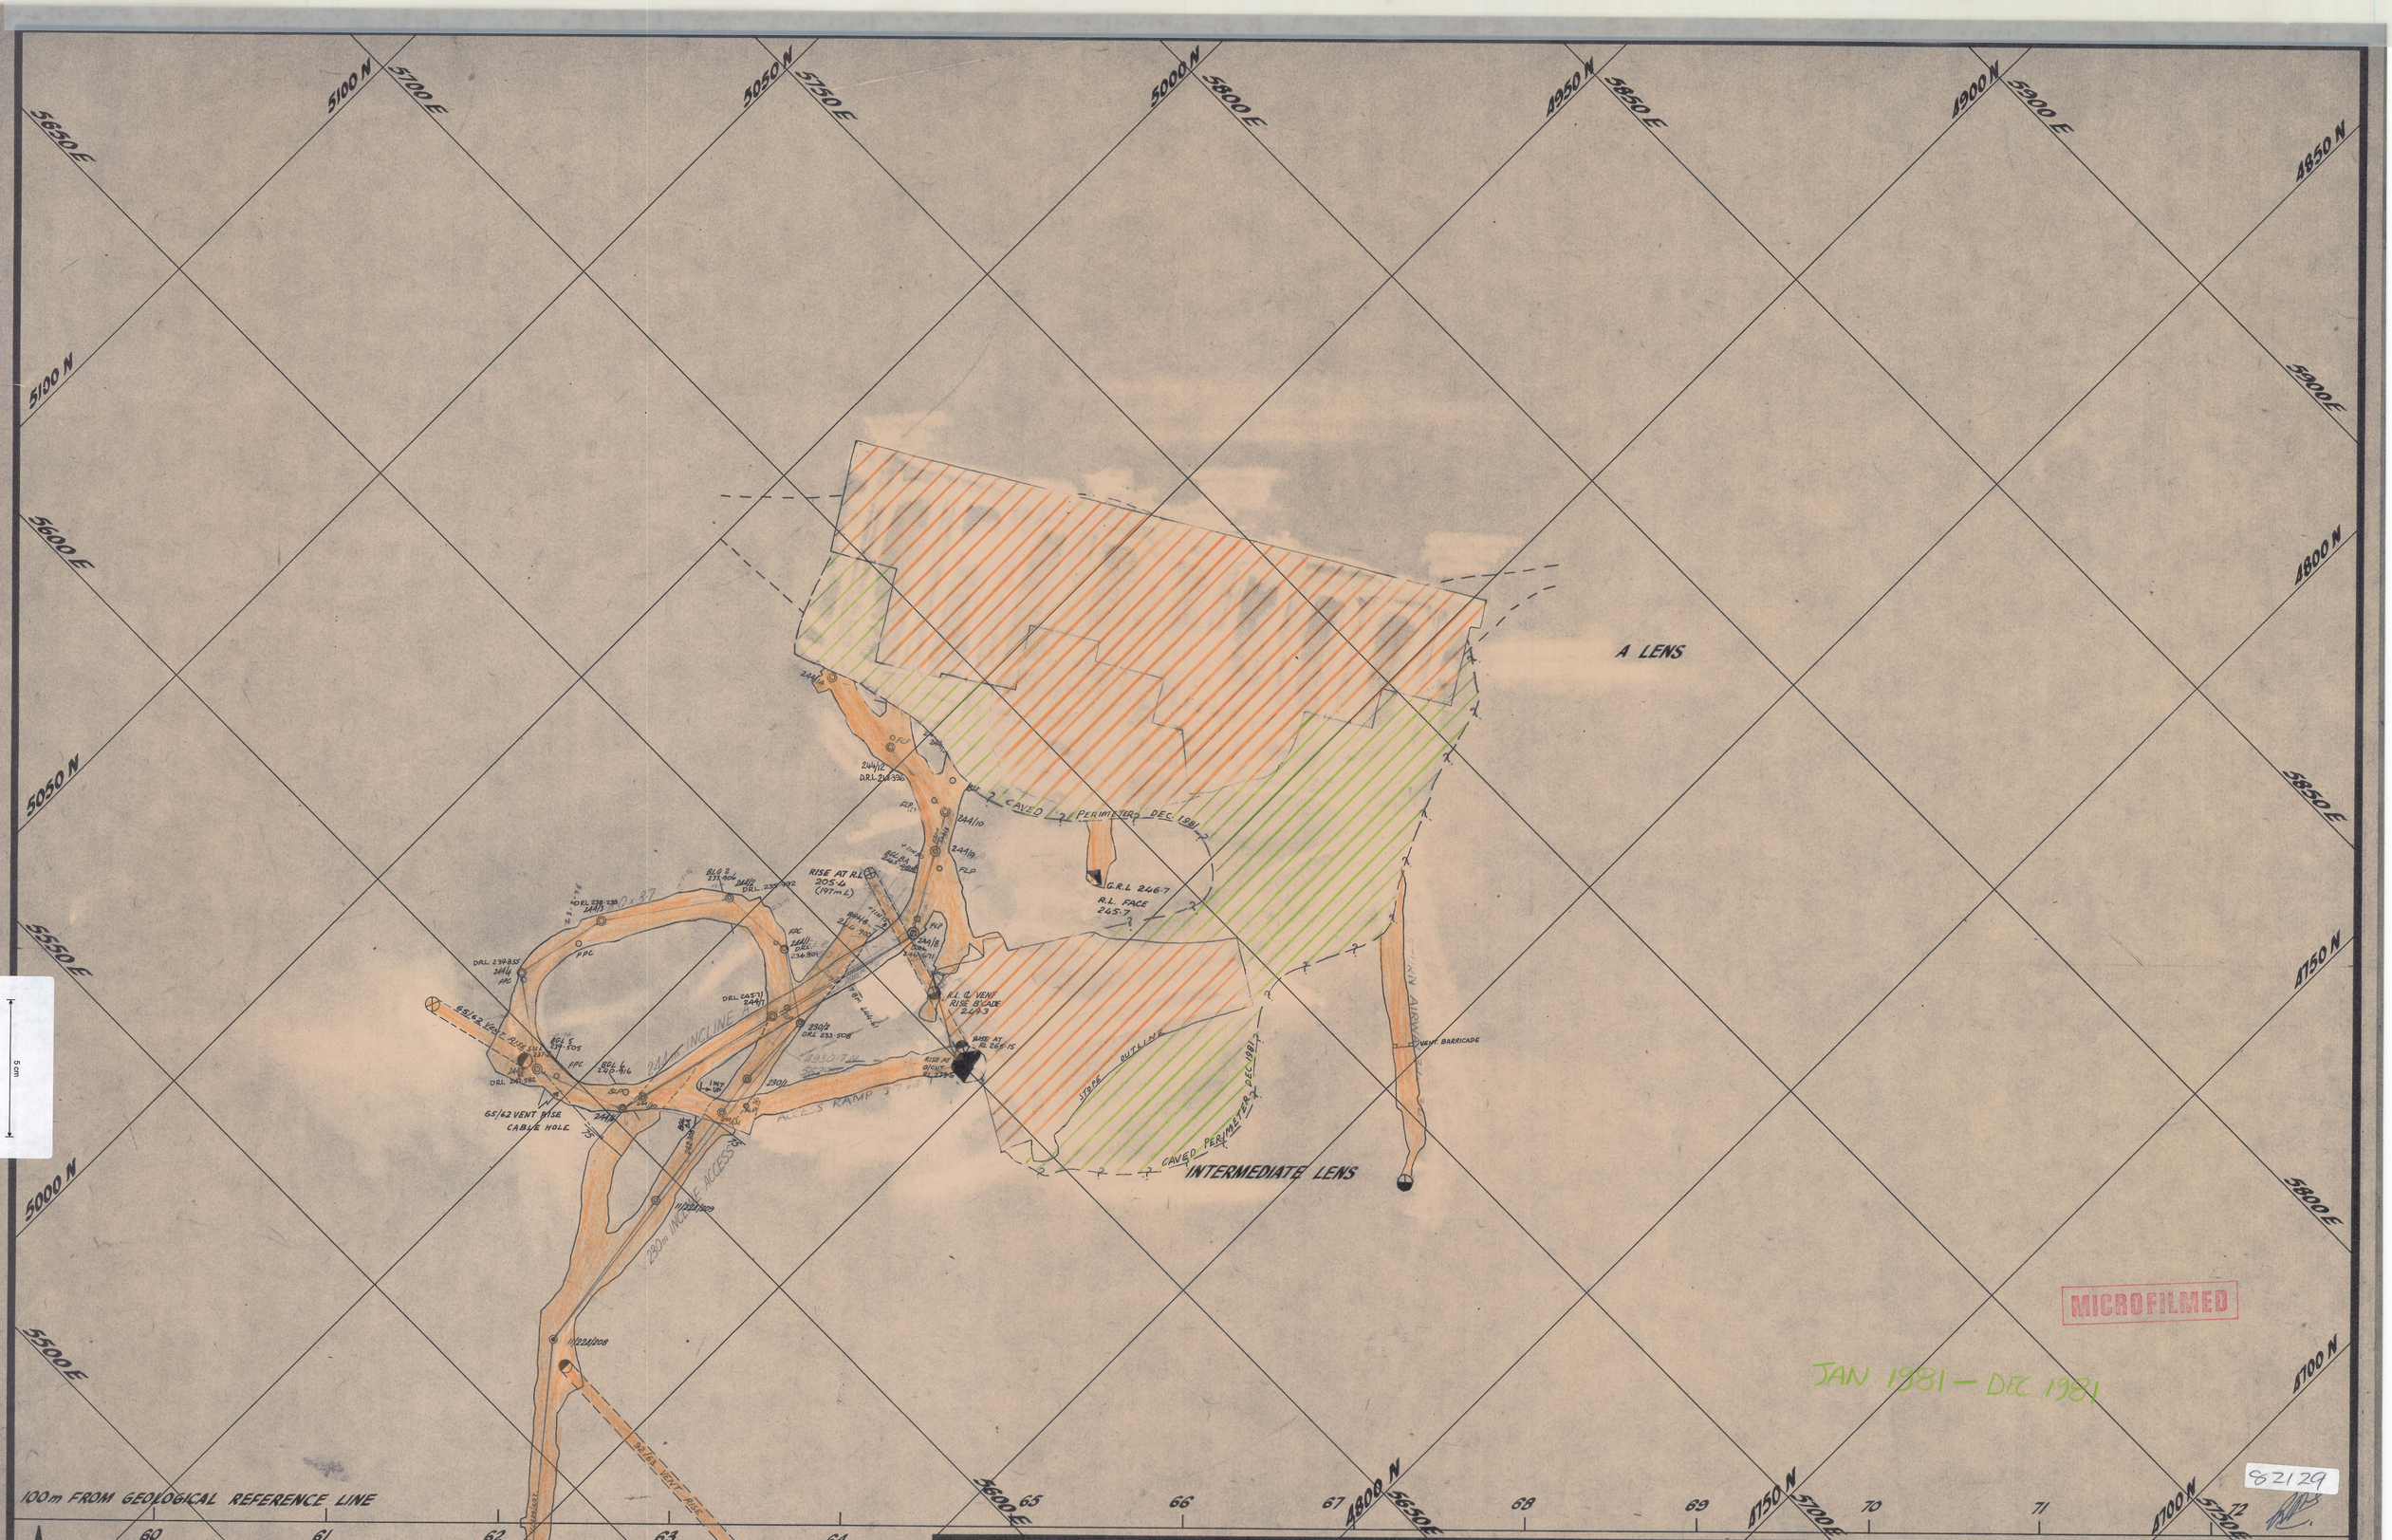

MICROFILMED

JAN 1981 — DEC 1981

82129

Nº	DATE	APPD	AMENDMENT
1	15-3-76		SLOT X-CUT AMENDED PA3-248
2	24-3-76		RETURN AIRWAY AMENDED PA3-251
3	17-6-76		ALTERATION to 244 230 m ACCESSES & PASS
4	27-7-76		ALTERATION TO DRAINAGE DRIVE TO RISE PA3-310
5	6-12-76		ALTERATION - INTERMEDIATE LENS 244 m DR. HORIZONTAL PA3-350

MOUNT LYELL M. & R. CO. LTD.
MINE DEPARTMENT

P.L.M. - 244 m LEVEL
A LENS & INTERMEDIATE LENS
AND "A" LENS INCLINE

SCALE: 1:500	SURVEYED:	APPROVED	DRAWING Nº
DATE: 24-2-1976	DESIGNED:	U/G MGR:	PAI-218
	DRAWN:	C/M ENG:	
	TRACED:	C/SURVR:	SHEET Nº
	CHECKED:	C/GEOL:	
	CHECKED:	MINE SUPT:	INDEXED DRAWER Nº