



0381-017

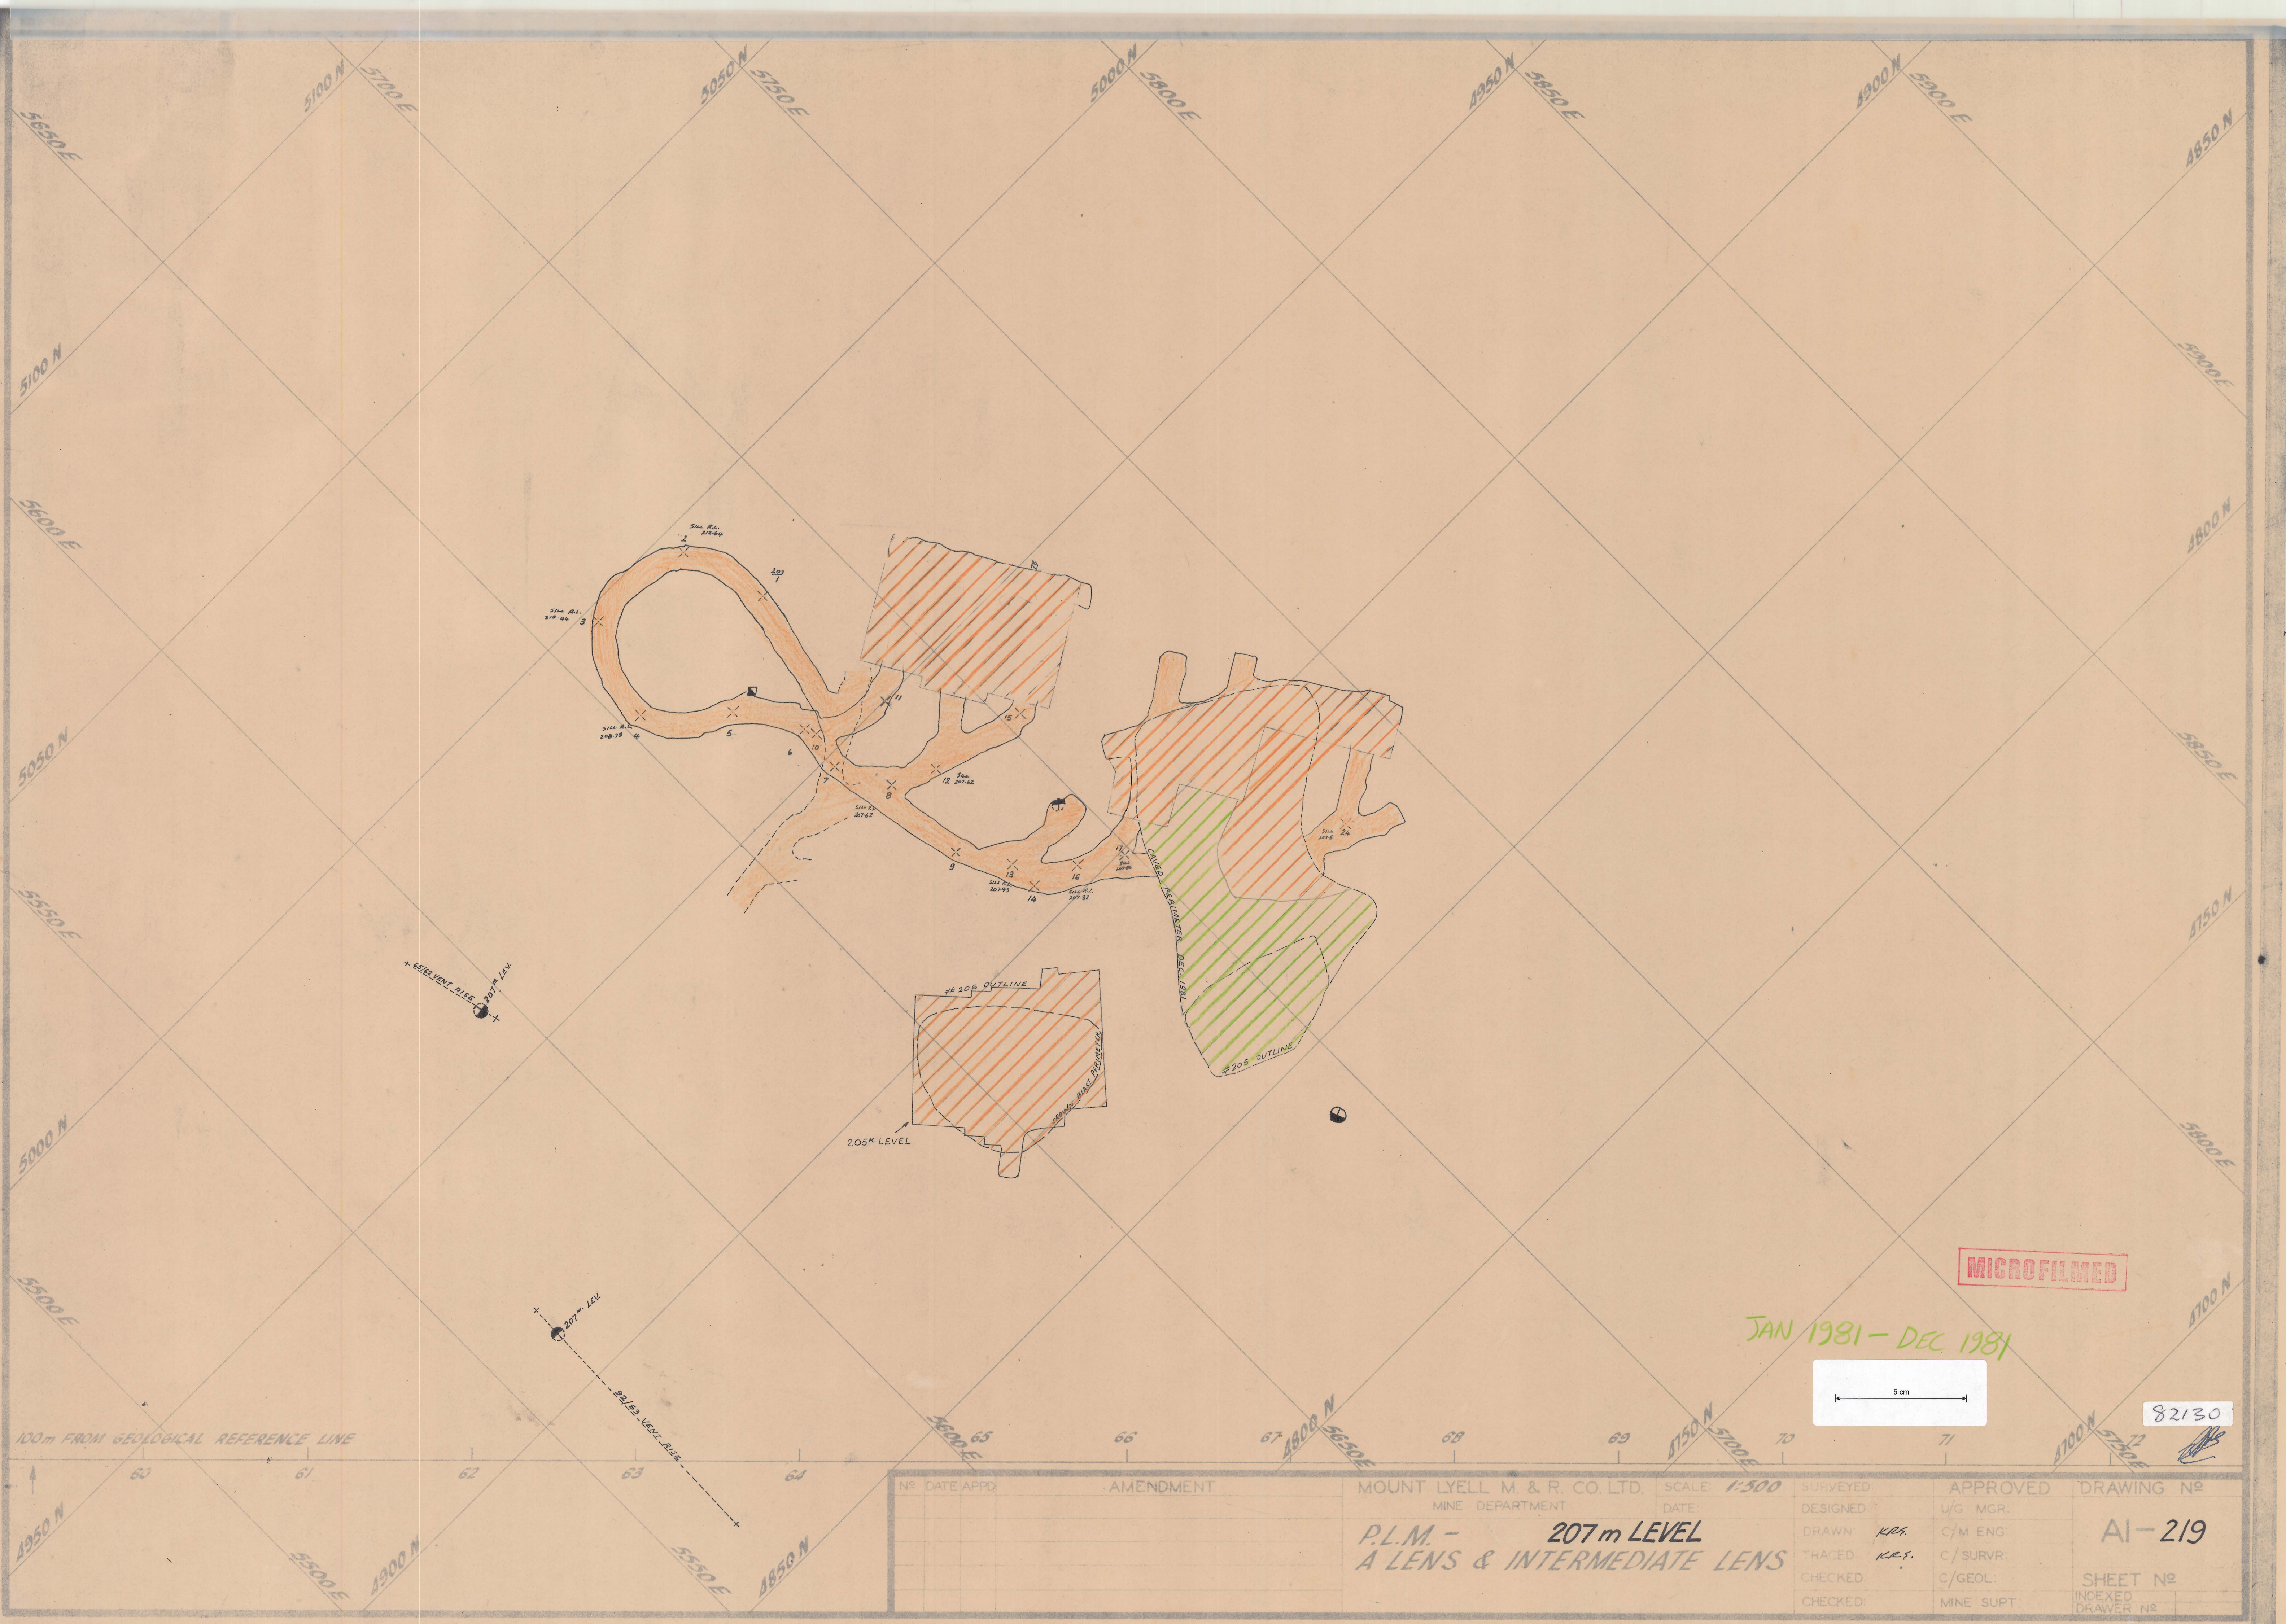

100m FROM GEOLOGICAL REFERENCE LINE

MICROFILMED

JAN 1981 - DEC 1981

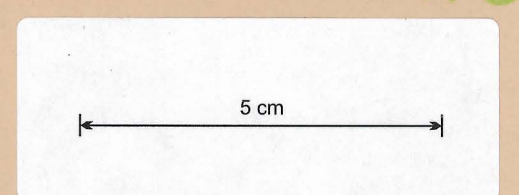

82130

No		DATE APPD	AMENDMENT	MOUNT LYELL M. & R. CO. LTD.		SCALE	1:500	SURVEYED	APPROVED	DRAWING No
				MINE DEPARTMENT		DATE		DESIGNED	U/G MGR.	
				P.L.M. -				DRAWN	C/M ENG	AI-219
				A LENS & INTERMEDIATE LENS				TRACED	C/SURVR	
								CHECKED	C/GEOL	SHEET No
								CHECKED	MINE SUPT	INDEXED
										DRAWER No